
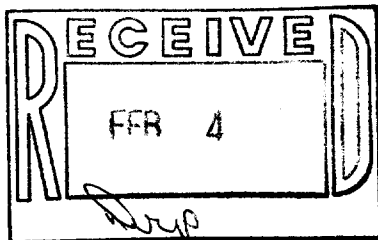


WALWORTH COUNTY
SURVEYING & MAPPING
LAKE GENEVA, WISCONSIN

MENOMINEE ROAD

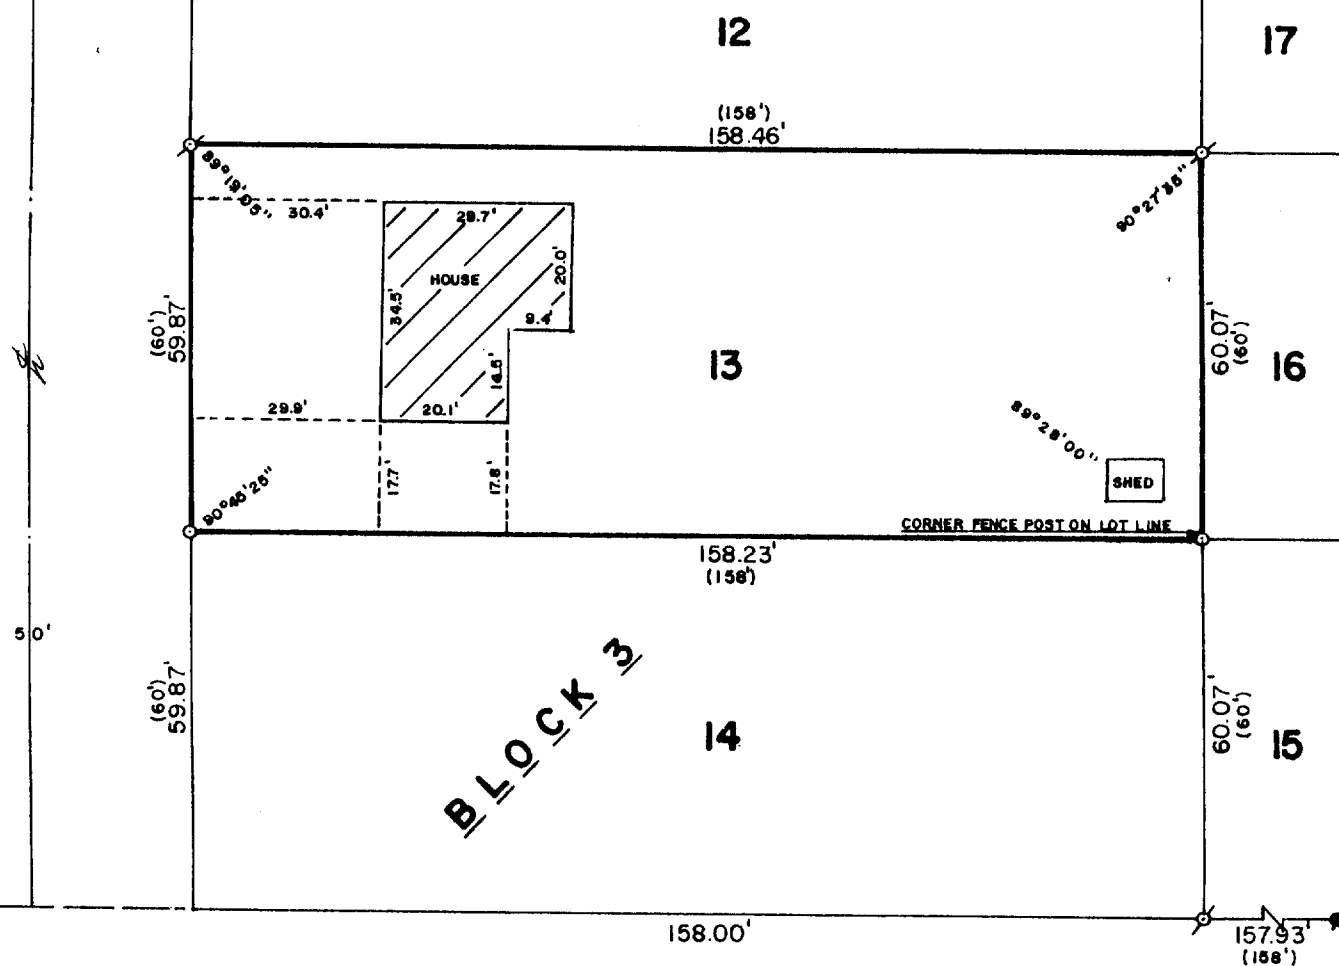

PLAT OF SURVEY OF

LOT 13, BLOCK 3 OF HARBOR VIEW SUB-DIVISION, LOCATED IN THE VILLAGE OF WILLIAMS BAY, WALWORTH COUNTY, WISCONSIN.

ORDERED BY: RAY KNOLLVIEW REALTY
RT. 2, BOX 140-8
LAKE GENEVA, WISCONSIN 53147

NOTE: PROPERTY IS FENCED ON ALL FOUR SIDES. THE WIRE FENCE FALLS WITHIN THE LOT BOUNDARIES EXCEPT AS NOTED.



SCALE: 1"=30'

- ⌀ - IRON PIPE FOUND
- - CONCRETE MONUMENT FOUND
- - IRON ROD PLACED
- () - RECORDED AS

I, ROBERT M. BAERENWALD, DO HEREBY CERTIFY THAT I HAVE SURVEYED THE PROPERTY HEREON DESCRIBED ACCORDING TO THE OFFICIAL RECORDS AND THAT THE PLAT HEREON IS A CORRECT REPRESENTATION OF THE PROPERTY LINES TO THE BEST OF MY KNOWLEDGE AND BELIEF.

Robert M. Baerenwald
ROBERT M. BAERENWALD
WISCONSIN REGISTERED LAND SURVEYOR, S-1508

Sept. 28, 1986
DATE JOB NO. 0742

NOTE: THIS IS NOT A CERTIFIED COPY UNLESS SEALED.

W4U-43

11-529