


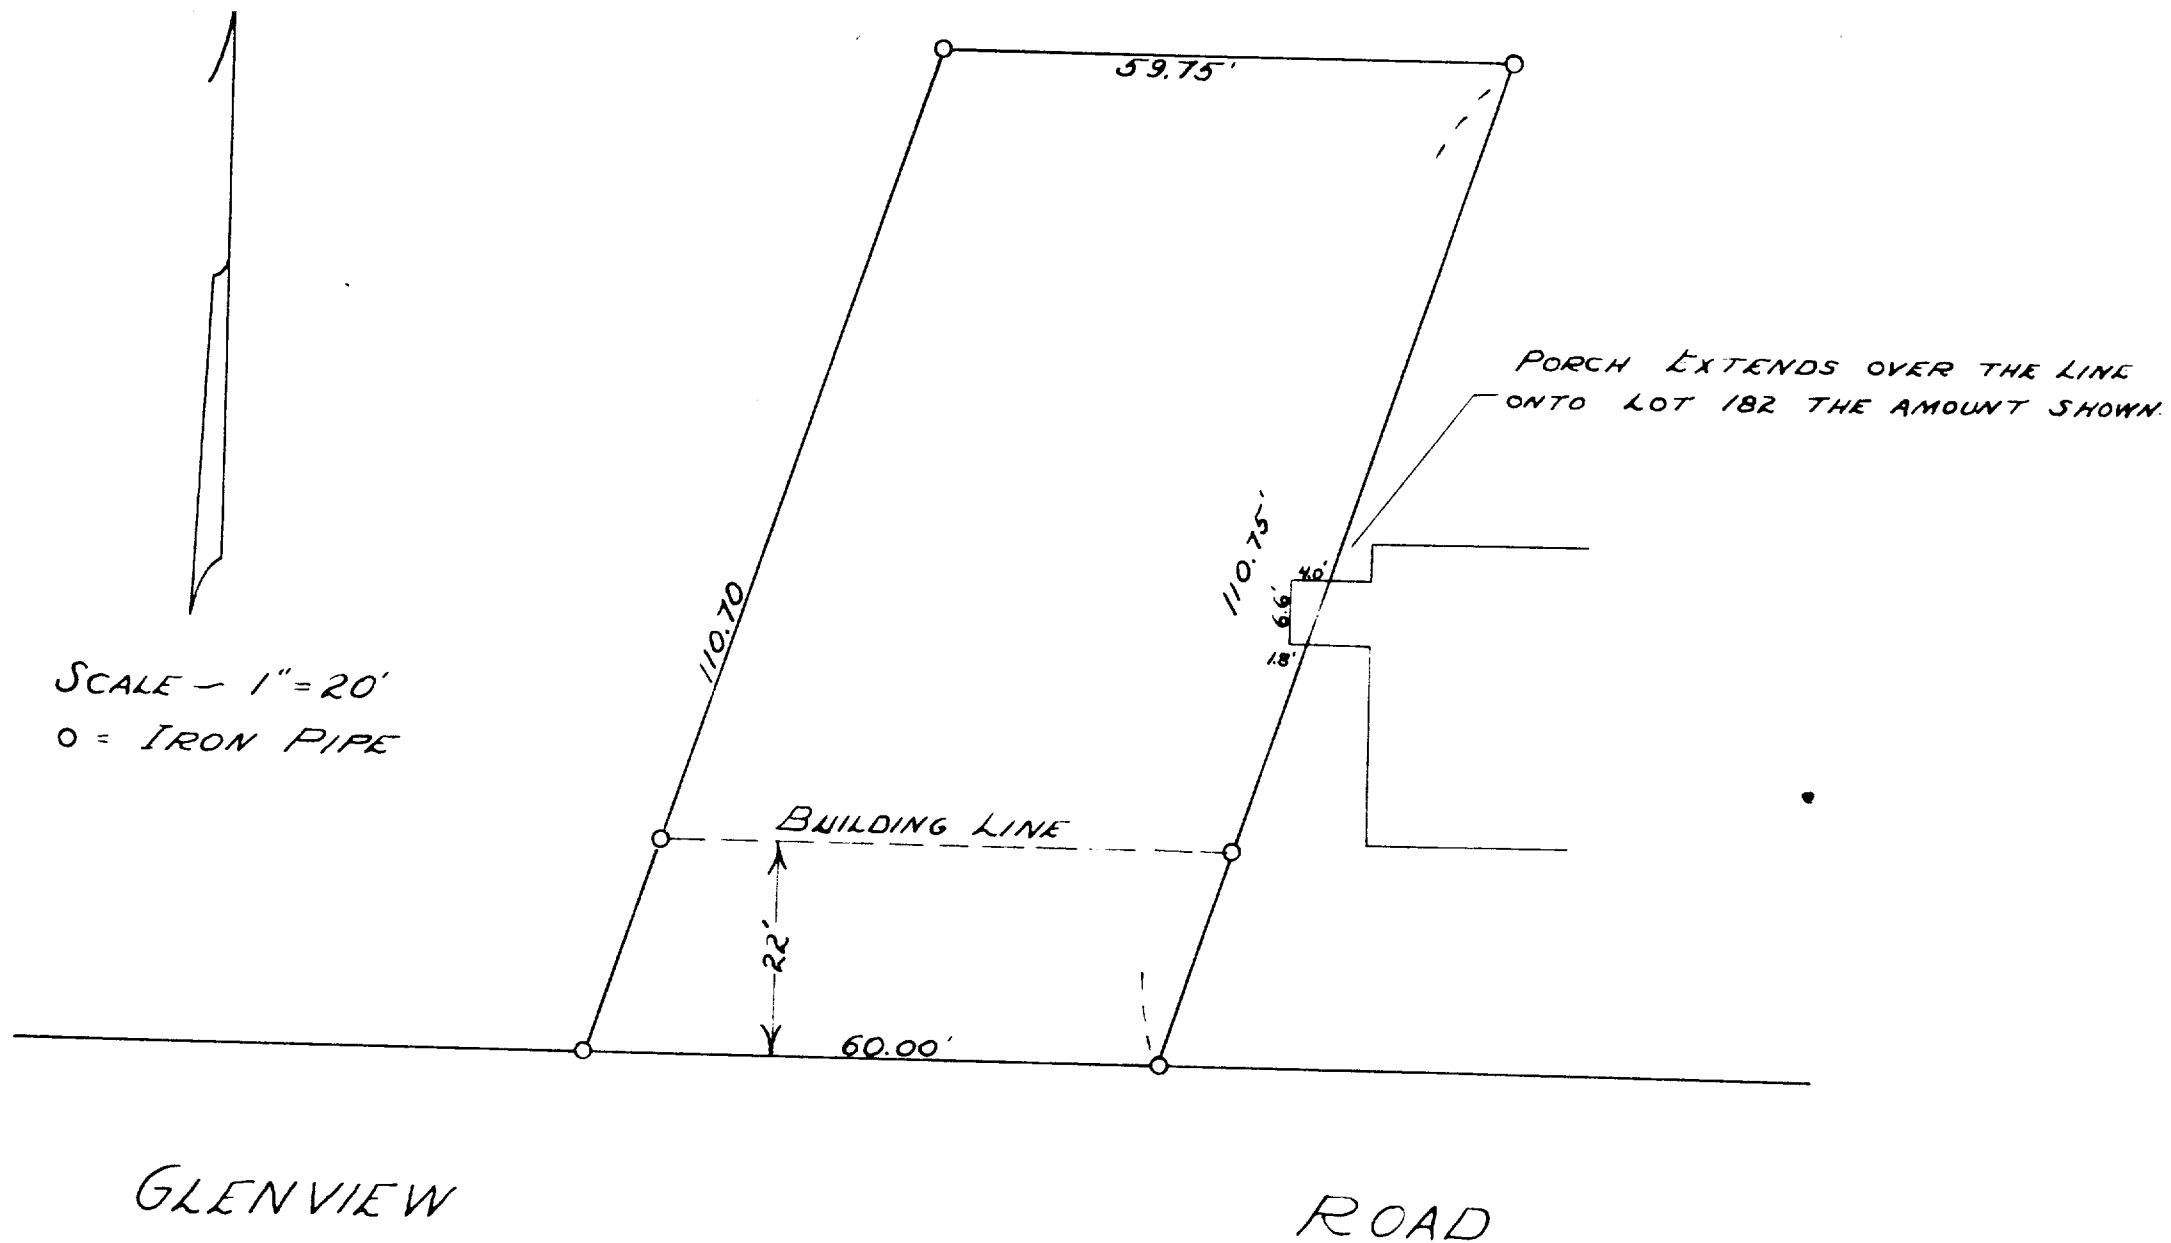

PLAT of SURVEY
LOT 182 CEDAR POINT PARK, 2ND ADDITION,
VILLAGE OF WILLIAMS BAY, WALWORTH COUNTY,
WISCONSIN.

AUGUST 1948

11-52 J