
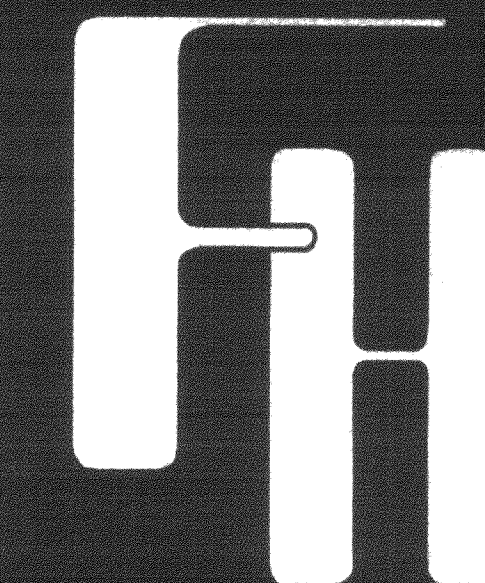


[illegible]

SETBACKS 3' YARDS SHOWN ACCORDING TO OUR
COPY OF WILLIAMS BAY ZONING ORD. CIRCA 1978
VERIFY THESE STILL IN EFFECT BEFORE
RELYING UPON THIS INFORMATION

STREET SEBACK 30' MIN. PER CAG. SUB. PLAT
SIDE YARD MIN 10' ONE SIDE MIN 30' SUM OF SIDES
HEARYARD 30' MIN. OPEN TO DIF. INTERP. ON
CORNER LOTS CONFIRM OUR INTERP. WITH BUDS. INSPE.

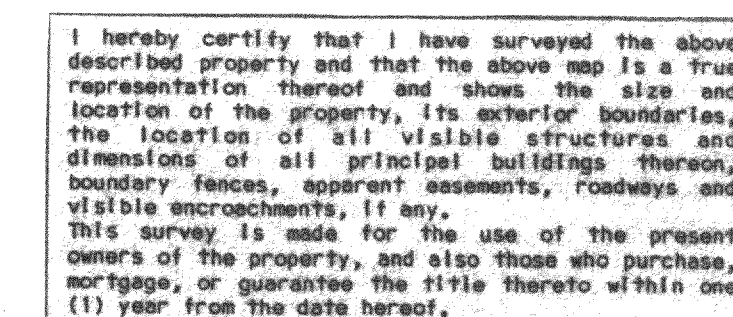

Robert R. Tamm

DATED: FEB 2ND, 1987

PLAT OF SURVEY

LOT 67 WILLABAY WOODS SUBDIVISION
IN THE VILLAGE OF WILLIAMS BAY,
WALWORTH COUNTY WISCONSIN
WORK ORDERED BY MIDWEST REALTY

DATE	DRAWN BY	REVISIONS	BY	DATE	PROJECT NO.
12/2/86	RF	FIELD MEAS.	DL	1/27/87	2101
SCALE	CHECKED BY	UPGRADE TO PLAT OF SVY	RF	2/11/87	LAST REVISION
1"=10'					2/11/87
	APPROVED BY				SHEET NO.