
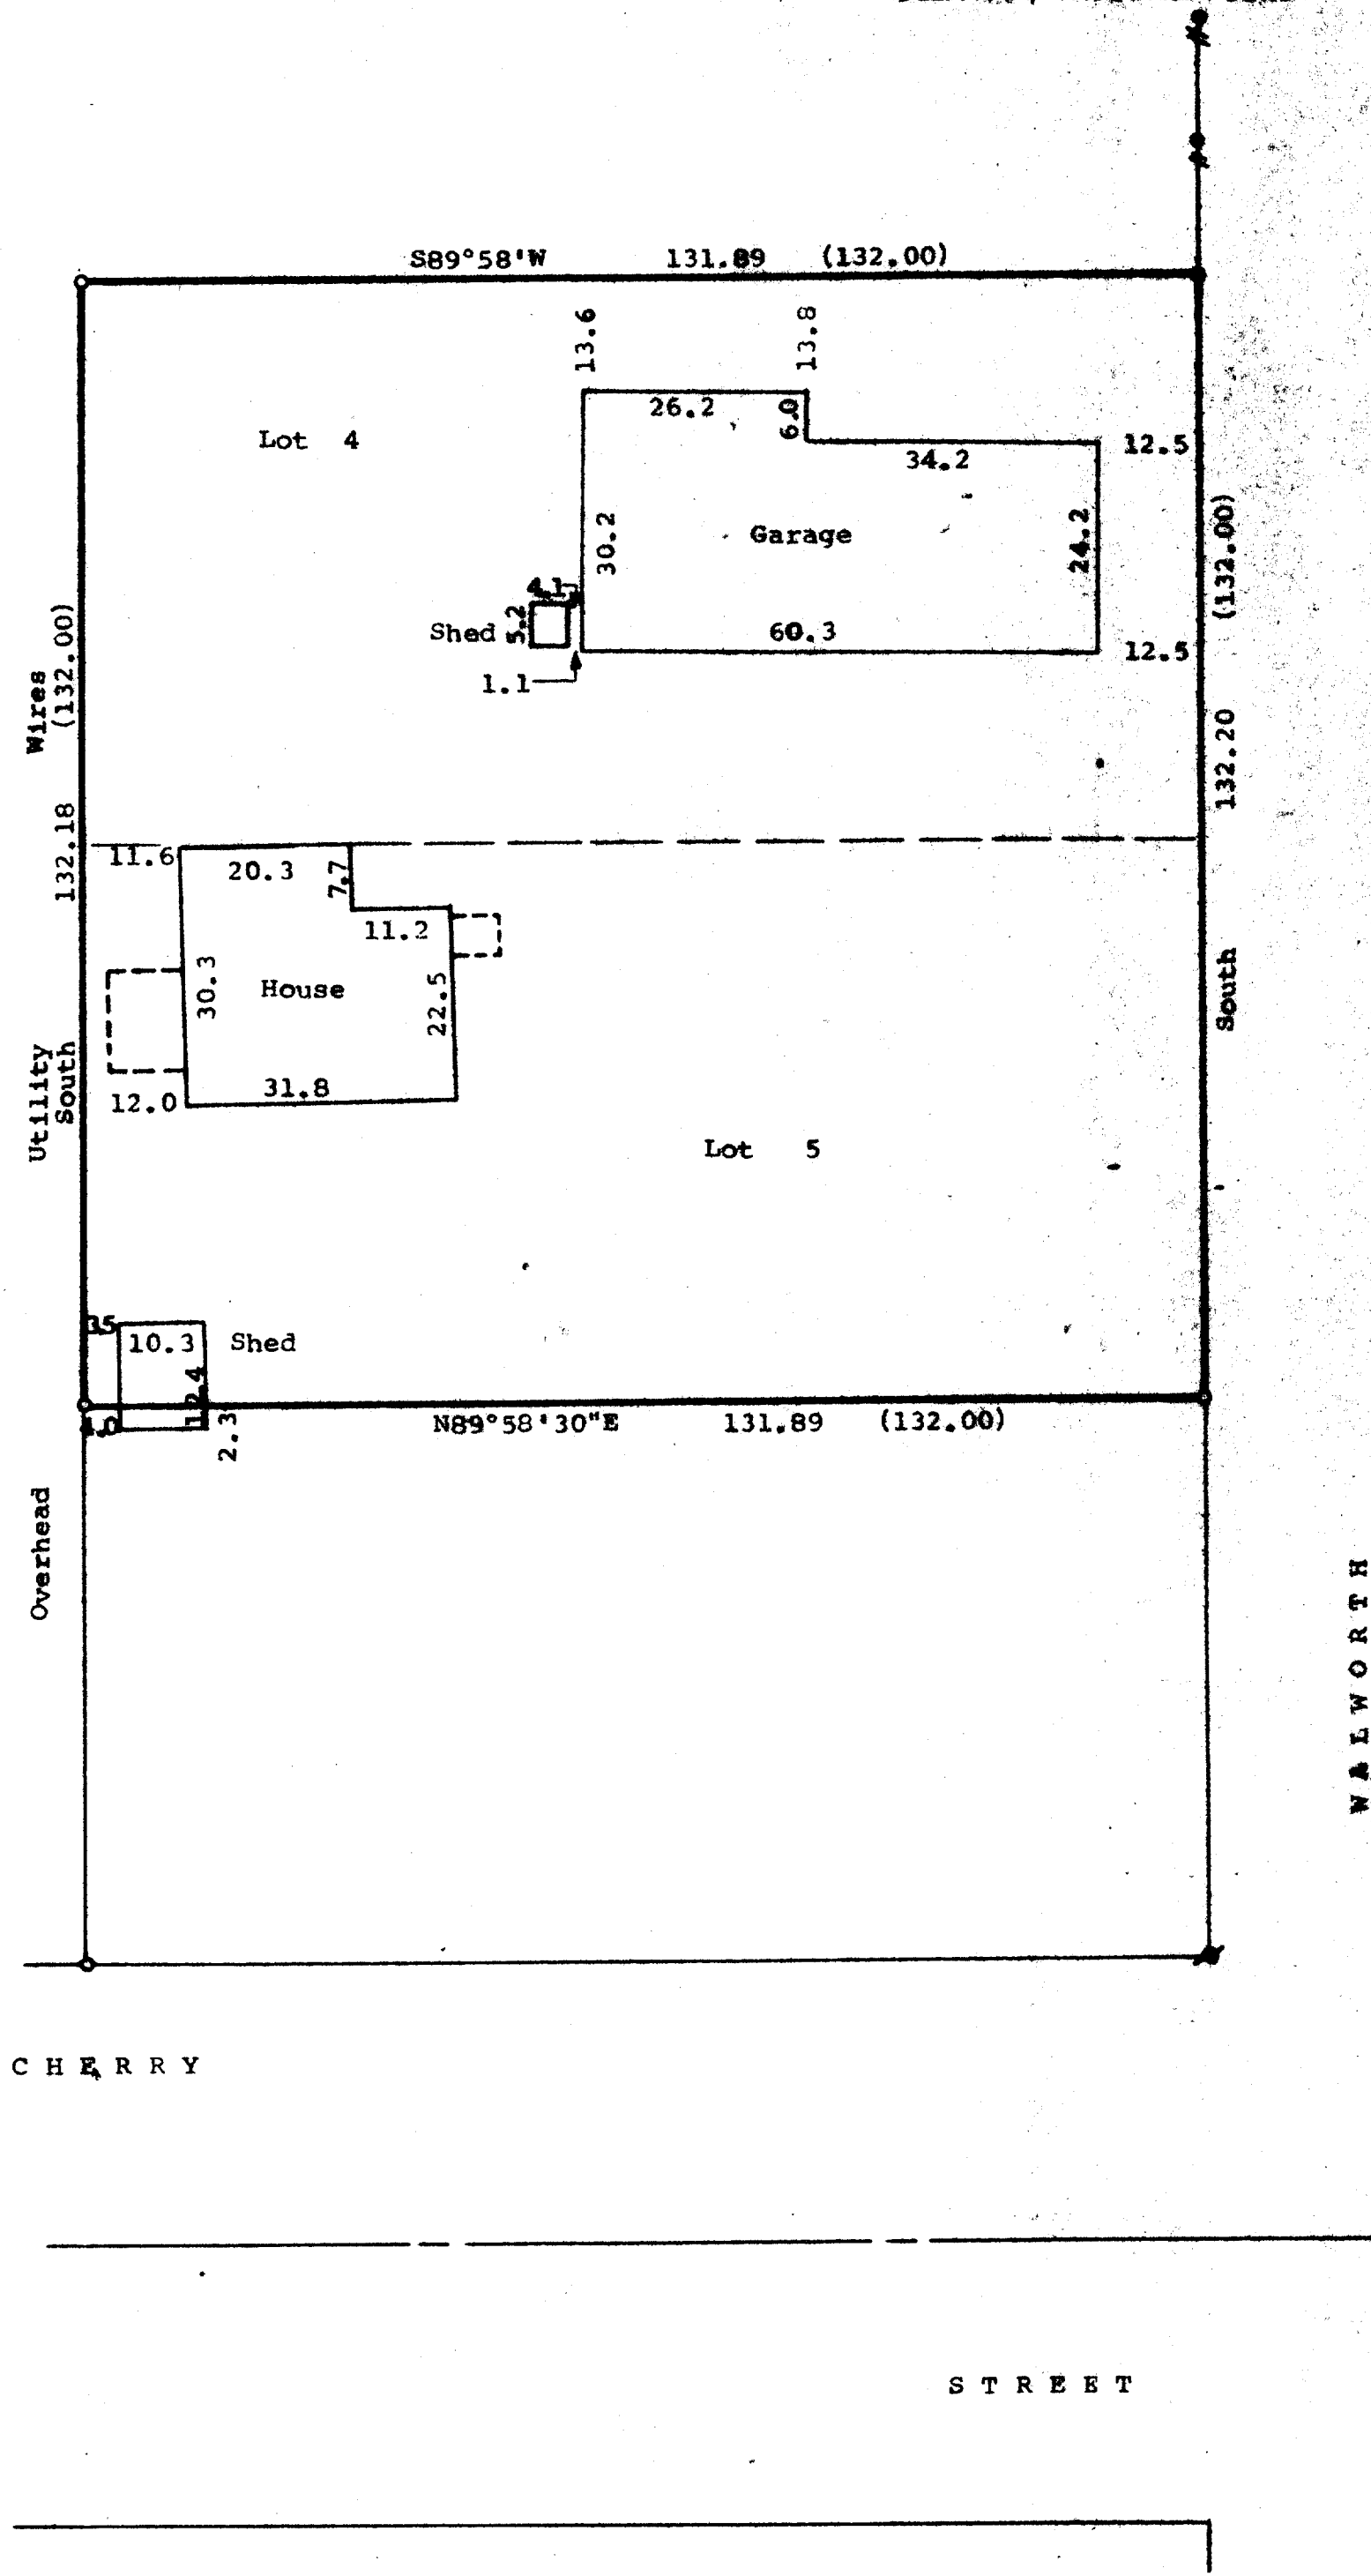


DUNHAM SURVEYING, S.C.
SURVEYING & SUBDIVIDING
DELAVER, WISCONSIN 53115

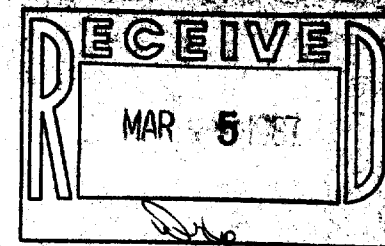

Scale - 1" = 20'
 ● = 1" Dia. Iron Pipe Found
 ○ = 1"x24" Iron Pipe Set
 / = 1 1/4"x24" Iron Pipe Set
 (00.00) = Recorded Distance

Bearings are referenced to the
West line of Walworth Avenue,
assumed bearing of South.

Owner: Wilbur Johnson
 18 Cherry Street
 Williams Bay, WI 53191

STATE OF WISCONSIN)
 COUNTY OF WALWORTH) ss

I, George T. Dunham, Surveyor, certify that I have surveyed
 the property described as follows,

Lots 4 and 5 of Block 2 of the Original Plat of the Village
 of Williams Bay, Walworth County, Wisconsin.

and that the map shown hereon is a correct representation thereof
 and shows the size and location of the property, its exterior boundaries,
 the location of all visible structures and dimensions of all principal
 buildings thereon, boundary fences, apparent easements, roadways and
 visible encroachments, if any, and that I have surveyed the property
 hereon described according to the official records, to the best of
 my knowledge and belief.

October 13, 1986.

George T. Dunham
 George T. Dunham, Surveyor

