


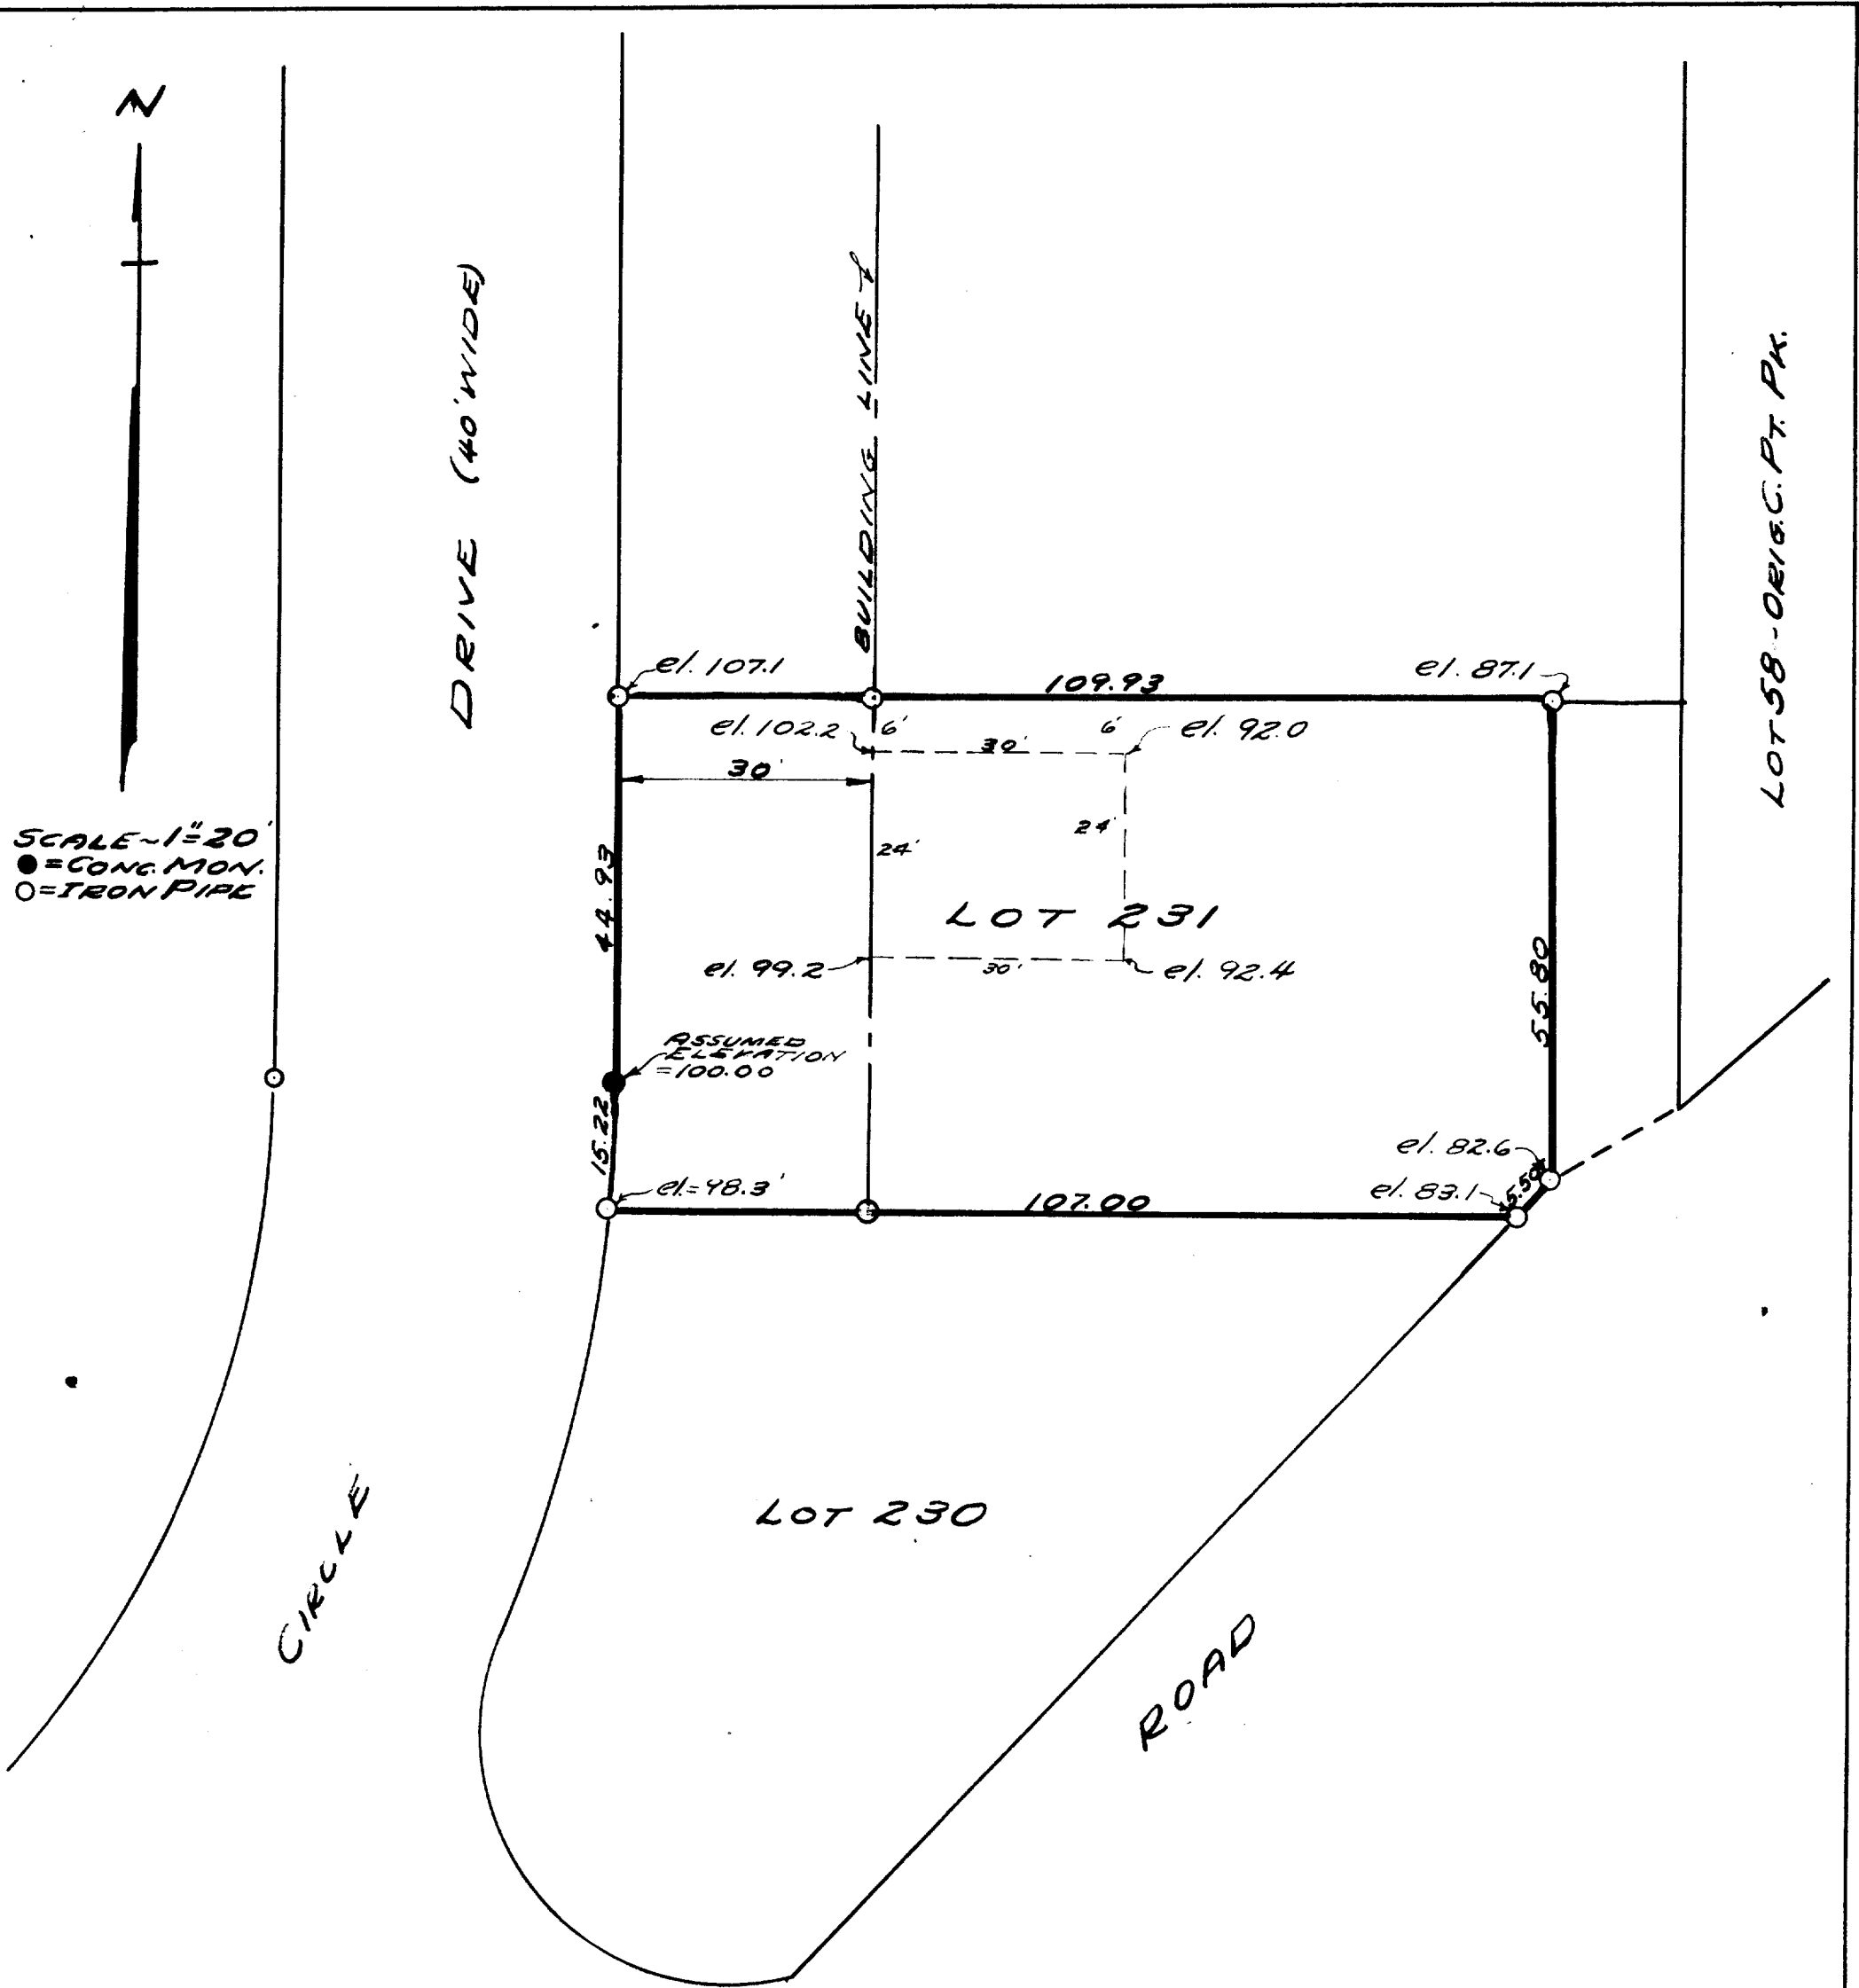

I HEREBY CERTIFY THAT I HAVE SURVEYED LOT 231 OF THE THIRD ADDITION TO CEDAR POINT PARK SUBDIVISION, WILLIAMS BAY, WISCONSIN, AND THAT THE ABOVE PLAT IS A CORRECT REPRESENTATION THEREOF.

AUGUST, 1948

H. E. Johnson
SURVEYOR

11-53