


GEORGE T. DUNHAM
SURVEYING & SUBDIVIDING
DELAVER, WISCONSIN

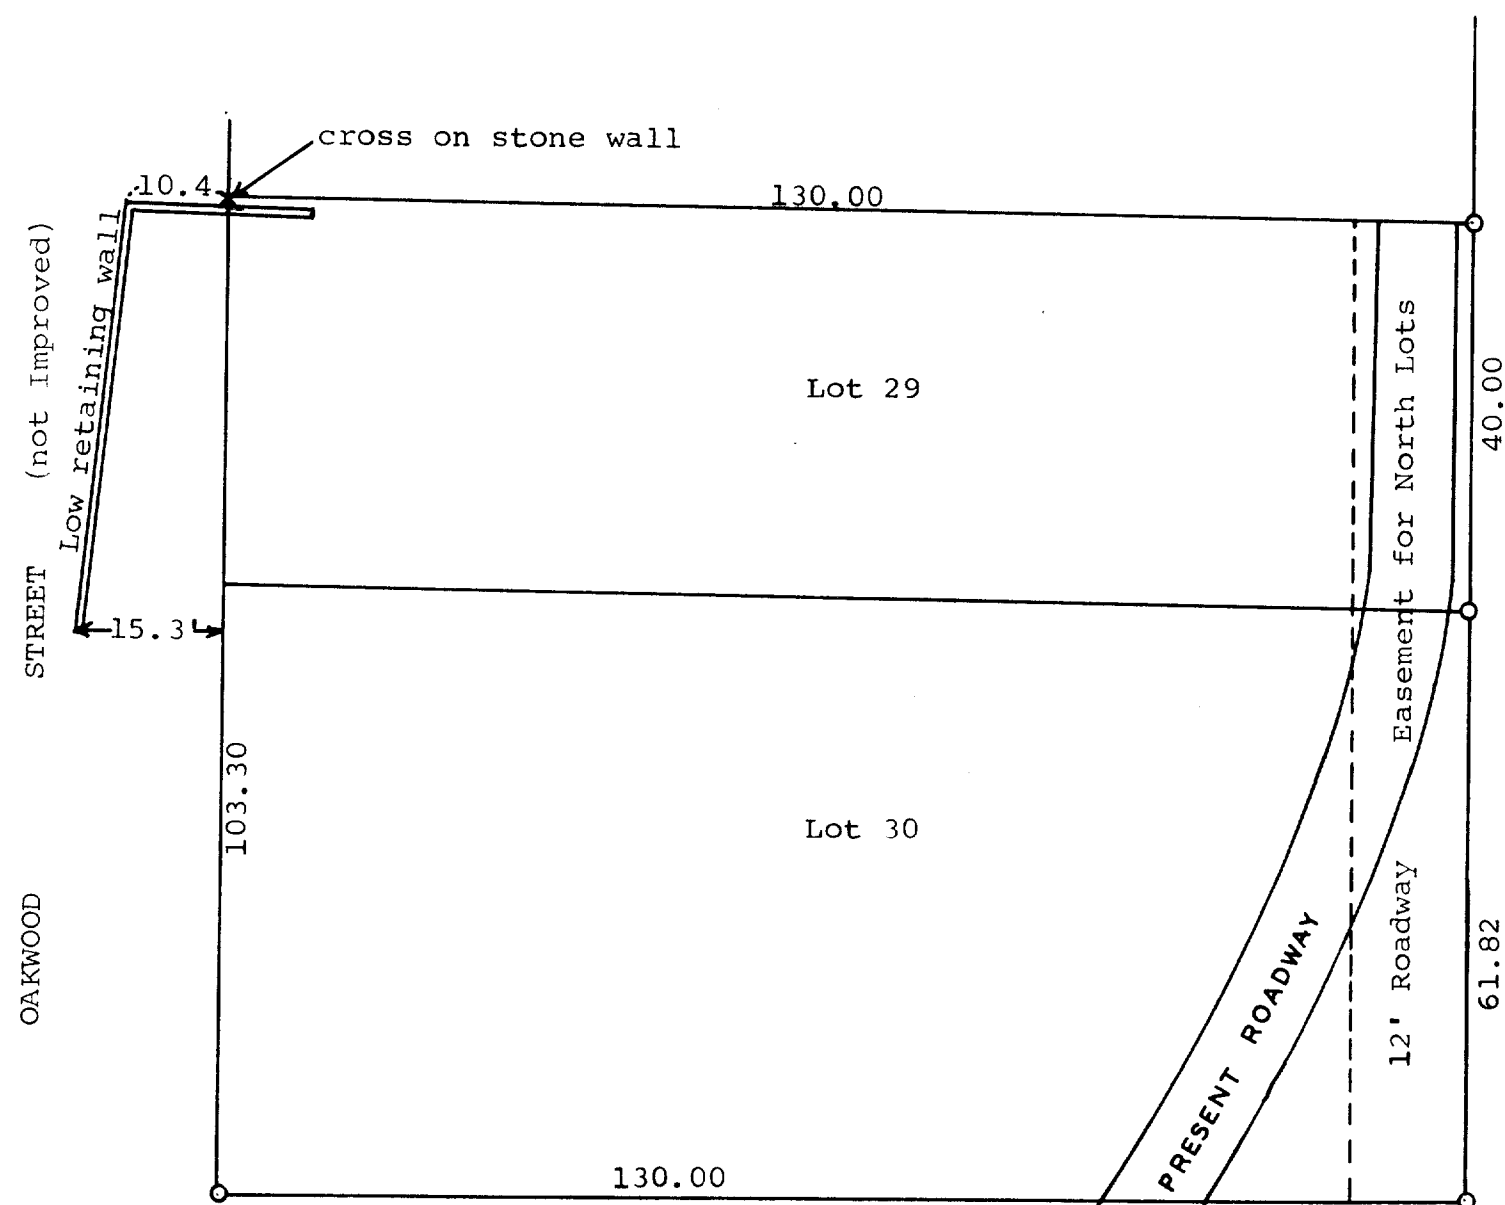

Easement also includes
the SE Corner of Lot 30 between
Wesley Street & Reservoir (?)

Scale - 1" = 20'
O = Iron Pipe

STATE OF WISCONSIN)
WALWORTH COUNTY) SS

I, George T. Dunham, Surveyor, certify that I have
surveyed the property described as follows,
Lots 29 & 30 in Carlson's Addition to Williams Bay,
Walworth County, Wisconsin.

and that the above plat is an accurate survey and a true representation
of said lots and correctly shows the exterior boundary lines
of said lots and the correct measurements thereof.

May 22, 1969

George T. Dunham
George T. Dunham, Surveyor

WCA-16

11-54