


**WALWORTH COUNTY
SURVEYING & MAPPING
LAKE GENEVA, WISCONSIN**

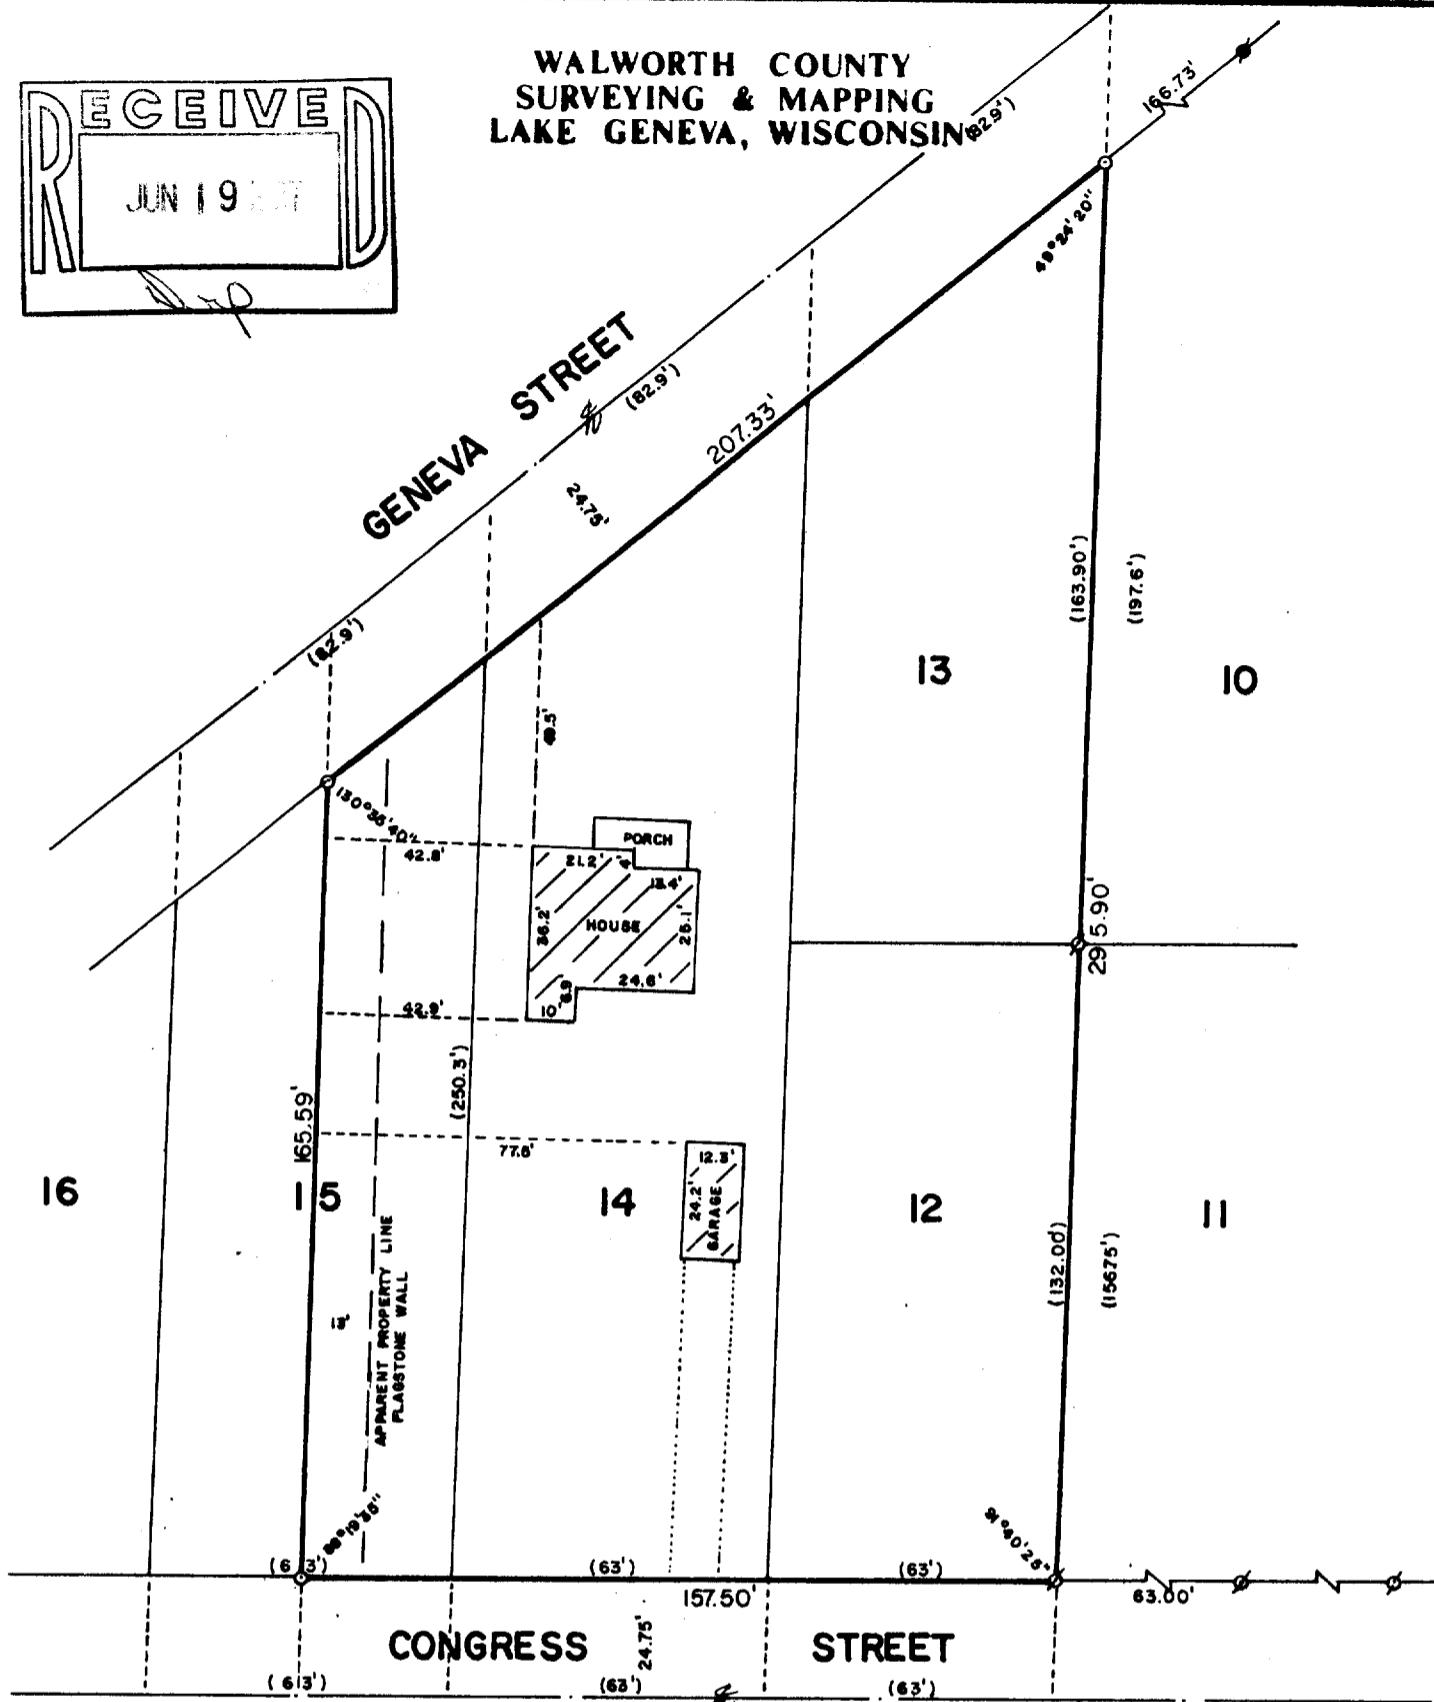

PLAT OF SURVEY OF

LOTS 12, 13, 14 AND THE EAST 1/2 OF LOT
15 OF MADISON'S ADDITION TO THE VILLAGE
OF WILLIAMS BAY, WALWORTH COUNTY, WISCONSIN.

ORDERED BY: FRANCIS L. MCGUCKIN
155 GENEVA STREET
WILLIAMS BAY, WISCONSIN 53191

REVISED: MAY 7, 1987

I, ROBERT M. BAERENWALD, DO HEREBY CERTIFY THAT I HAVE SURVEYED THE PROPERTY HEREON DESCRIBED ACCORDING TO THE OFFICIAL RECORDS AND THAT THE PLAT HEREON IS A CORRECT REPRESENTATION OF THE PROPERTY LINES TO THE BEST OF MY KNOWLEDGE AND BELIEF.

SCALE: 1"=40'

- ø - IRON PIPE FOUND
- ø - IRON ROD FOUND
- ø - CONCRETE MONUMENT FOUND
- () - RECORDED AS

Robert M. Baerenwald
ROBERT M. BAERENWALD
WISCONSIN REGISTERED LAND SURVEYOR. S-1508

May 1, 1887

~~May 11, 1961~~ DATE JOB NO. 0923

NOTE: THIS IS NOT A CERTIFIED COPY UNLESS SEALED.