


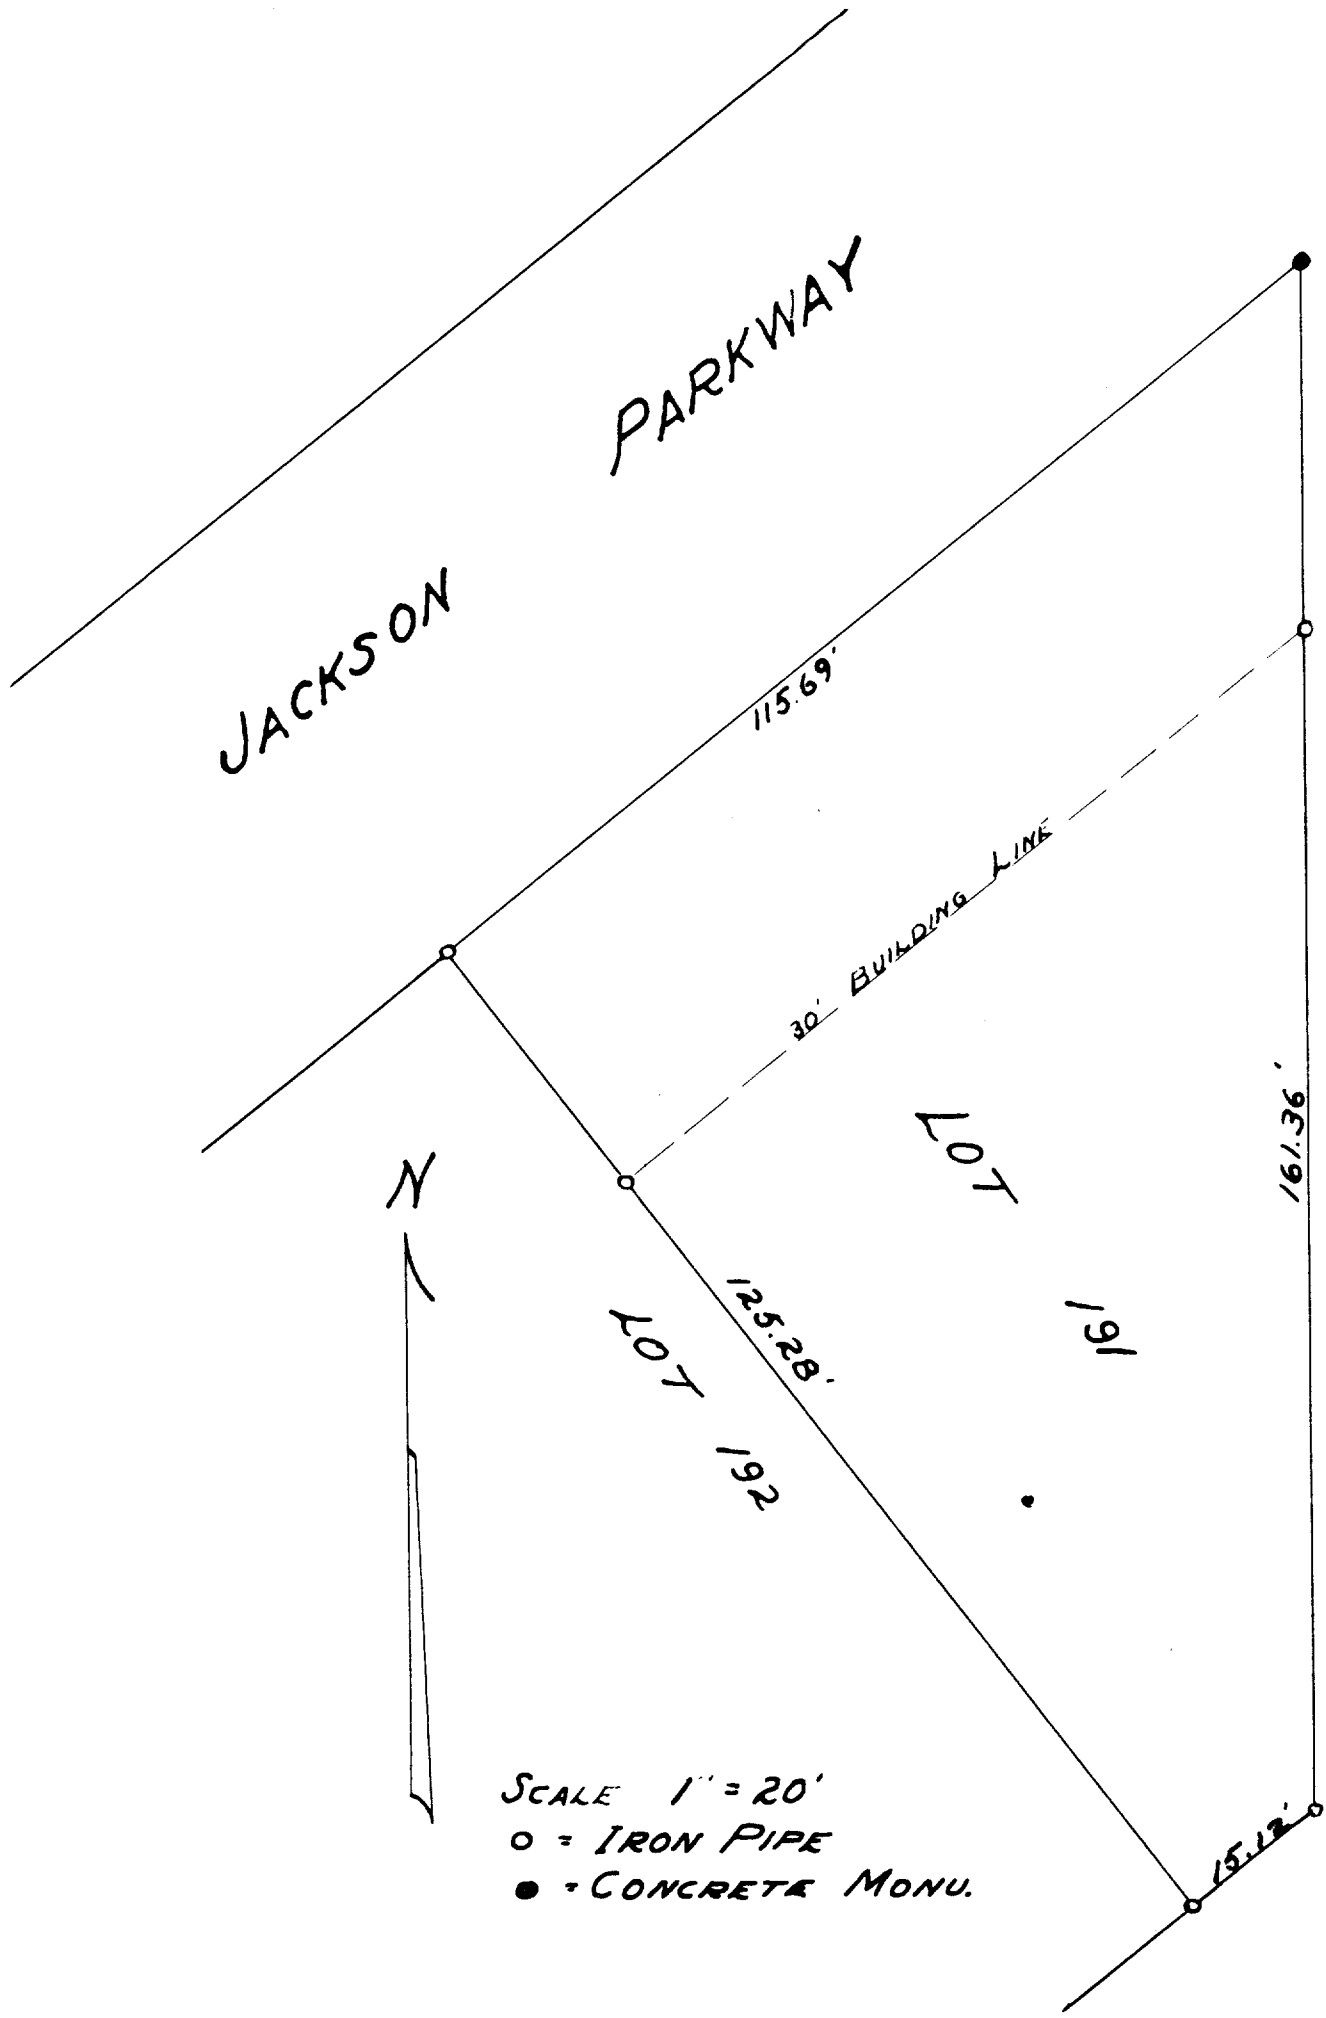

PLAT of SURVEY

LOT 191 CEDAR POINT PARK ORIGINAL,
 WILLIAMS BAY, WALWORTH COUNTY, WISCONSIN.
 JUNE 5, 1948

Lloyd L. Jensen
 COUNTY SURVEYOR

11-56
 95-11-56