


119/72

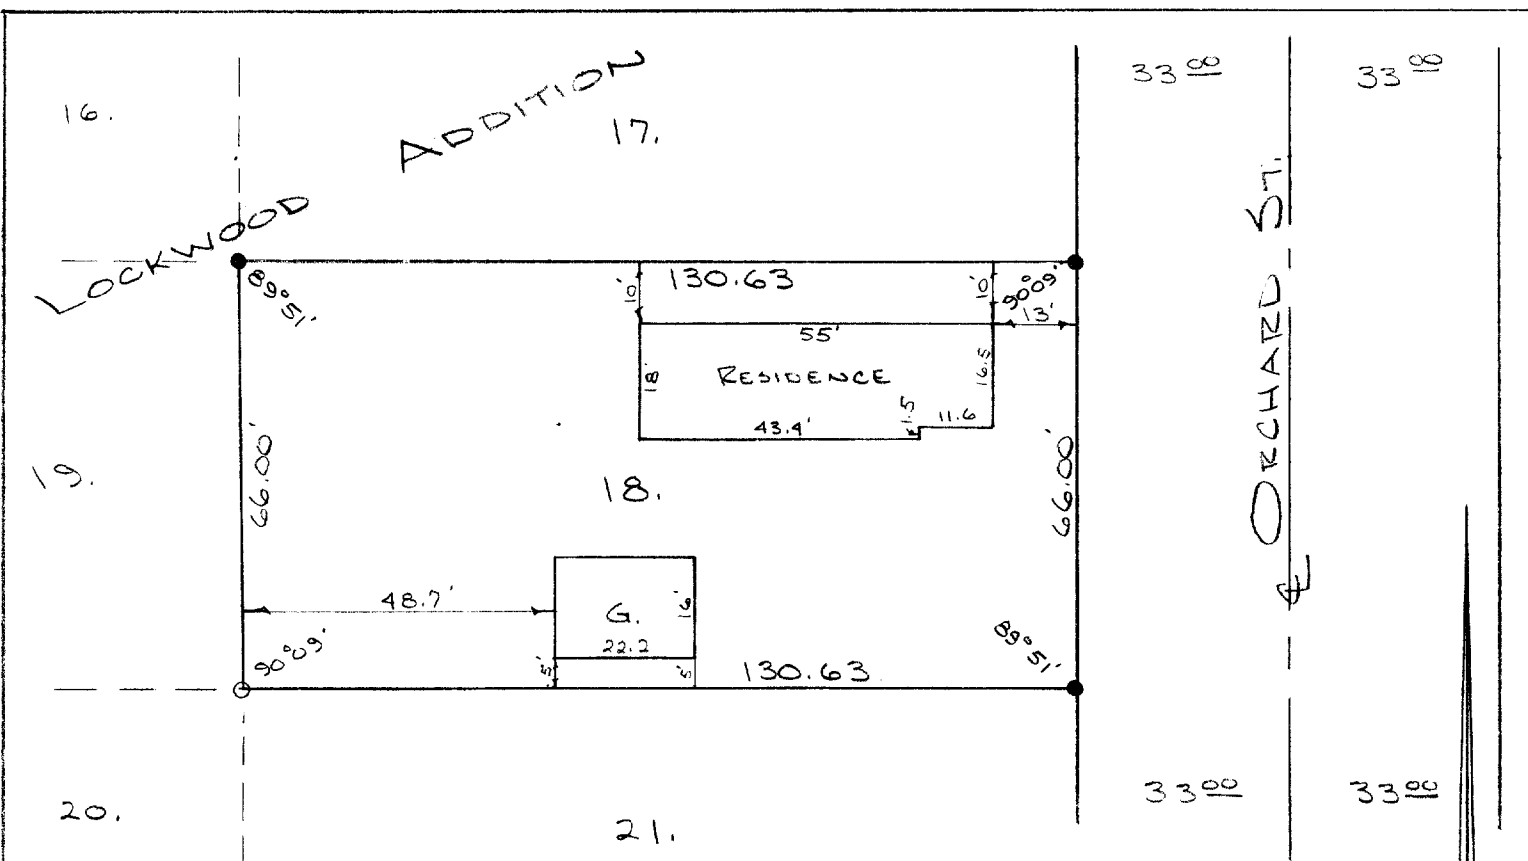

LEGEND:

- - INDICATES IRON PIPE FOUND
- - INDICATES IRON PIPE SET

DESCRIPTION:

Lot number Eighteen (18) Lockwood Addition, Village of Williams Bay, Walworth County, Wisconsin.

CERTIFICATE:

I, James F. Biagi, surveyor, do hereby certify that I have surveyed the lands hereon described.

September 27, 1972

James F. Biagi RLS #272

