


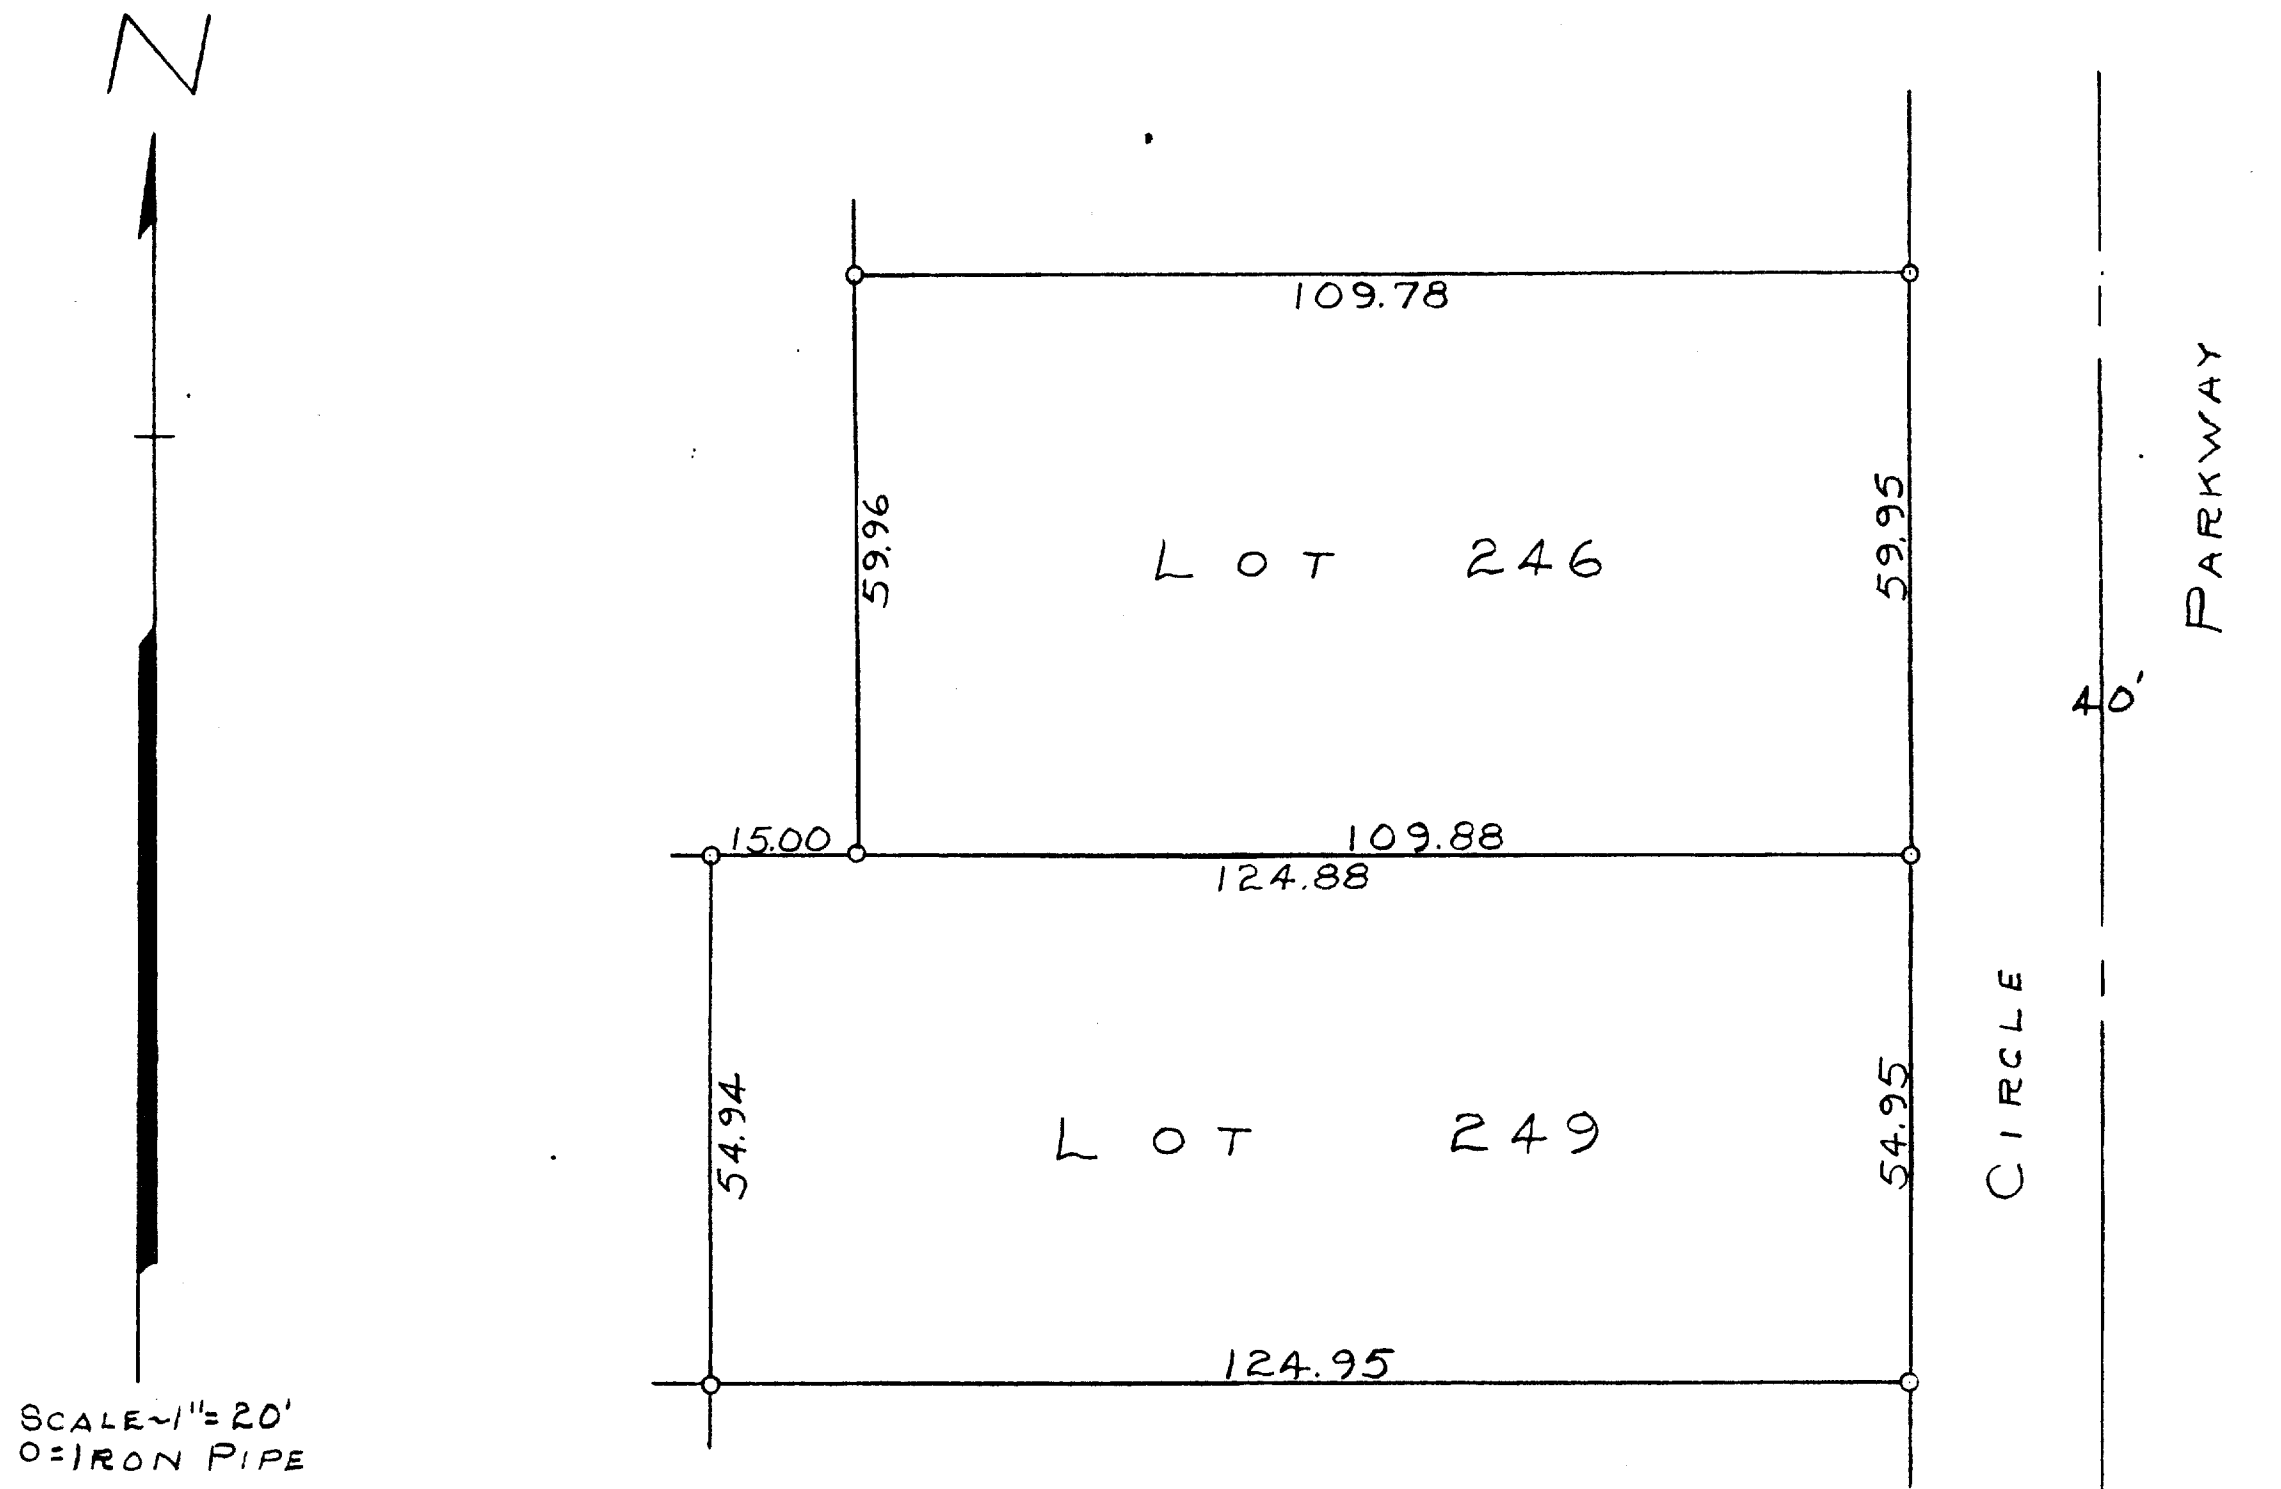

PLAT OF SURVEY OF LOTS 246 AND 249 OF CEDAR POINT PARK THIRD
 ADDITION LOCATED IN THE VILLAGE OF WILLIAMS BAY, WALWORTH COUNTY
 WISCONSIN
 JUNE 14, 1955

CP3 - 40
 " - 42 (part of)

George T. Dunham
 GEORGE T. DUNHAM, SURVEYOR
 DELAVAN, WISCONSIN 11-6