

PLAT OF SURVEY

of
Lots 62 and 62½ of Cedar Point Park Subdivision, located in
Section 6, Town 1 North, Range 17 East, Village of Williams
Bay, Walworth County, Wisconsin.

Surveyed for: Laverne Moore
1040 West Erie
Oakpark, Illinois. 60302

Surveyed by: Jensen Surveying & Mapping S.C.
45 S. Wisconsin St. PO Box 322
Elkhorn, Wisconsin 53121


Mapping date: April 23, 1987

Scale: 1" = 30'

1 NORTHEWEST CORNER
OF Lot 64
Copyright © 1987 by Jensen Surveying & Mapping S.C.

All rights reserved. No part of this survey plat may be reproduced or transmitted in any form by any means - graphic, electronic, or mechanical, including photocopying, tracing, or information storage and retrieval systems - without permission in writing from Thomas P.A. Jensen, Jensen Surveying & Mapping S.C.

Bearings referenced to the South line of the 15' wide road.
Assumed as N 43°41' E.

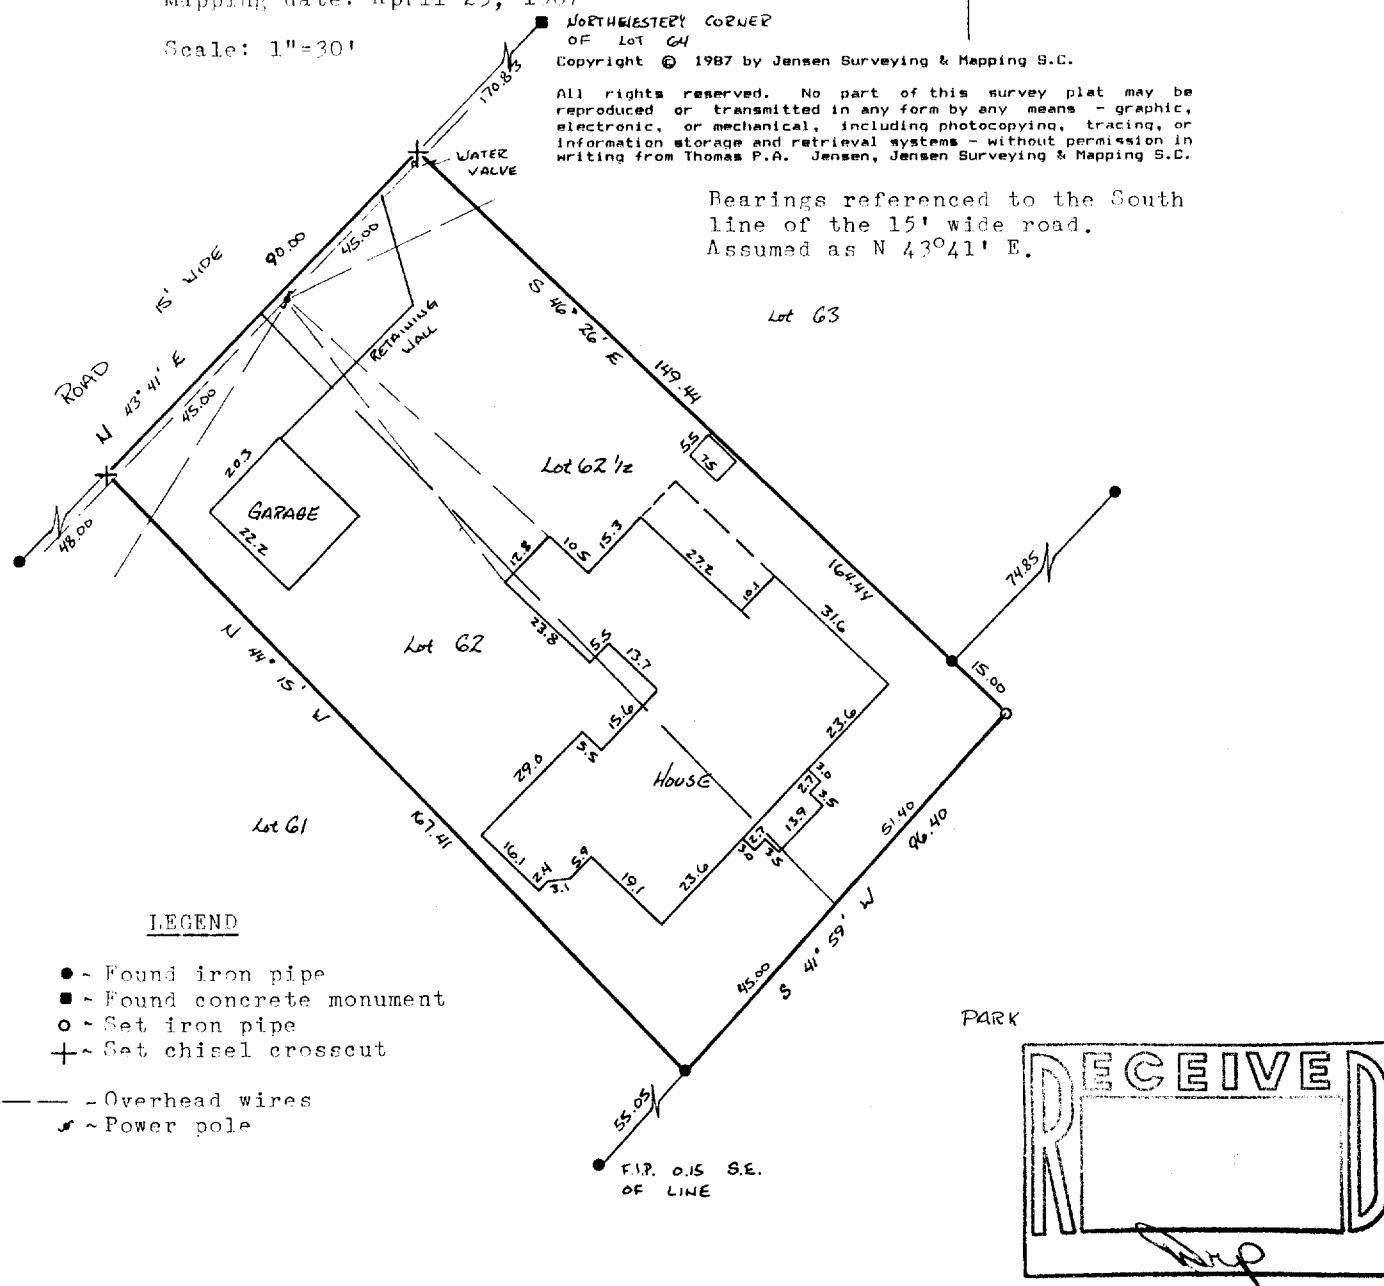

I, Thomas P.A. Jensen, Wisconsin Registered Land Surveyor, do hereby certify that this survey was performed by me, or under my direction, in full compliance with the owner's/agent's instructions and Chapter A-E 5 of the Wisconsin Administrative Code "Minimum Standards For Property Surveys"; and that this map is an accurate representation thereof to the best of my knowledge and belief.

Note: This survey plat is not certified unless signed and sealed in red ink.

Thomas P.A. Jensen R.L.S-1084
Jensen Surveying & Mapping S.C.

· 1987.023

11-612