



ABELL
SURVEYING & MAPPING
DELAVAL, WISCONSIN 53115
414-728-6737

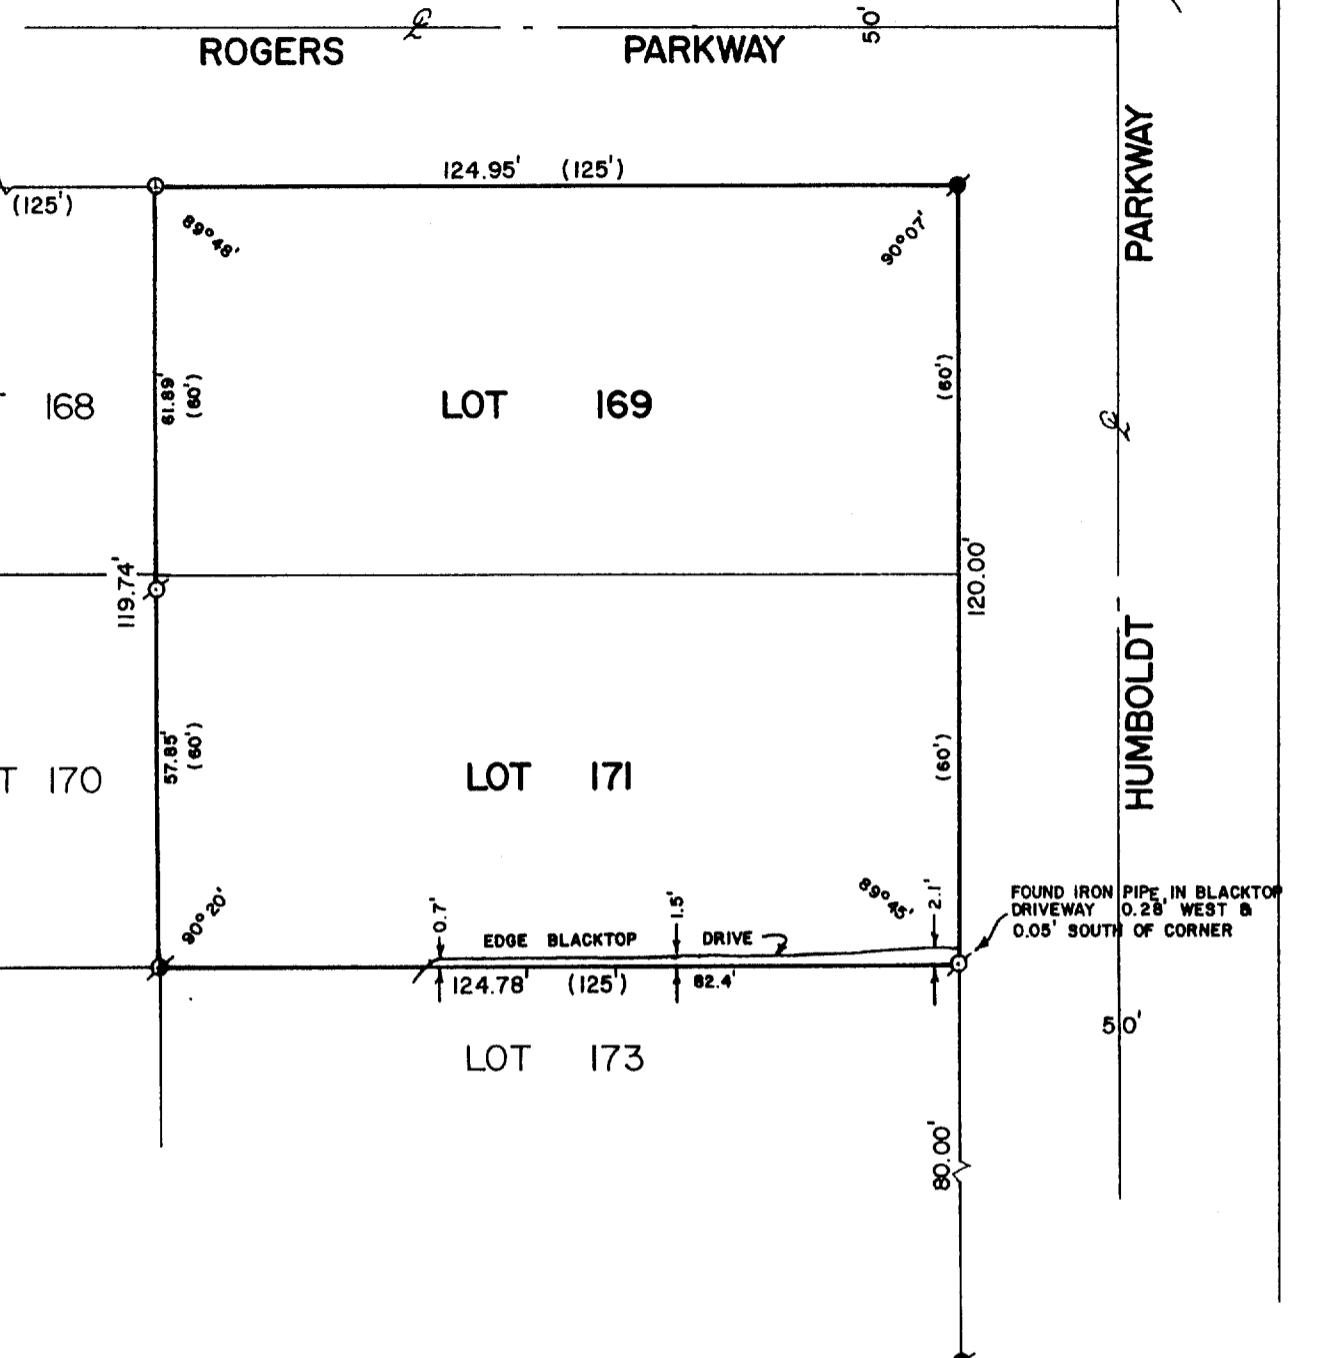

LOT 169 AND LOT 171 OF CEDAR POINT PARK, LOCATED
IN THE VILLAGE OF WILLIAMS BAY, WALWORTH COUNTY,
WISCONSIN.

ORDERED BY: BOB WEIR
6943 NELSON
CHICAGO, IL. 60634

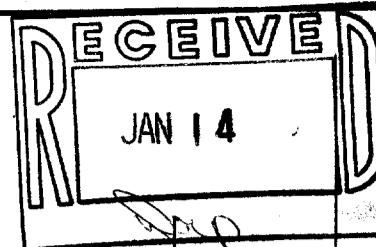

SCALE - 1"=30'

LEGEND

- ♀ - IRON PIPE FOUND
- ♀ - IRON ROD FOUND
- ♂ - CONCRETE MONUMENT FOUND
- - IRON ROD SET
- () - RECORDED AS

I, DAVID F. ABELL, DO HEREBY CERTIFY
THAT I HAVE SURVEYED THE PROPERTY
HEREON DESCRIBED ACCORDING TO THE
OFFICIAL RECORDS AND THAT THE PLAT
HEREON IS A CORRECT REPRESENTATION
OF THE PROPERTY LINES TO THE BEST OF
MY KNOWLEDGE AND BELIEF.

David F. Abell

DAVID F. ABELL
WISCONSIN REGISTERED LAND SURVEYOR, S-1596

December 14, 1987
DATE JOB NUMBER -87205

NOTE: THIS IS NOT A CERTIFIED COPY UNLESS SEALED.