



BIRCH GROVE PARK

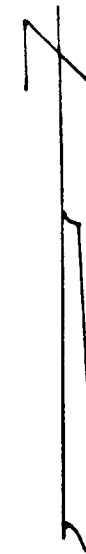

SCALE 1" = 20'
O = IRON PIPE

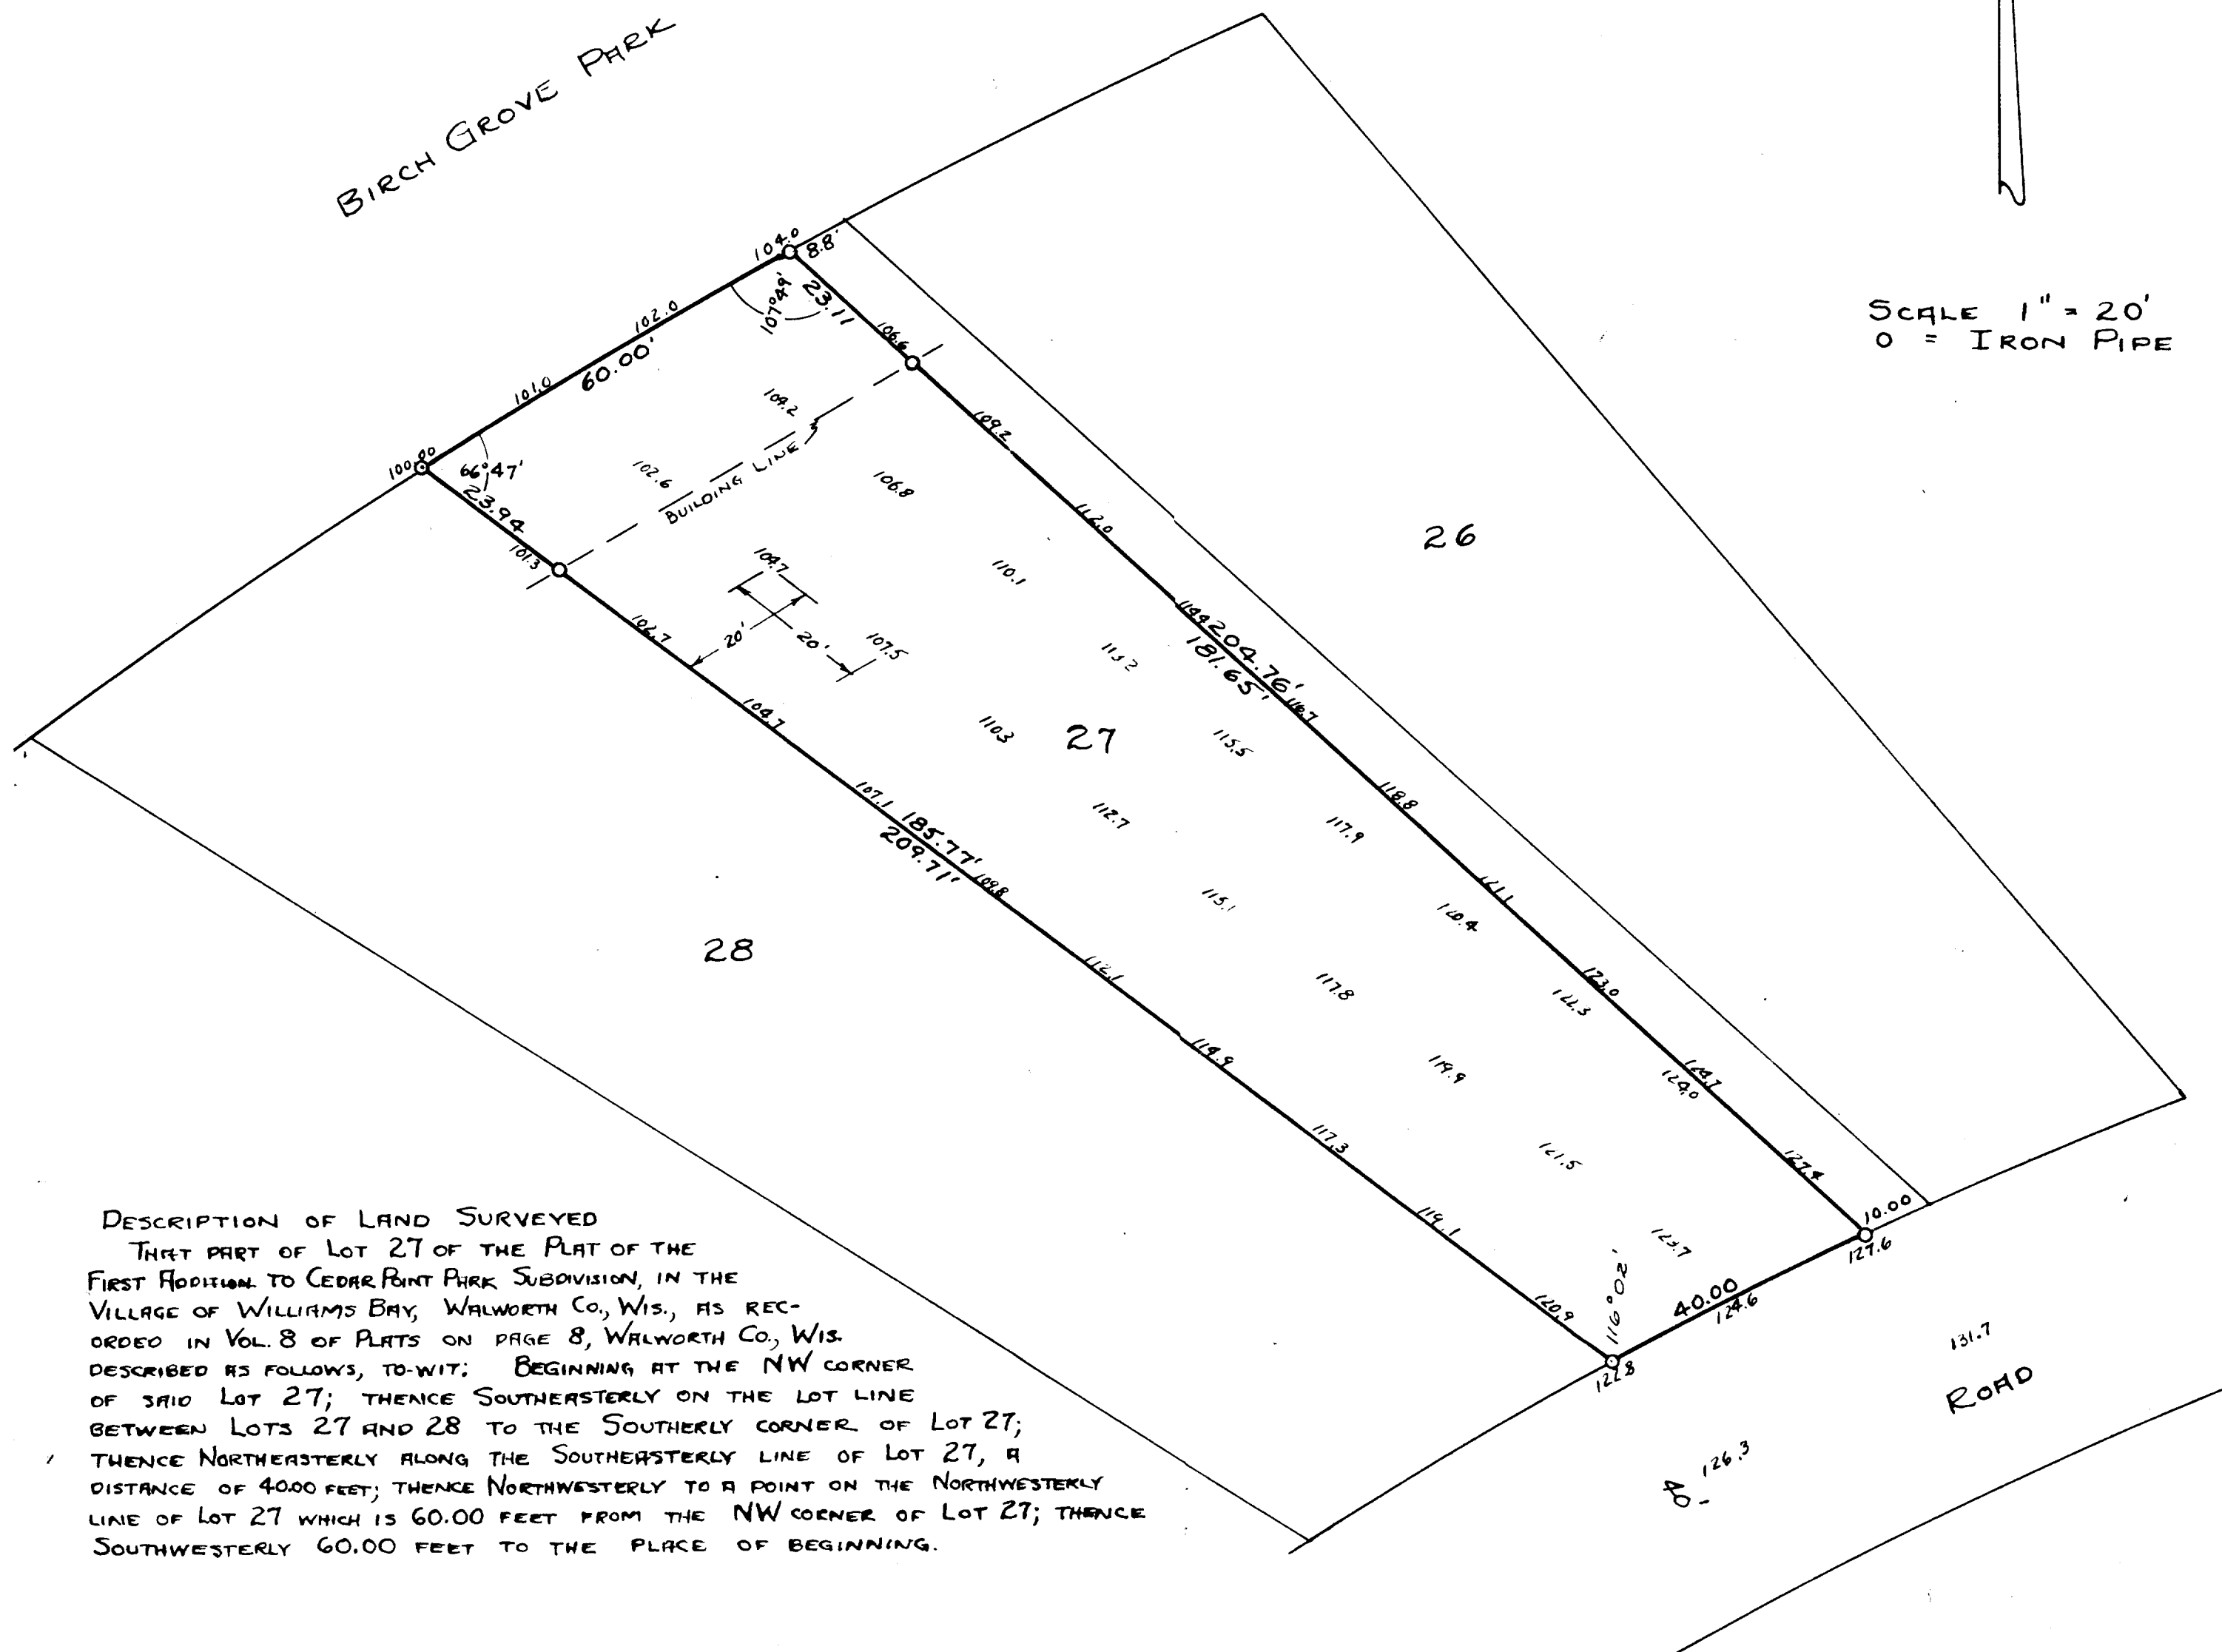

DESCRIPTION OF LAND SURVEYED

THAT PART OF LOT 27 OF THE PLAT OF THE FIRST ADDITION TO CEDAR POINT PARK SUBDIVISION, IN THE VILLAGE OF WILLIAMS BAY, WALWORTH CO., WIS., AS RECORDED IN VOL. 8 OF PLATS ON PAGE 8, WALWORTH CO., WIS. DESCRIBED AS FOLLOWS, TO-WIT: BEGINNING AT THE NW CORNER OF SAID LOT 27; THENCE SOUTHEASTERLY ON THE LOT LINE BETWEEN LOTS 27 AND 28 TO THE SOUTHERLY CORNER OF LOT 27; THENCE NORTHEASTERLY ALONG THE SOUTHEASTERLY LINE OF LOT 27, A DISTANCE OF 40.00 FEET; THENCE NORTHWESTERLY TO A POINT ON THE NORTHWESTERLY LINE OF LOT 27 WHICH IS 60.00 FEET FROM THE NW CORNER OF LOT 27; THENCE SOUTHWESTERLY 60.00 FEET TO THE PLACE OF BEGINNING.

PLAT OF SURVEY OF PART OF LOT 27 OF CEDAR POINT PARK 1ST ADDITION IN THE VILLAGE OF WILLIAMS BAY, WALWORTH CO., WIS.

H. E. Johnson

11-61 J

CDI-27