



ABELL
SURVEYING & MAPPING
DELAVER, WISCONSIN 53115
414-728-6737

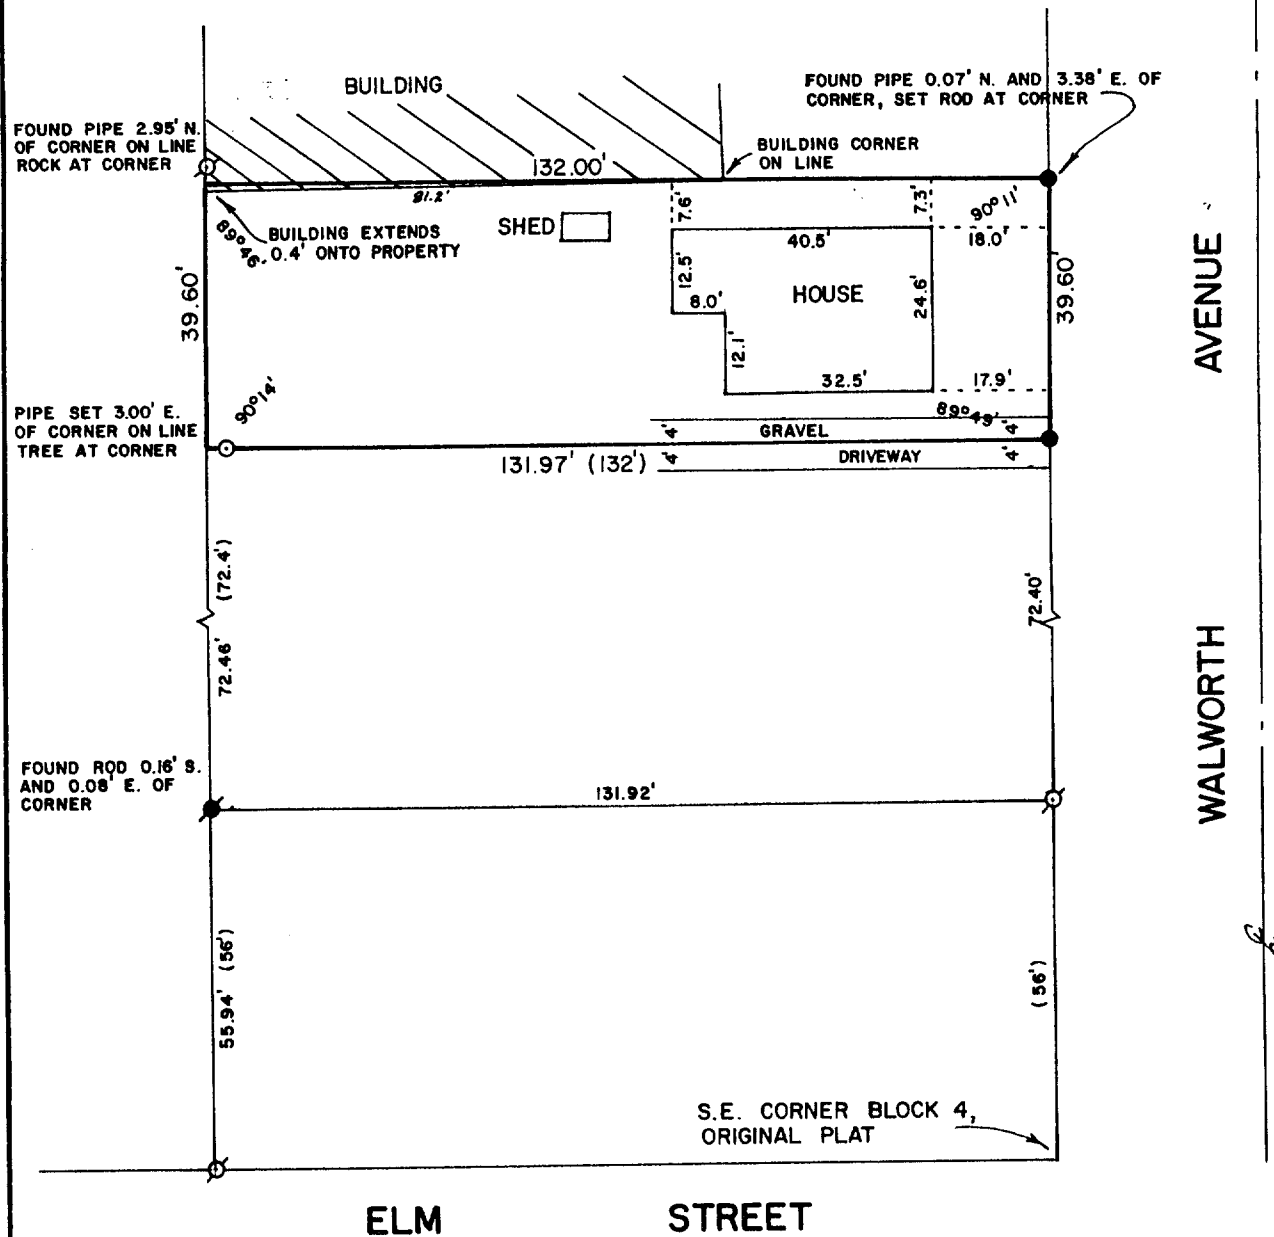

PLAT OF SURVEY OF

A PARCEL OF LAND 39.6 FEET x 132 FEET FACING WALWORTH AVENUE, MORE PARTICULARLY DESCRIBED AS THE NORTH 39.6 FEET OF THE SOUTH 168 FEET OF THE EAST 132 FEET OF LOT 1, BLOCK 4, ORIGINAL PLAT OF THE VILLAGE OF WILLIAMS BAY, WALWORTH COUNTY, WISCONSIN. TAX KEY NUMBER WOP-55

ORDERED BY: ANCHOR SAVINGS & LOAN
P.O. BOX 508
LAKE GENEVA, WI. 53147

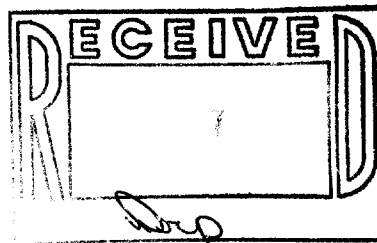

SCALE - 1"=30'

LEGEND

- - IRON PIPE FOUND
- - IRON ROD FOUND
- - IRON PIPE SET
- - IRON ROD SET
- () - RECORDED AS

I, DAVID F. ABELL, DO HEREBY CERTIFY THAT I HAVE SURVEYED THE PROPERTY HEREON DESCRIBED ACCORDING TO THE OFFICIAL RECORDS AND THAT THE PLAT HEREON IS A CORRECT REPRESENTATION OF THE PROPERTY LINES TO THE BEST OF MY KNOWLEDGE AND BELIEF.

David F. Abell
DAVID F. ABELL
WISCONSIN REGISTERED LAND SURVEYOR, S-1596

DATE *January 20, 1988* JOB NUMBER - 88007
NOTE: THIS IS NOT A CERTIFIED COPY UNLESS SEALED.