


WALNUT GROVE
PARK

CEDAR

POINT

DRIVE

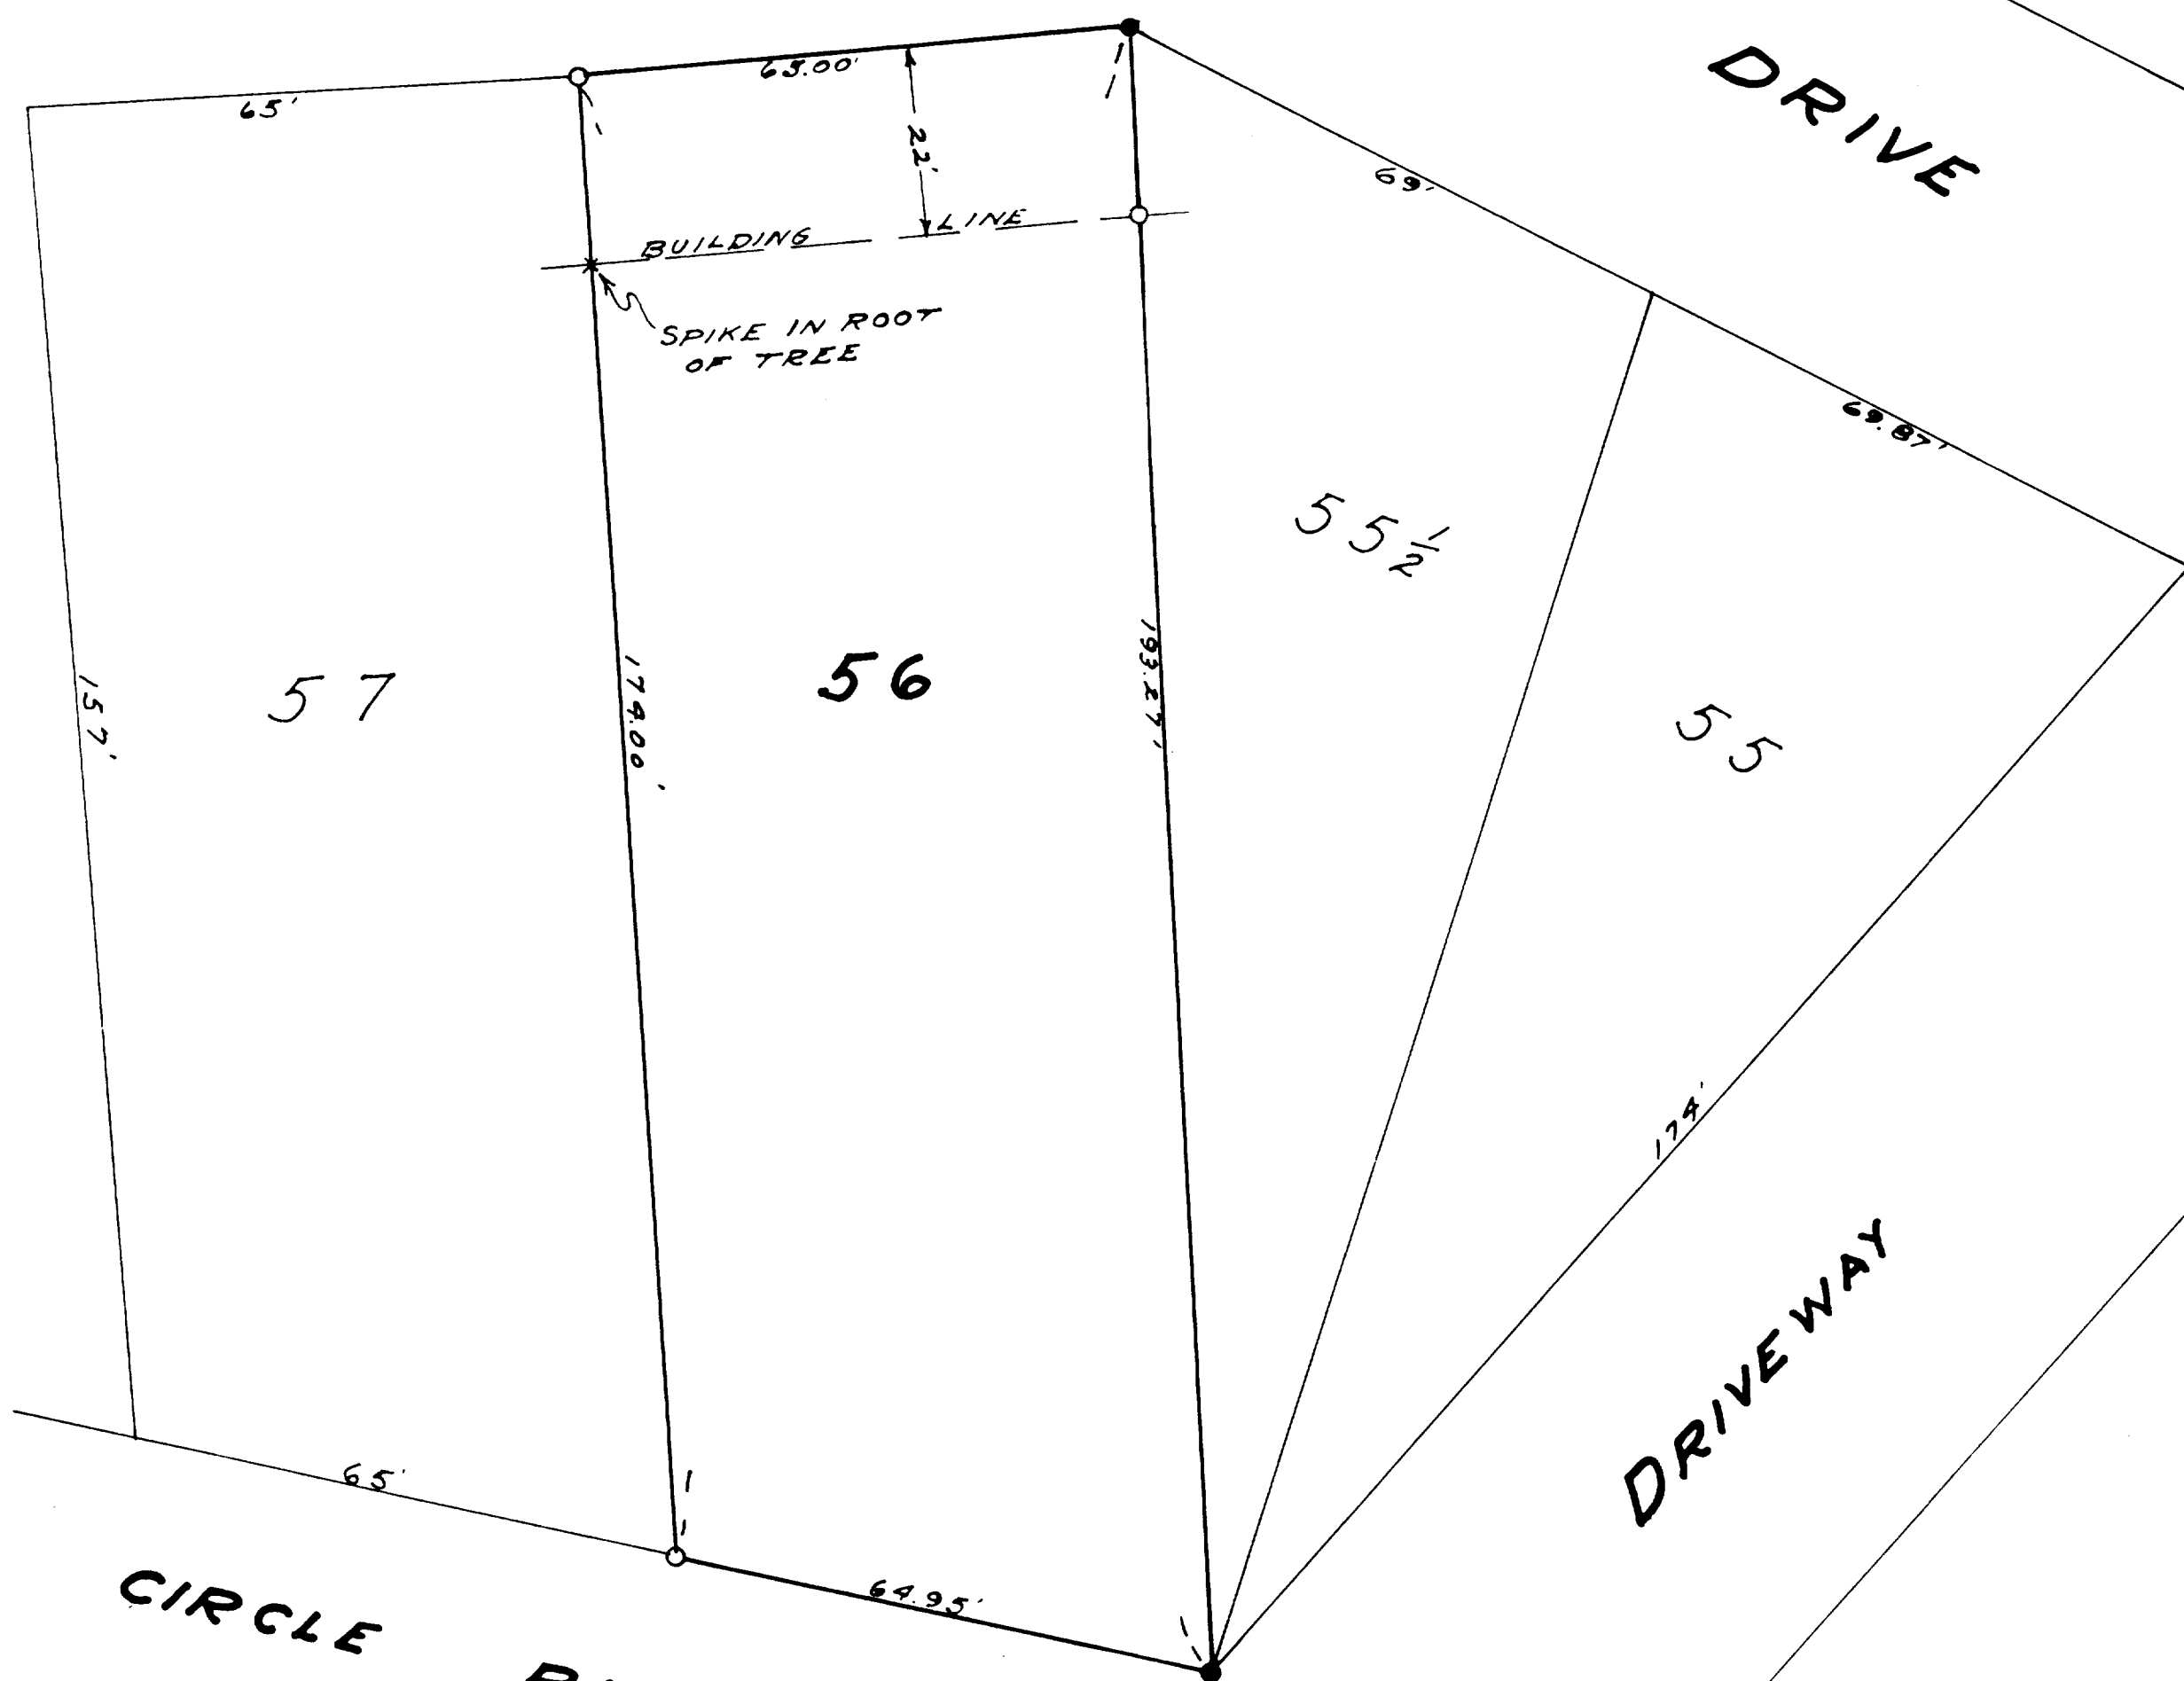

CIRCLE
PARKWAY

DRIVEWAY

N

SCALE 1"=20'
O = IRON PIPE
O = CONC. MONU.

PLAT OF SURVEY
LOT 56 OF THE FIRST ADDITION TO CEDAR
POINT PARK, LOCATED IN THE VILLAGE OF
WILLIAMS BAY, WALWORTH COUNTY, WISCONSIN.
MAY 1949.

H. E. Johnson
SURVEYOR