
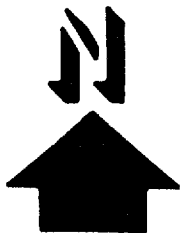
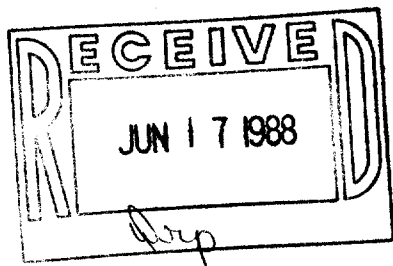


WALWORTH COUNTY
SURVEYING & MAPPING
LAKE GENEVA, WISCONSIN

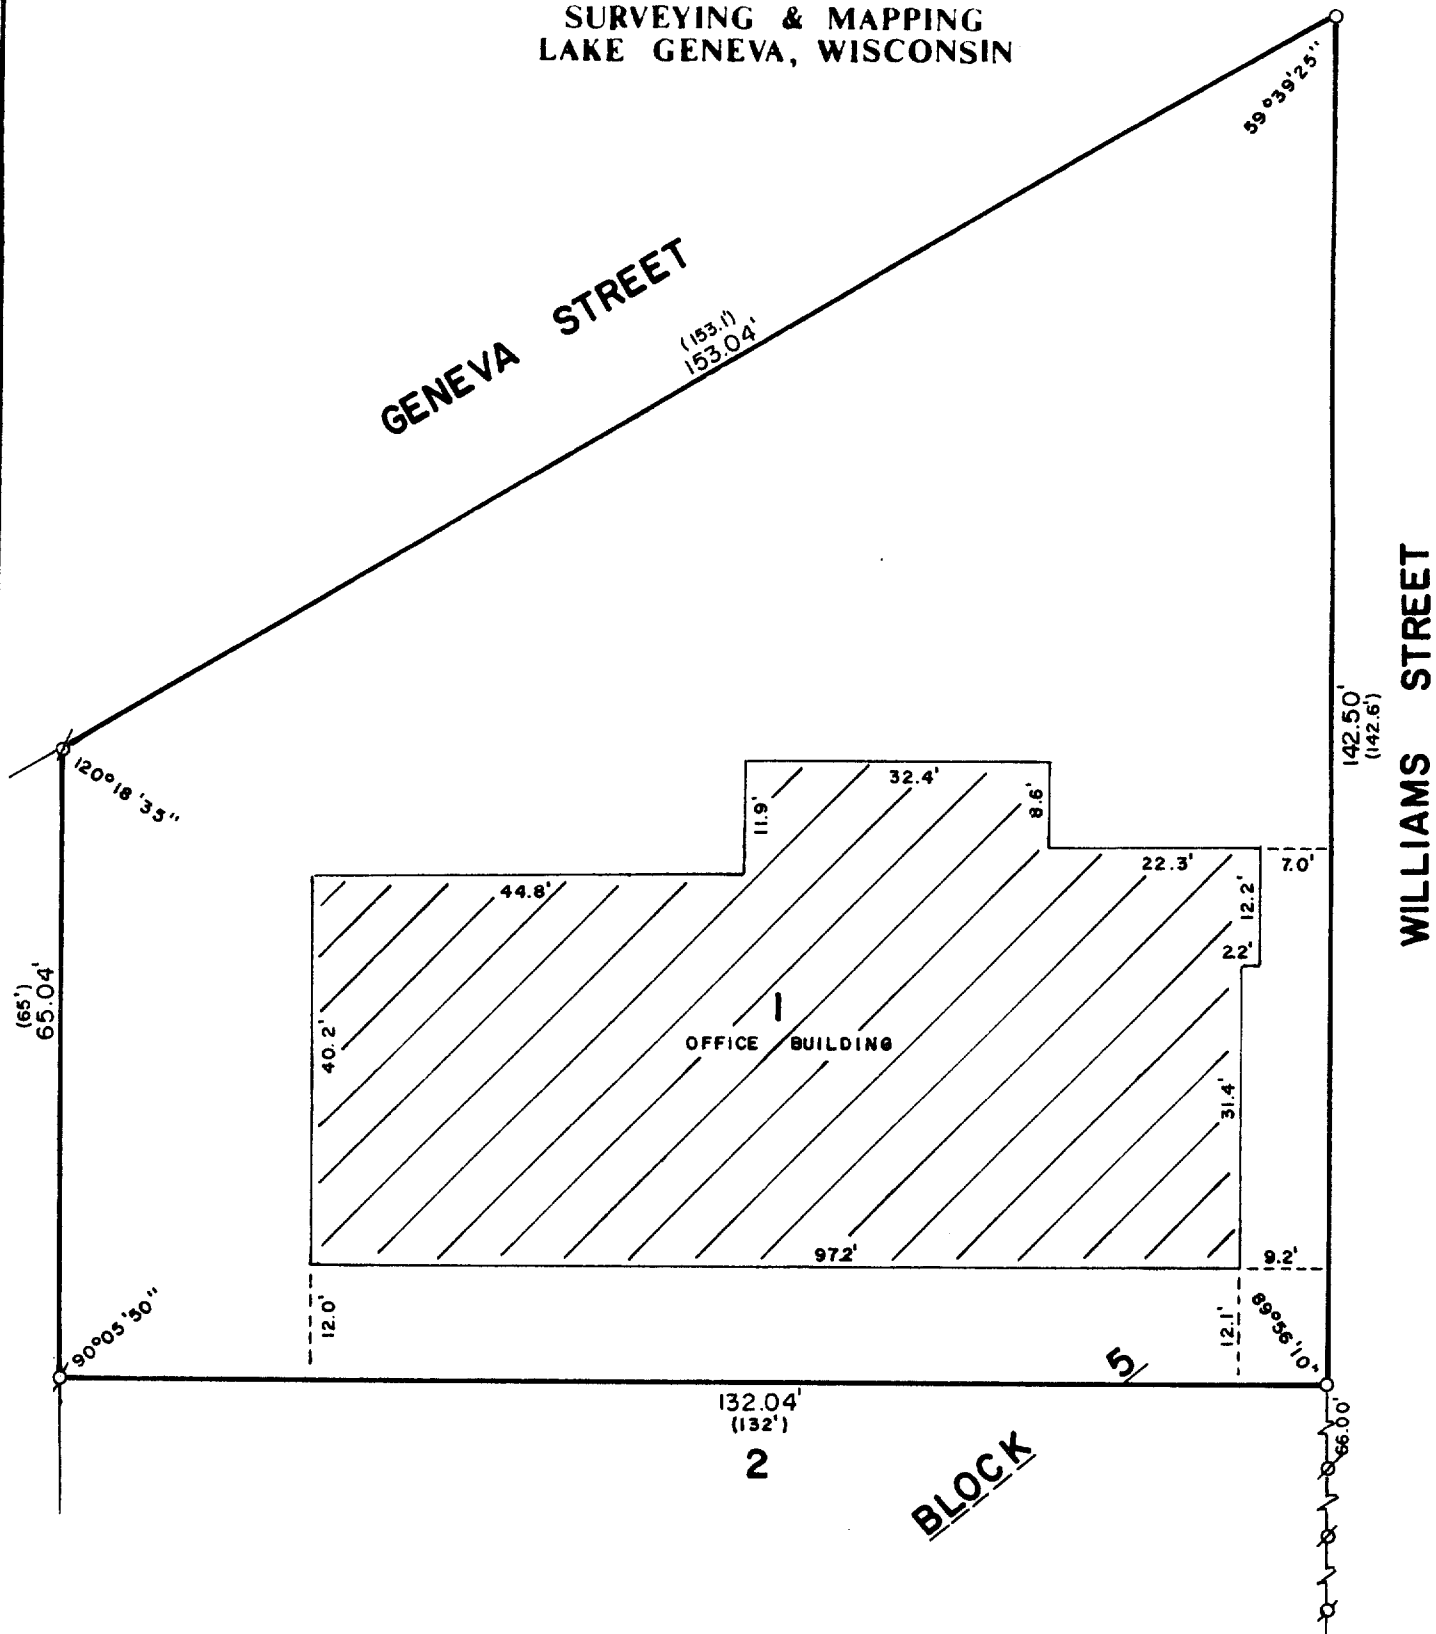

SCALE: 1"=20'

ø - IRON PIPE FOUND
ø - IRON ROD FOUND
o - IRON ROD PLACED
() - RECORDED AS

PLAT OF SURVEY OF
LOT 1, BLOCK 5 OF THE ORIGINAL PLAT
OF THE VILLAGE OF WILLIAMS BAY,
WALWORTH COUNTY, WISCONSIN.

ORDERED BY: KEEFE REAL ESTATE
704 MAIN STREET
LAKE GENEVA, WISCONSIN
53147

I, ROBERT M. BAERENWALD, DO HEREBY CERTIFY THAT I
HAVE SURVEYED THE PROPERTY HEREON DESCRIBED ACCORDING
TO THE OFFICIAL RECORDS AND THAT THE PLAT HEREON IS A
CORRECT REPRESENTATION OF THE PROPERTY LINES TO THE
BEST OF MY KNOWLEDGE AND BELIEF.

Robert M. Baerenwald
ROBERT M. BAERENWALD
WISCONSIN REGISTERED LAND SURVEYOR, S-1508

April 30, 1988
DATE JOB NO. 1497

NOTE: THIS IS NOT A CERTIFIED COPY UNLESS SEALED.
11-650