



DUNHAM SURVEYING, S.C.
SURVEYING & SUBDIVIDING
DELAVER, WISCONSIN 53115

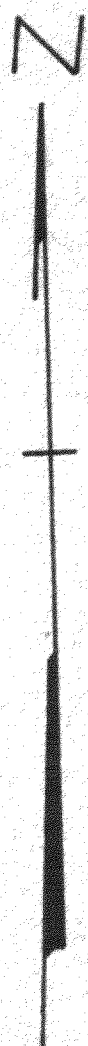

Scale - 1" = 20'
 ● = 1" Iron Pipe Found
 ● = 3/4" Iron Pipe Found
 ● = 1/2" Iron Pipe Found
 ○ = 3/4" X 24" Iron Pipe Set
 ● = 1/2" X 24" Iron Pipe Set
 --- = Fence Line
 Bearings referenced to the south line of
 Leichty Drive with the assumed bearing of
 East
 Owner: Marianne Klemke
 P.O. Box 64
 Williams Bay, WI 53191

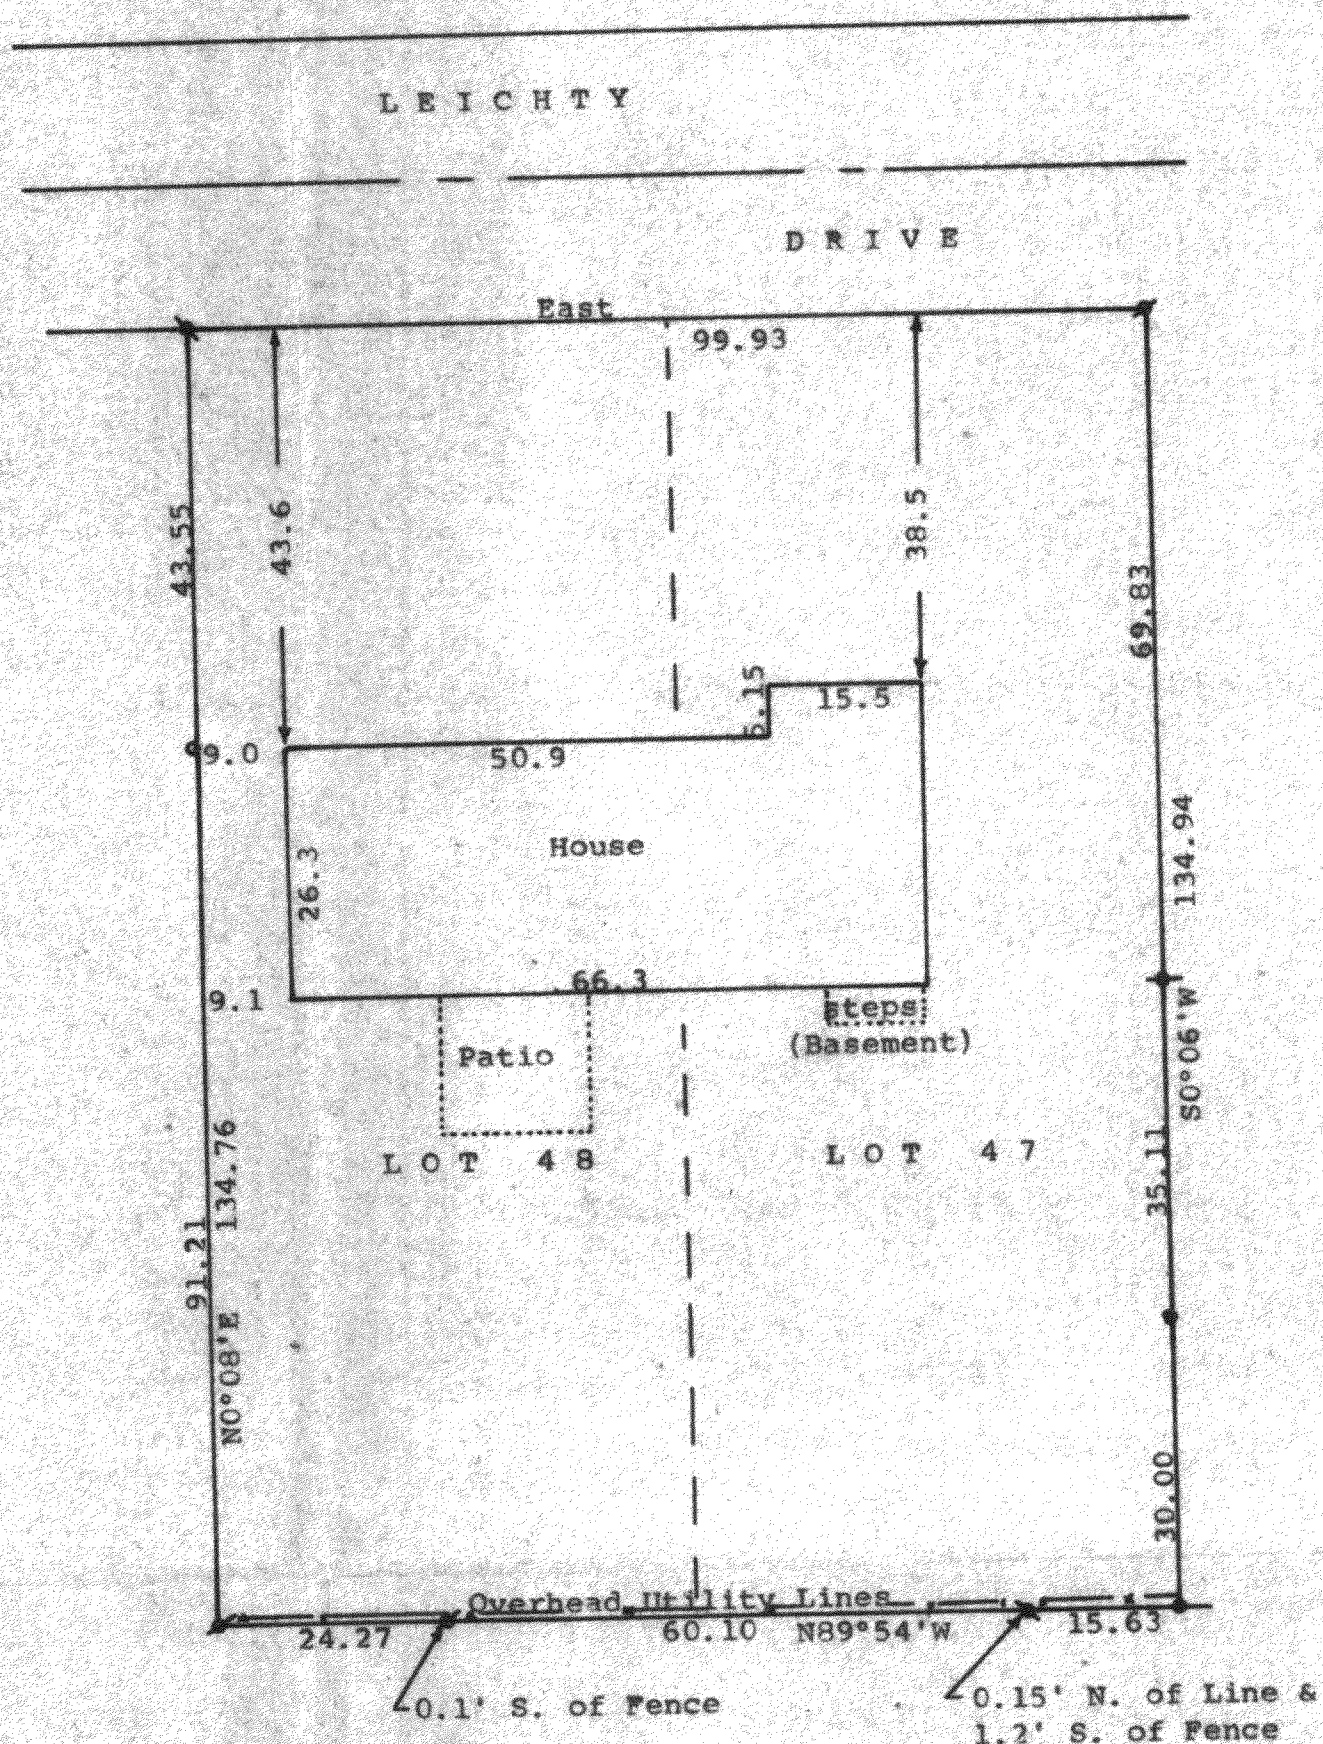


STATE OF WISCONSIN)
COUNTY OF WALWORTH)

I, George T. Dunham, Surveyor, certify that I have surveyed the property described as follows:

Lots 47 and 48 in Summer Haven, a subdivision located in the Village of Williams Bay, Walworth County, Wisconsin.

and that the plat shown hereon is a correct representation thereof and shows the size and location of the property, its exterior boundaries, the location of all visible structures and dimensions of all principal buildings thereon, boundary fences, apparent easements, roadways and visible encroachments, if any, and that I have surveyed the property hereon described, according to the official records, to the best of my knowledge and belief.

November 3, 1987

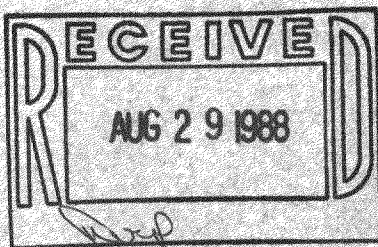

George T. Dunham
George T. Dunham, Surveyor

