


PROJECT # 3036

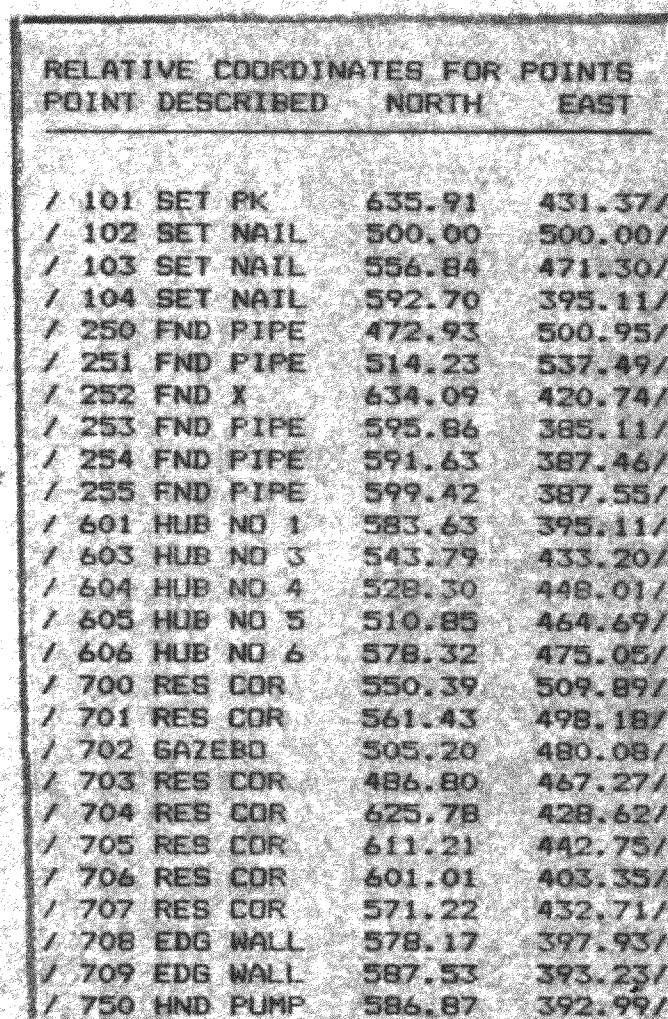

PROJECT # 3036