


PLAT OF SURVEY
OF
PART OF THE CONFERENCE POINT PROPERTY LOCATED

IN THE S 1/2 OF THE SE 1/4 OF SECTION 1
AND
IN THE NW 1/4 OF THE NE 1/4 OF SECTION 12
TOWN 1 NORTH, RANGE 16 EAST
VILLAGE OF WILLIAMS BAY,
WALWORTH COUNTY, WISCONSIN

SECTION 1-1-16

A parcel of land located in the S 1/2 of the SE 1/4 of Section 1 and the NW 1/4 of the NE 1/4 of Section 12, Town 1 North, Range 16 East, Village of Williams Bay, Walworth County, Wisconsin, more particularly described as follows: Commence at the East 1/4 Corner of said Section 1; thence S87°12'29"W, along the East-West 1/4 Section line, 1334.14 feet; thence S0°14'18"E 1279.76 feet to the Middle 1/8 Corner of said SE 1/4 of Section 1, said Middle 1/8 corner being the Point of Beginning; thence S0°16'E, along the East line of the West 1/2 of said SE 1/4 of Section 1, 1208.71 feet to a concrete monument; thence N89°00'E 20.00 feet to an iron pipe; thence S18°25'W 382.31 feet to an iron pipe on a meander line, said iron pipe being N18°25'E 25.0 feet more or less from the shore of Lake Geneva; thence N59°26'26"W, along said meander line, 126.37 feet to a concrete monument, said monument being N0°09'40"W 26.0 feet more or less from the shore of Lake Geneva; thence N25°21'31"E 140.13 feet to an iron pipe; thence N0°10'51"W 171.83 feet to an iron pipe; thence N49°25'55"W 79.59 feet to an iron pipe; thence N0°09'40"W 1150.08 feet to a concrete monument on the southerly right of way line of Wood Drives; thence N89°11'03"E, along said southerly right of way line, 210.00 feet to the Point of Beginning. Also to include all the land between said meander line and the shore of Lake Geneva as encompassed by the above described bearings and distances from said shore to said meander line. Parcel contains 8.94 acres more or less.

SURVEYED BY: JENSEN SURVEYING & MAPPING S.C.
45 SOUTH WISCONSIN STREET
ELKHORN, WISCONSIN 53121
(414) 723-3434

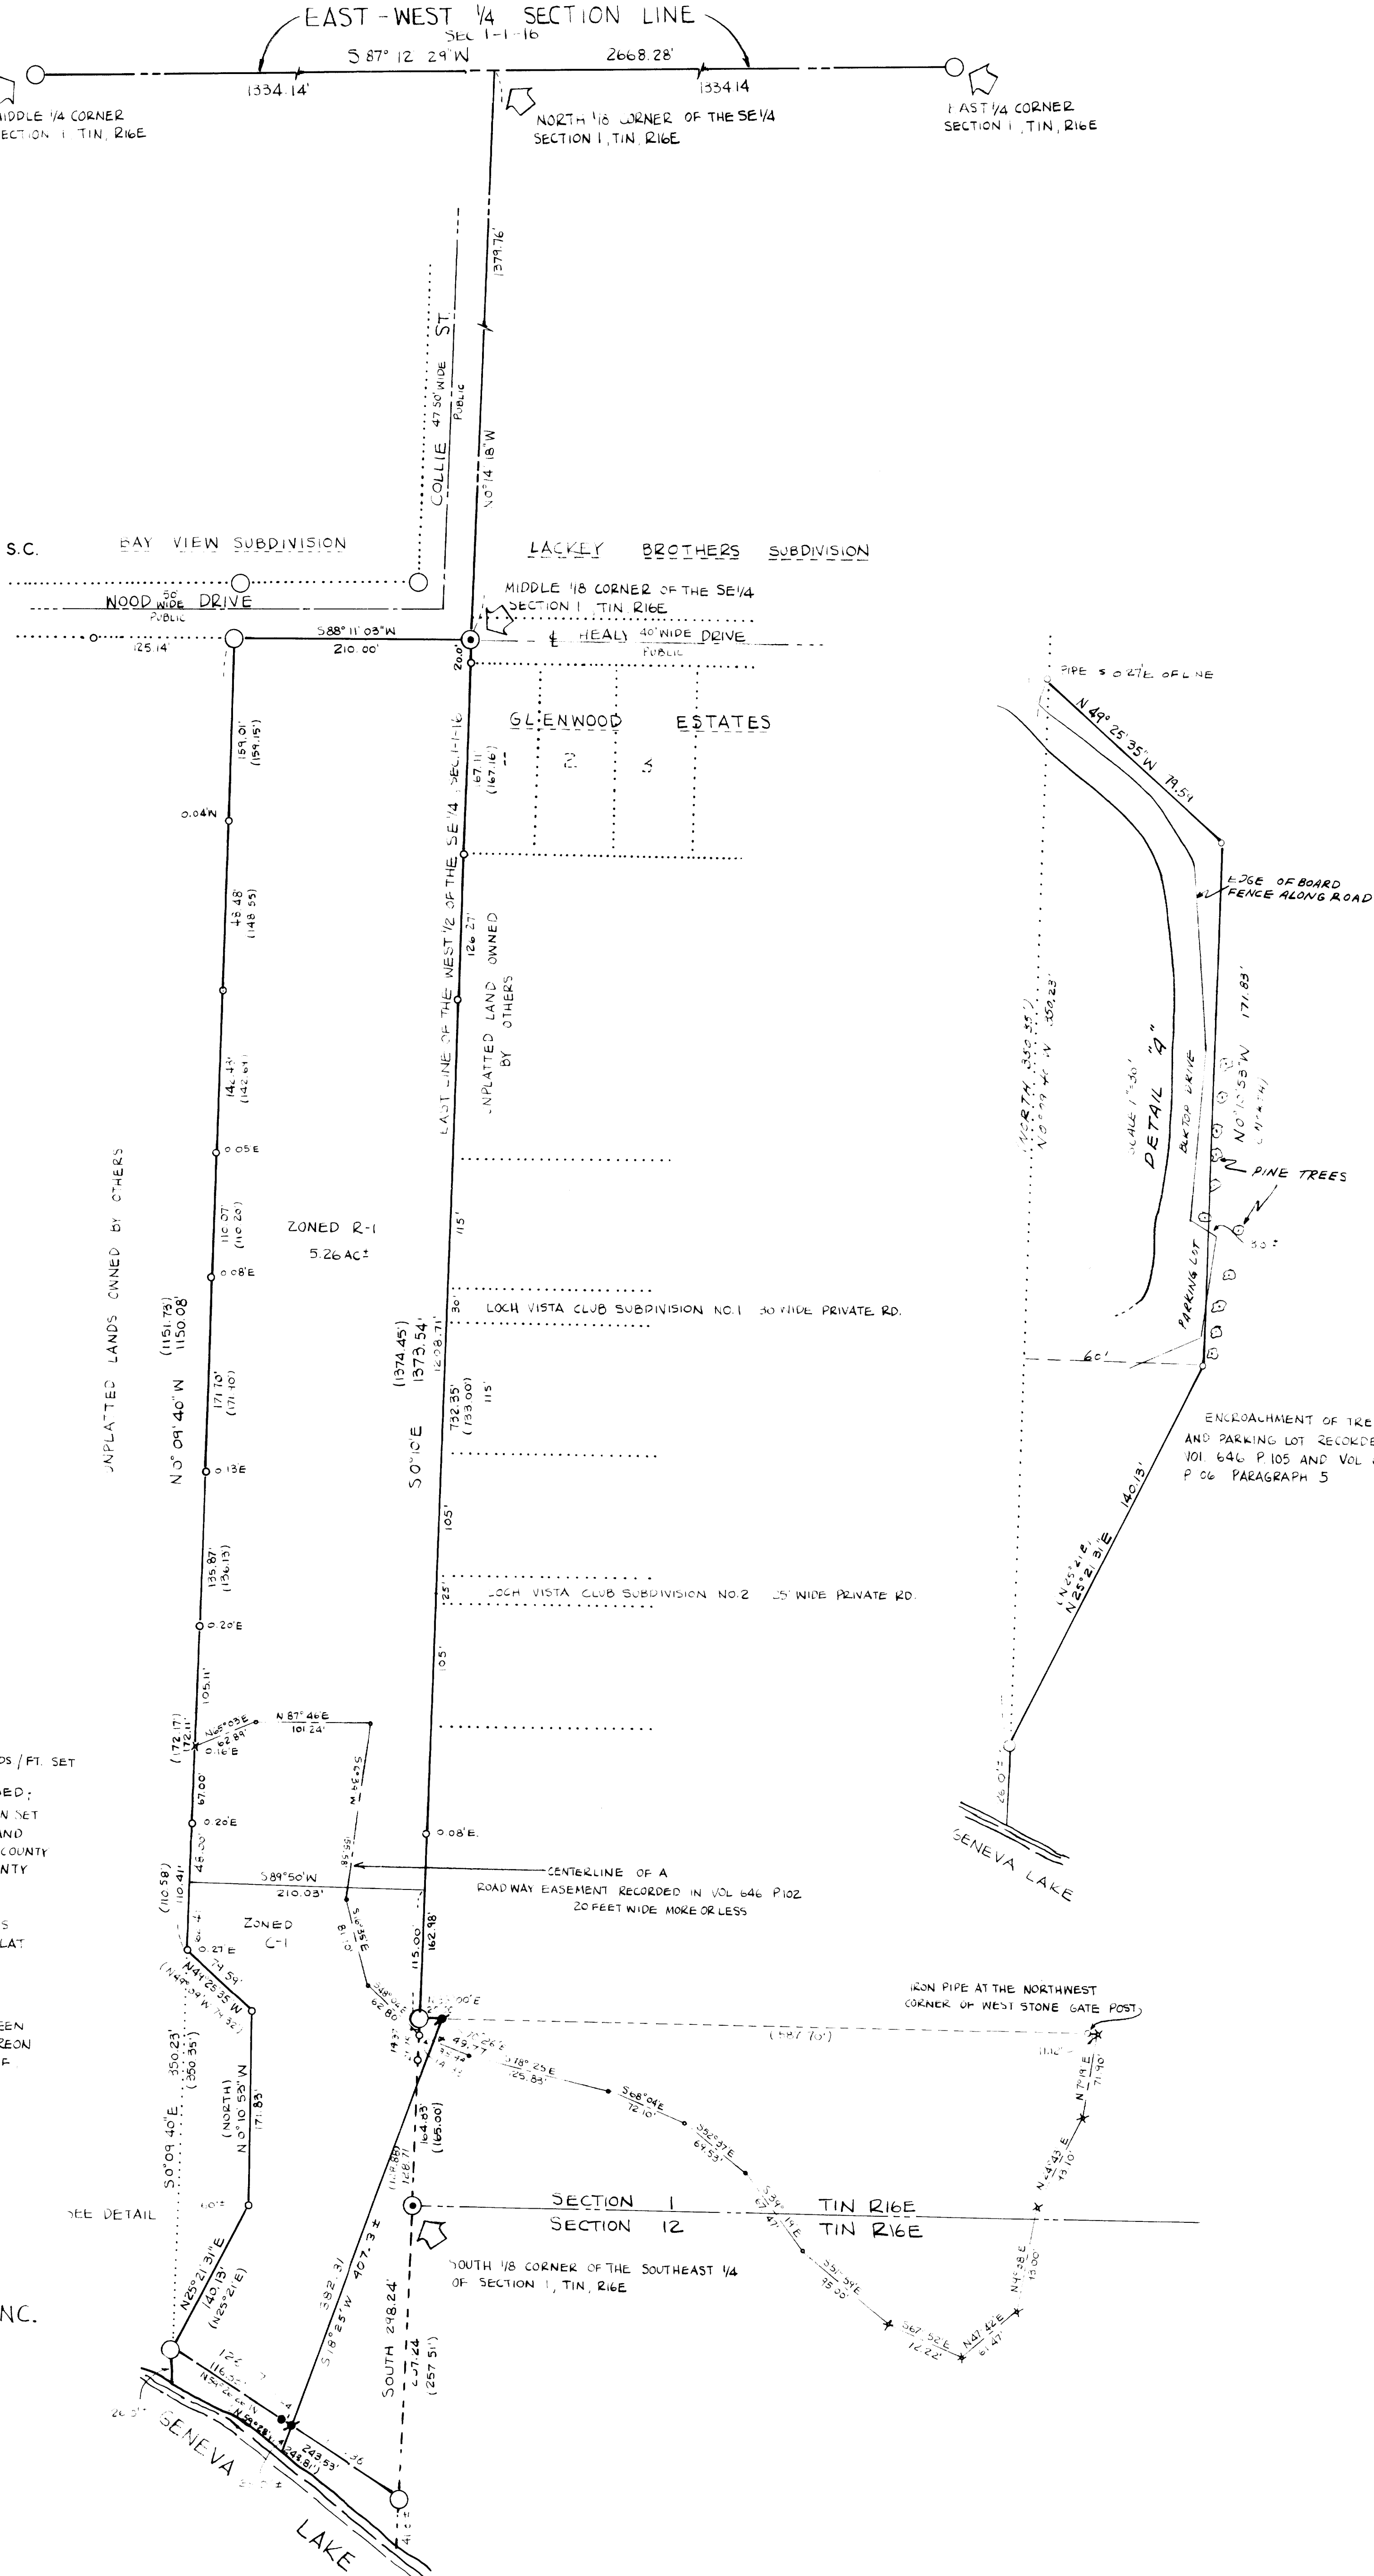


I HEREBY CERTIFY THAT THE ABOVE DESCRIBED PROPERTY HAS BEEN SURVEYED UNDER MY DIRECTION AND THAT THE PLAT SHOWN HEREON IS AN ACCURATE SURVEY AND A TRUE REPRESENTATION THEREOF AND CORRECTLY SHOWS THE BOUNDARY LINES OF SAID PROPERTY

DATED OCT 20 1988

THOMAS PA JENSEN S-1084

SURVEYED FOR: CONFERENCE POINT CAMP INC.
CONFERENCE POINT ROAD P.O. BOX 17
WILLIAMS BAY, WISCONSIN 53191
MR JACK HAYES

REVISED: MARCH 25, 1988

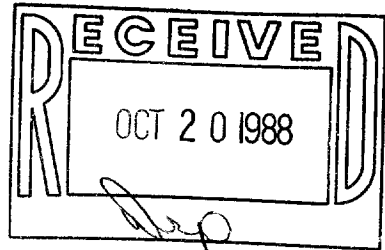

Copyright © 1988 by Jensen Surveying & Mapping S.C.

All rights reserved. No part of this survey plat may be reproduced or transmitted in any form or by any means, electronic, mechanical, photocopying, recording, or by any information storage and retrieval system, without permission in writing from Thomas P.A. Jensen, Jensen Surveying & Mapping S.C.