



WALWORTH COUNTY
SURVEYING & MAPPING
LAKE GENEVA, WISCONSIN

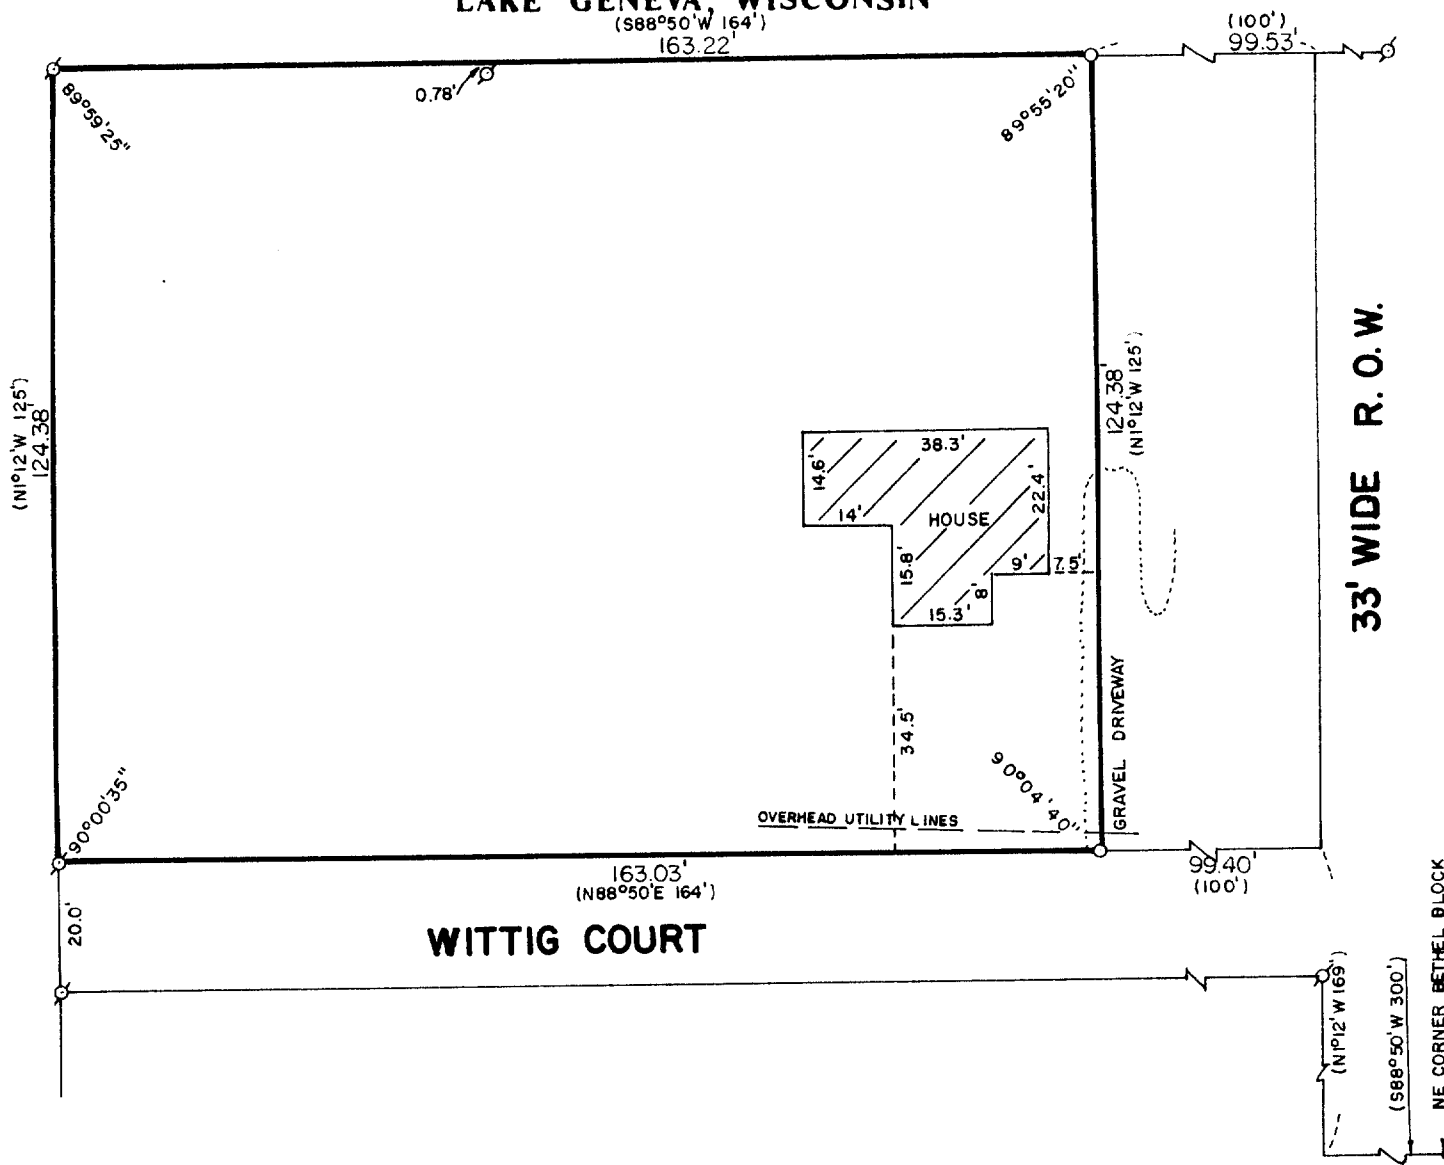

PLAT OF SURVEY OF

A PARCEL OF LAND LOCATED IN THE NORTHEAST
1/4 OF SECTION 1, T 1 N, R 16 E, VILLAGE
OF WILLIAMS BAY, WALWORTH COUNTY, WISCONSIN.

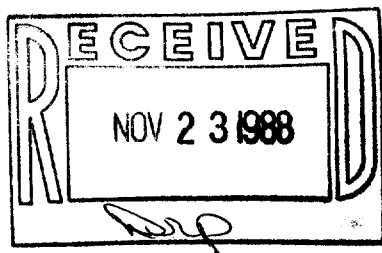

ORDERED BY: CATHERINE FIEGEL
C/O CRANDALL & THOMAS
LAKE GENEVA, WISCONSIN
53147



SCALE: 1" = 30'

- ⊙ - IRON PIPE FOUND
- - IRON ROD PLACED
- () - RECORDED AS

Robert M. Baerenwald
ROBERT M. BAERENWALD
WISCONSIN REGISTERED LAND SURVEYOR, S-1508

at 11/18/88
DATE JOB NO. 1670

NOTE: THIS IS NOT A CERTIFIED COPY UNLESS SEALED.