
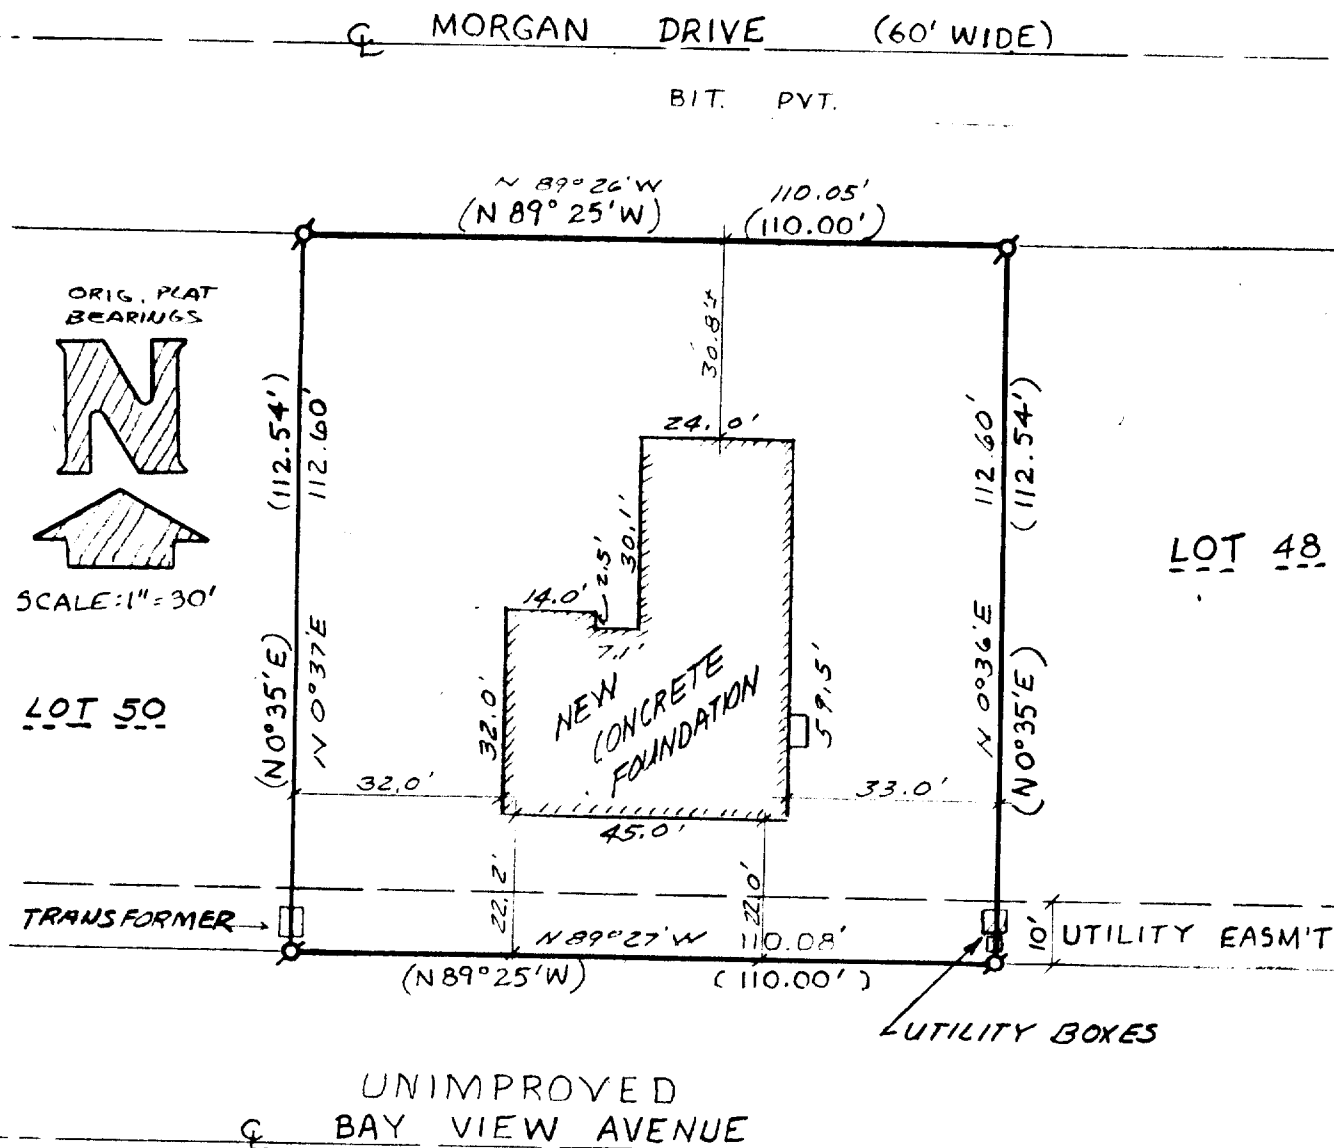


PLAT OF SURVEY OF LOT 49
WILLABAY WOODS
VILLAGE OF WILLIAMS BAY, WALWORTH CO., WISCONSIN

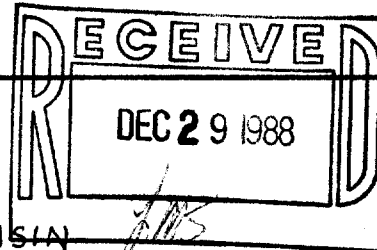

WORK ORDERED BY:
CHOYCE ENTERPRISES

LEGEND:

- Ø - IRON PIPE FOUND
- - IRON PIPE SET
- (XXX.XX') - RECORD DIMENSION

I HEREBY CERTIFY THAT I HAVE
SURVEYED THE ABOVE-DESCRIBED
PROPERTY AND THAT THE ABOVE MAP
IS A TRUE REPRESENTATION THEREOF
AND SHOWS THE SIZE AND LOCATION OF
THE PROPERTY, ITS EXTERIOR BOUND-
ARIES, THE LOCATION OF ALL VISIBLE
STRUCTURES AND DIMENSIONS OF ALL
PRINCIPAL BUILDINGS THEREON TO
THE BEST OF MY PROFESSIONAL
KNOWLEDGE AND BELIEF.



FARRIS, HANSEN & ASSOCIATES, INC.
Engineers Architects Surveyors
7 Ridgeway Court P.O. Box 437
ELKHORN, WISCONSIN 53121
Office: (414) 723-2098

Robert A. Farris
DATED: DEC 2, 1988

PROJ. NO. 3131

11-679