


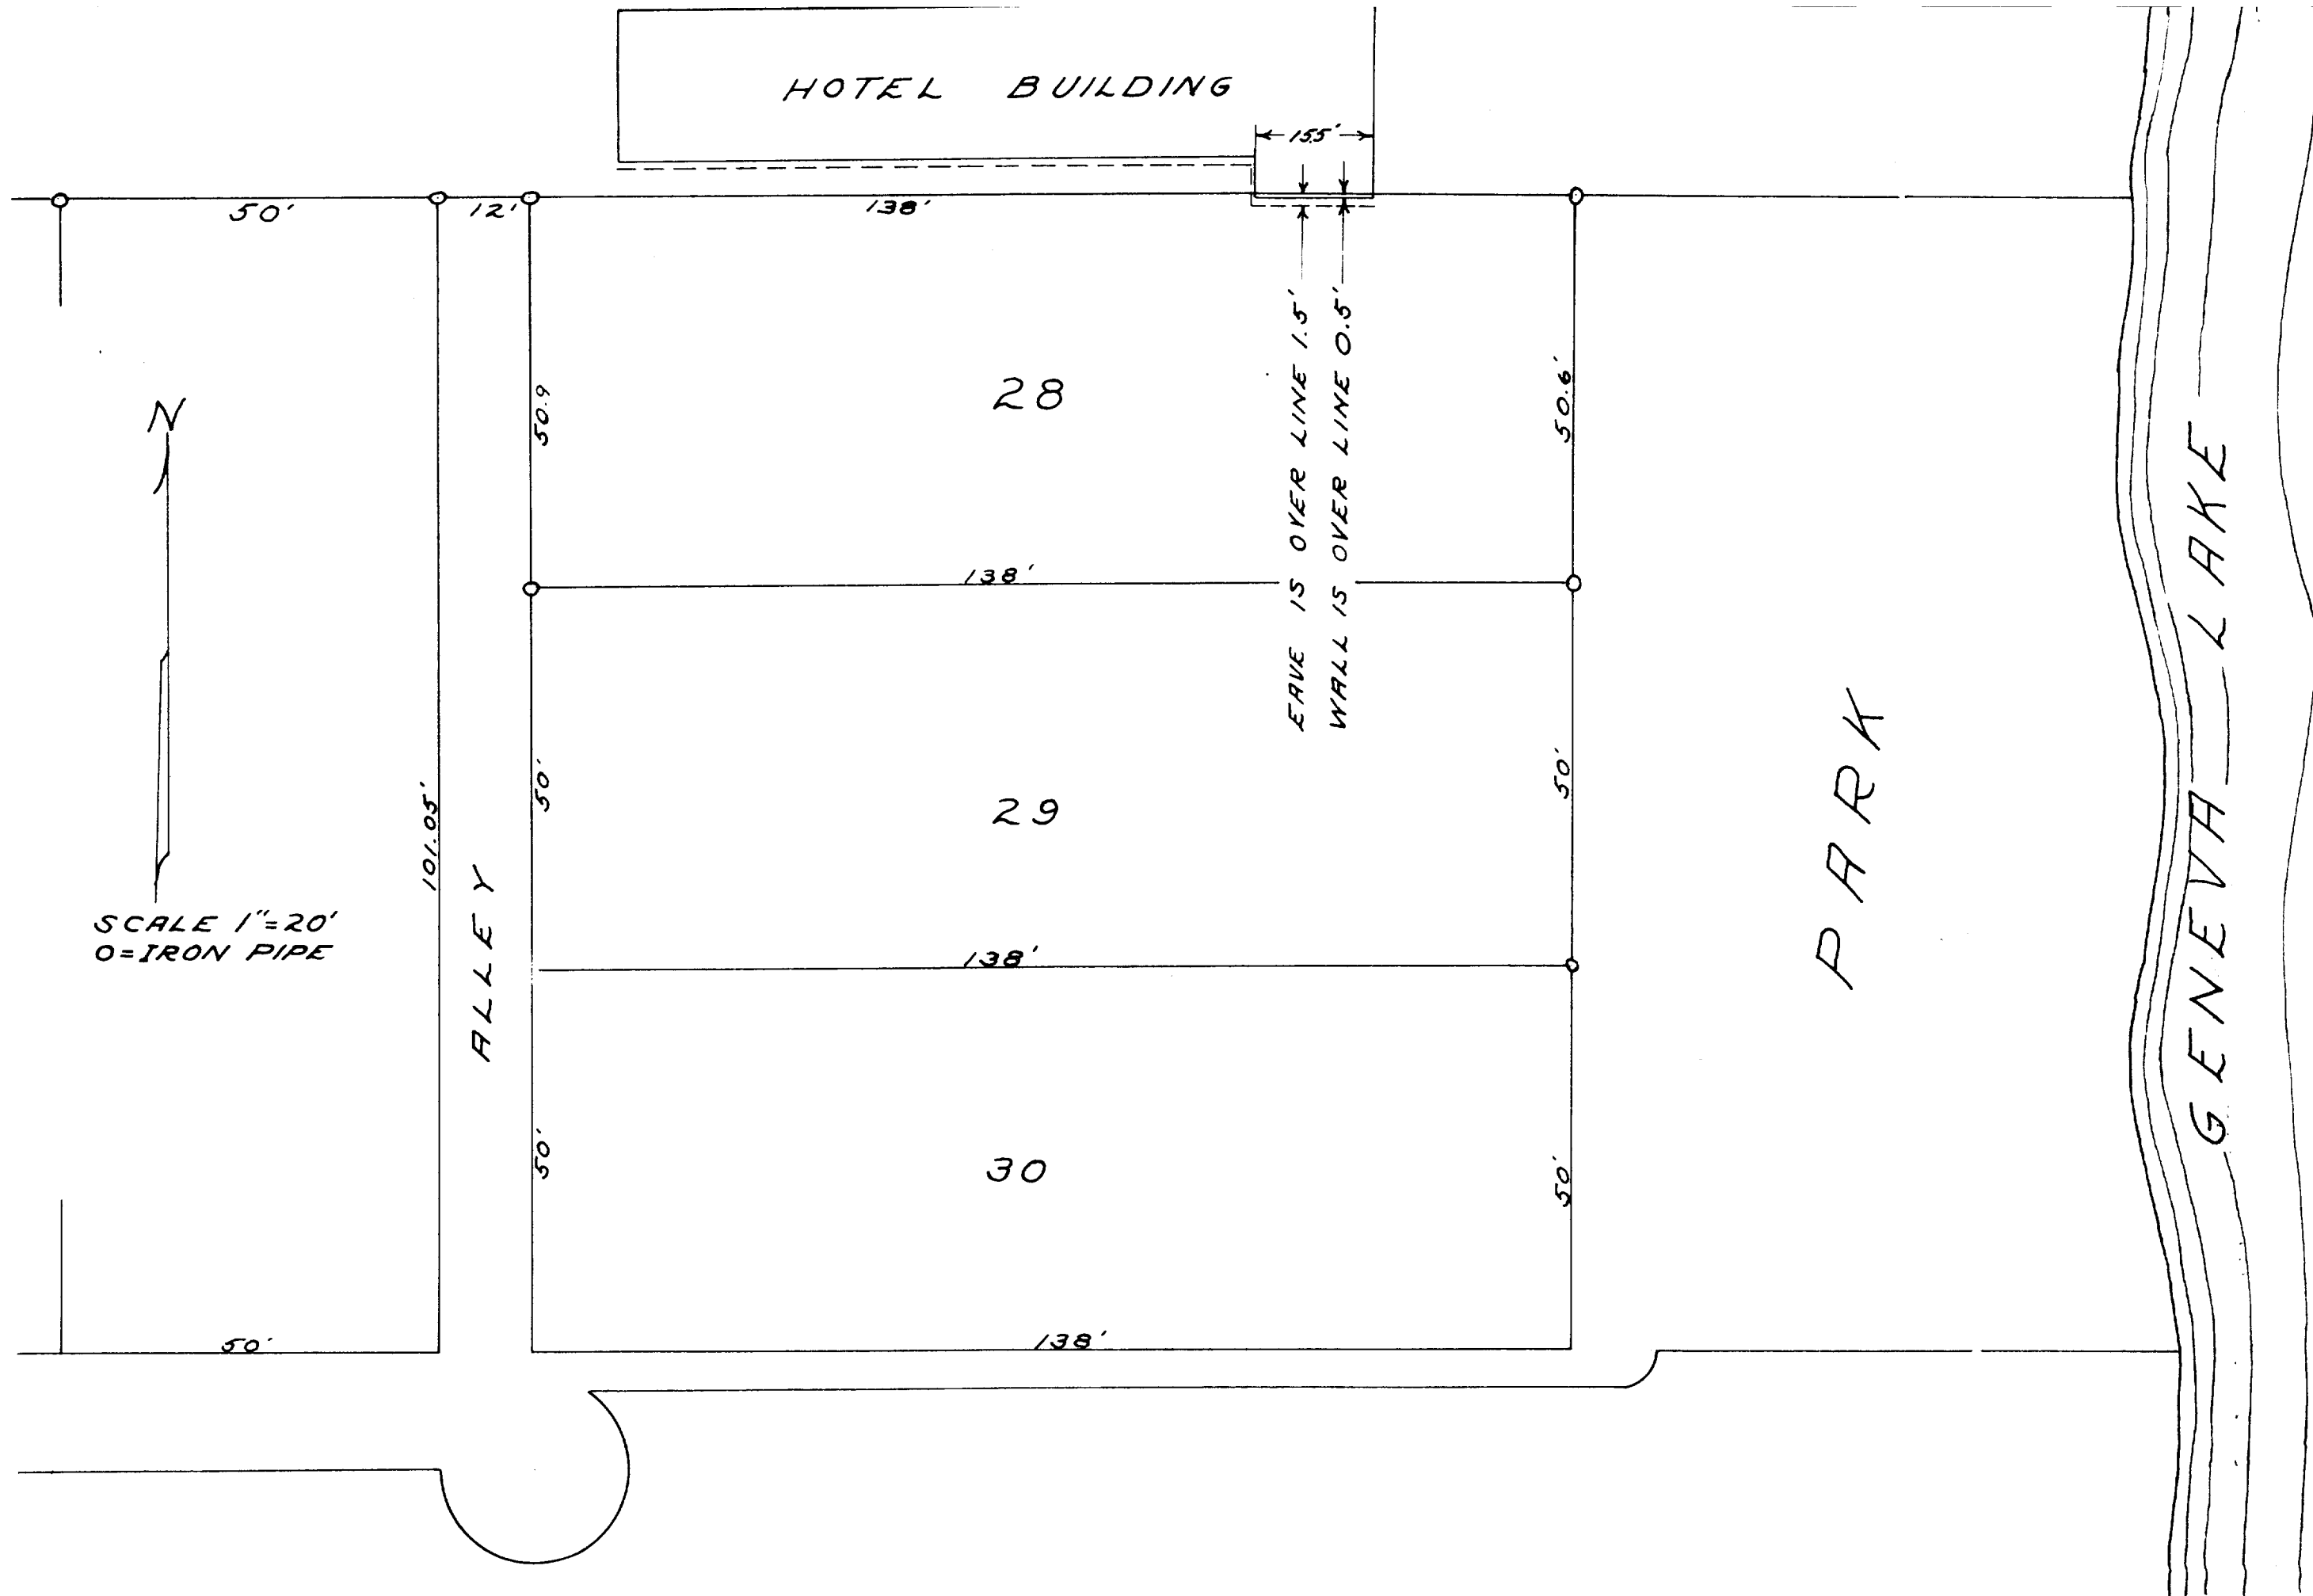

PLAT OF SURVEY OF LOT 28 OF SUMMER
HAVEN SUBDIVISION OF THE VILLAGE OF
WILLIAMS BAY, WALWORTH COUNTY, WISCONSIN.
NOVEMBER, 1949

Lloyd A. Jensen
SURVEYOR

11-70 J