


WALWORTH COUNTY  
SURVEYING & MAPPING  
LAKE GENEVA, WISCONSIN

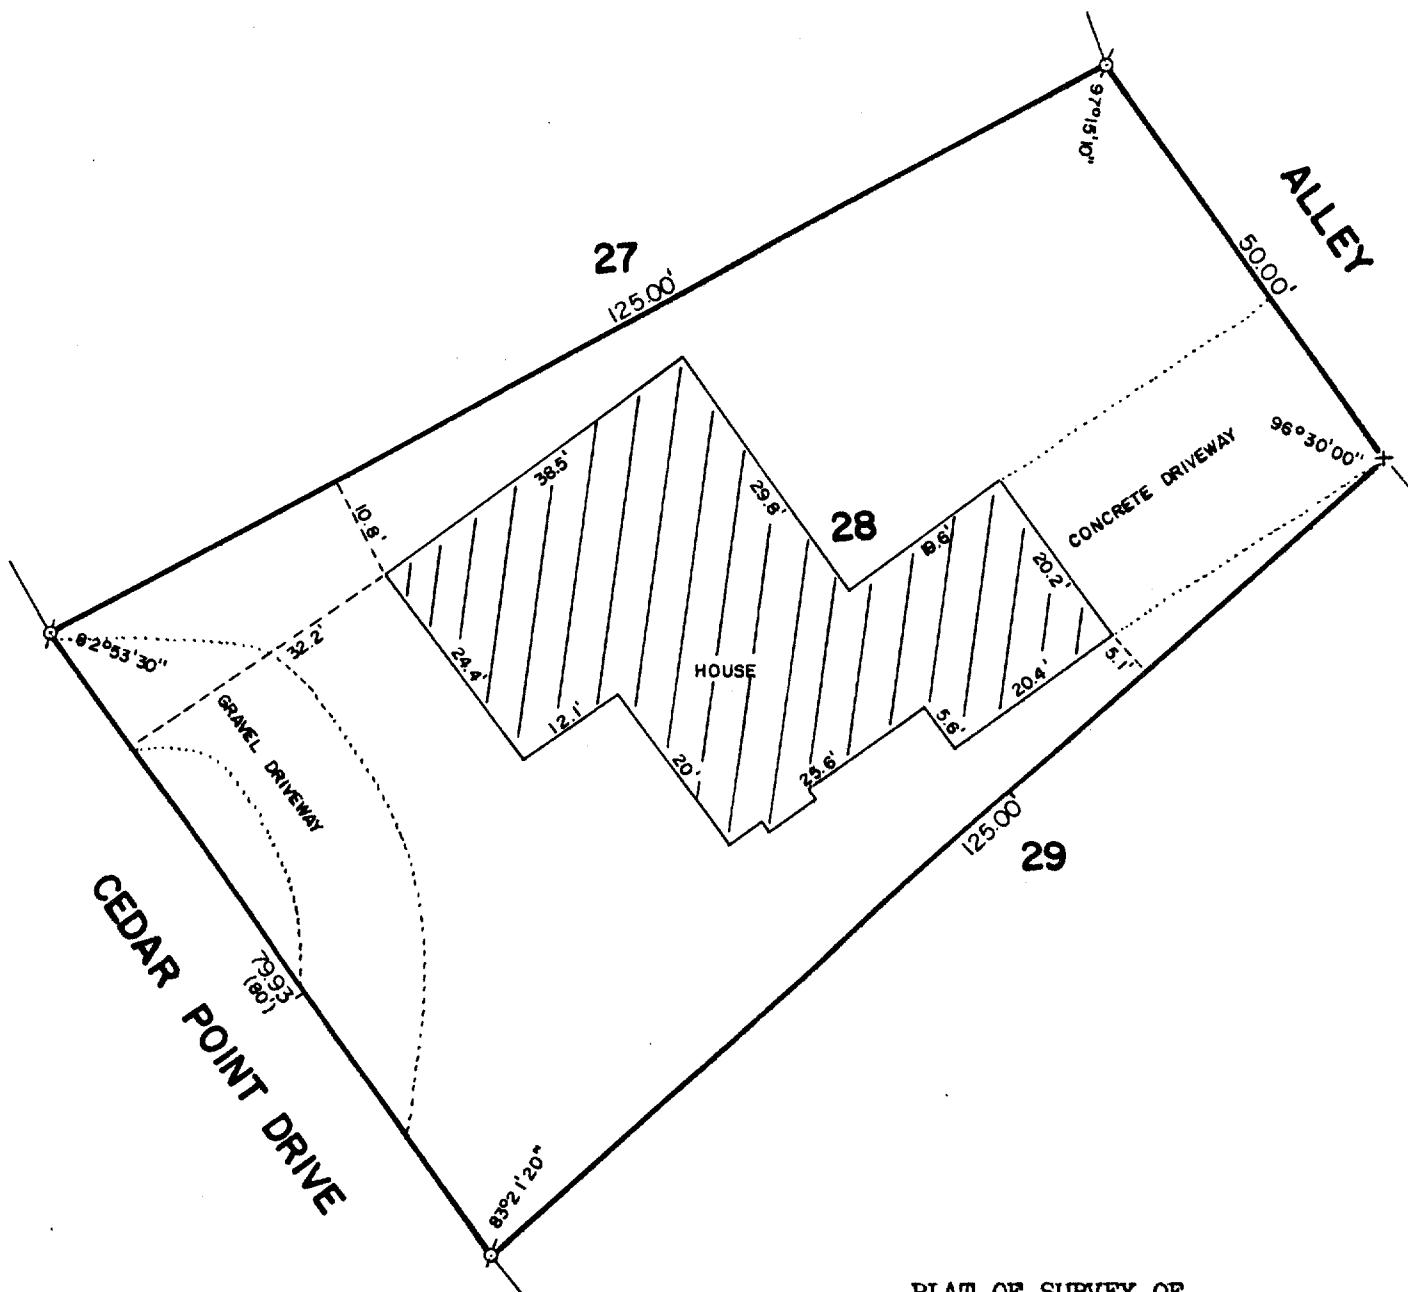


PLAT OF SURVEY OF

LOT 28 OF THE ORIGINAL PLAT OF CEDAR POINT PARK, LOCATED IN THE VILLAGE OF WILLIAMS BAY, WALWORTH COUNTY, WISCONSIN.

NOTE: CONCRETE DRIVEWAY EXTENDS 0.5 FEET SOUTHEASTERLY OF CUT CROSS.

ORDERED BY: GENEVA LAKEFRONT REALTY  
P. O. BOX 901  
WILLIAMS BAY, WISCONSIN

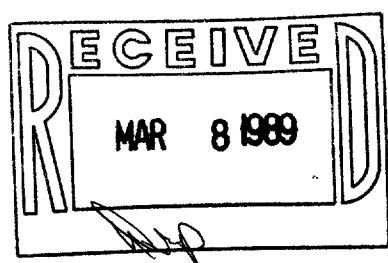

SCALE: 1"=20'

φ - IRON PIPE FOUND  
+ - CUT CROSS IN CONCRETE  
( ) - RECORDED AS

I HEREBY CERTIFY THAT I HAVE SURVEYED THE ABOVE DESCRIBED PROPERTY AND THAT THE ABOVE MAP IS A TRUE REPRESENTATION THEREOF AND SHOWS THE SIZE AND LOCATION OF THE PROPERTY, ITS EXTERIOR BOUNDARIES, THE LOCATION OF ALL VISIBLE STRUCTURES AND DIMENSIONS OF ALL PRINCIPAL BUILDINGS THEREON, BOUNDARY FENCES, APPARENT EASEMENTS AND ROADWAYS AND VISIBLE ENCROACHMENTS, IF ANY.

THIS SURVEY IS MADE FOR THE EXCLUSIVE USE OF THE PRESENT OWNERS OF THE PROPERTY, AND ALSO THOSE WHO PURCHASE, MORTGAGE, OR QUARANTEE THE TITLE THERETO WITHIN ONE (1) YEAR FROM DATE HEREOF.

Robert M. Baerenwald  
ROBERT M. BAERENWALD  
WISCONSIN REGISTERED LAND SURVEYOR, S-1508

Mar. 2 1989  
DATE JOB NO. 1802

NOTE: THIS IS NOT A CERTIFIED COPY UNLESS SEALED.