


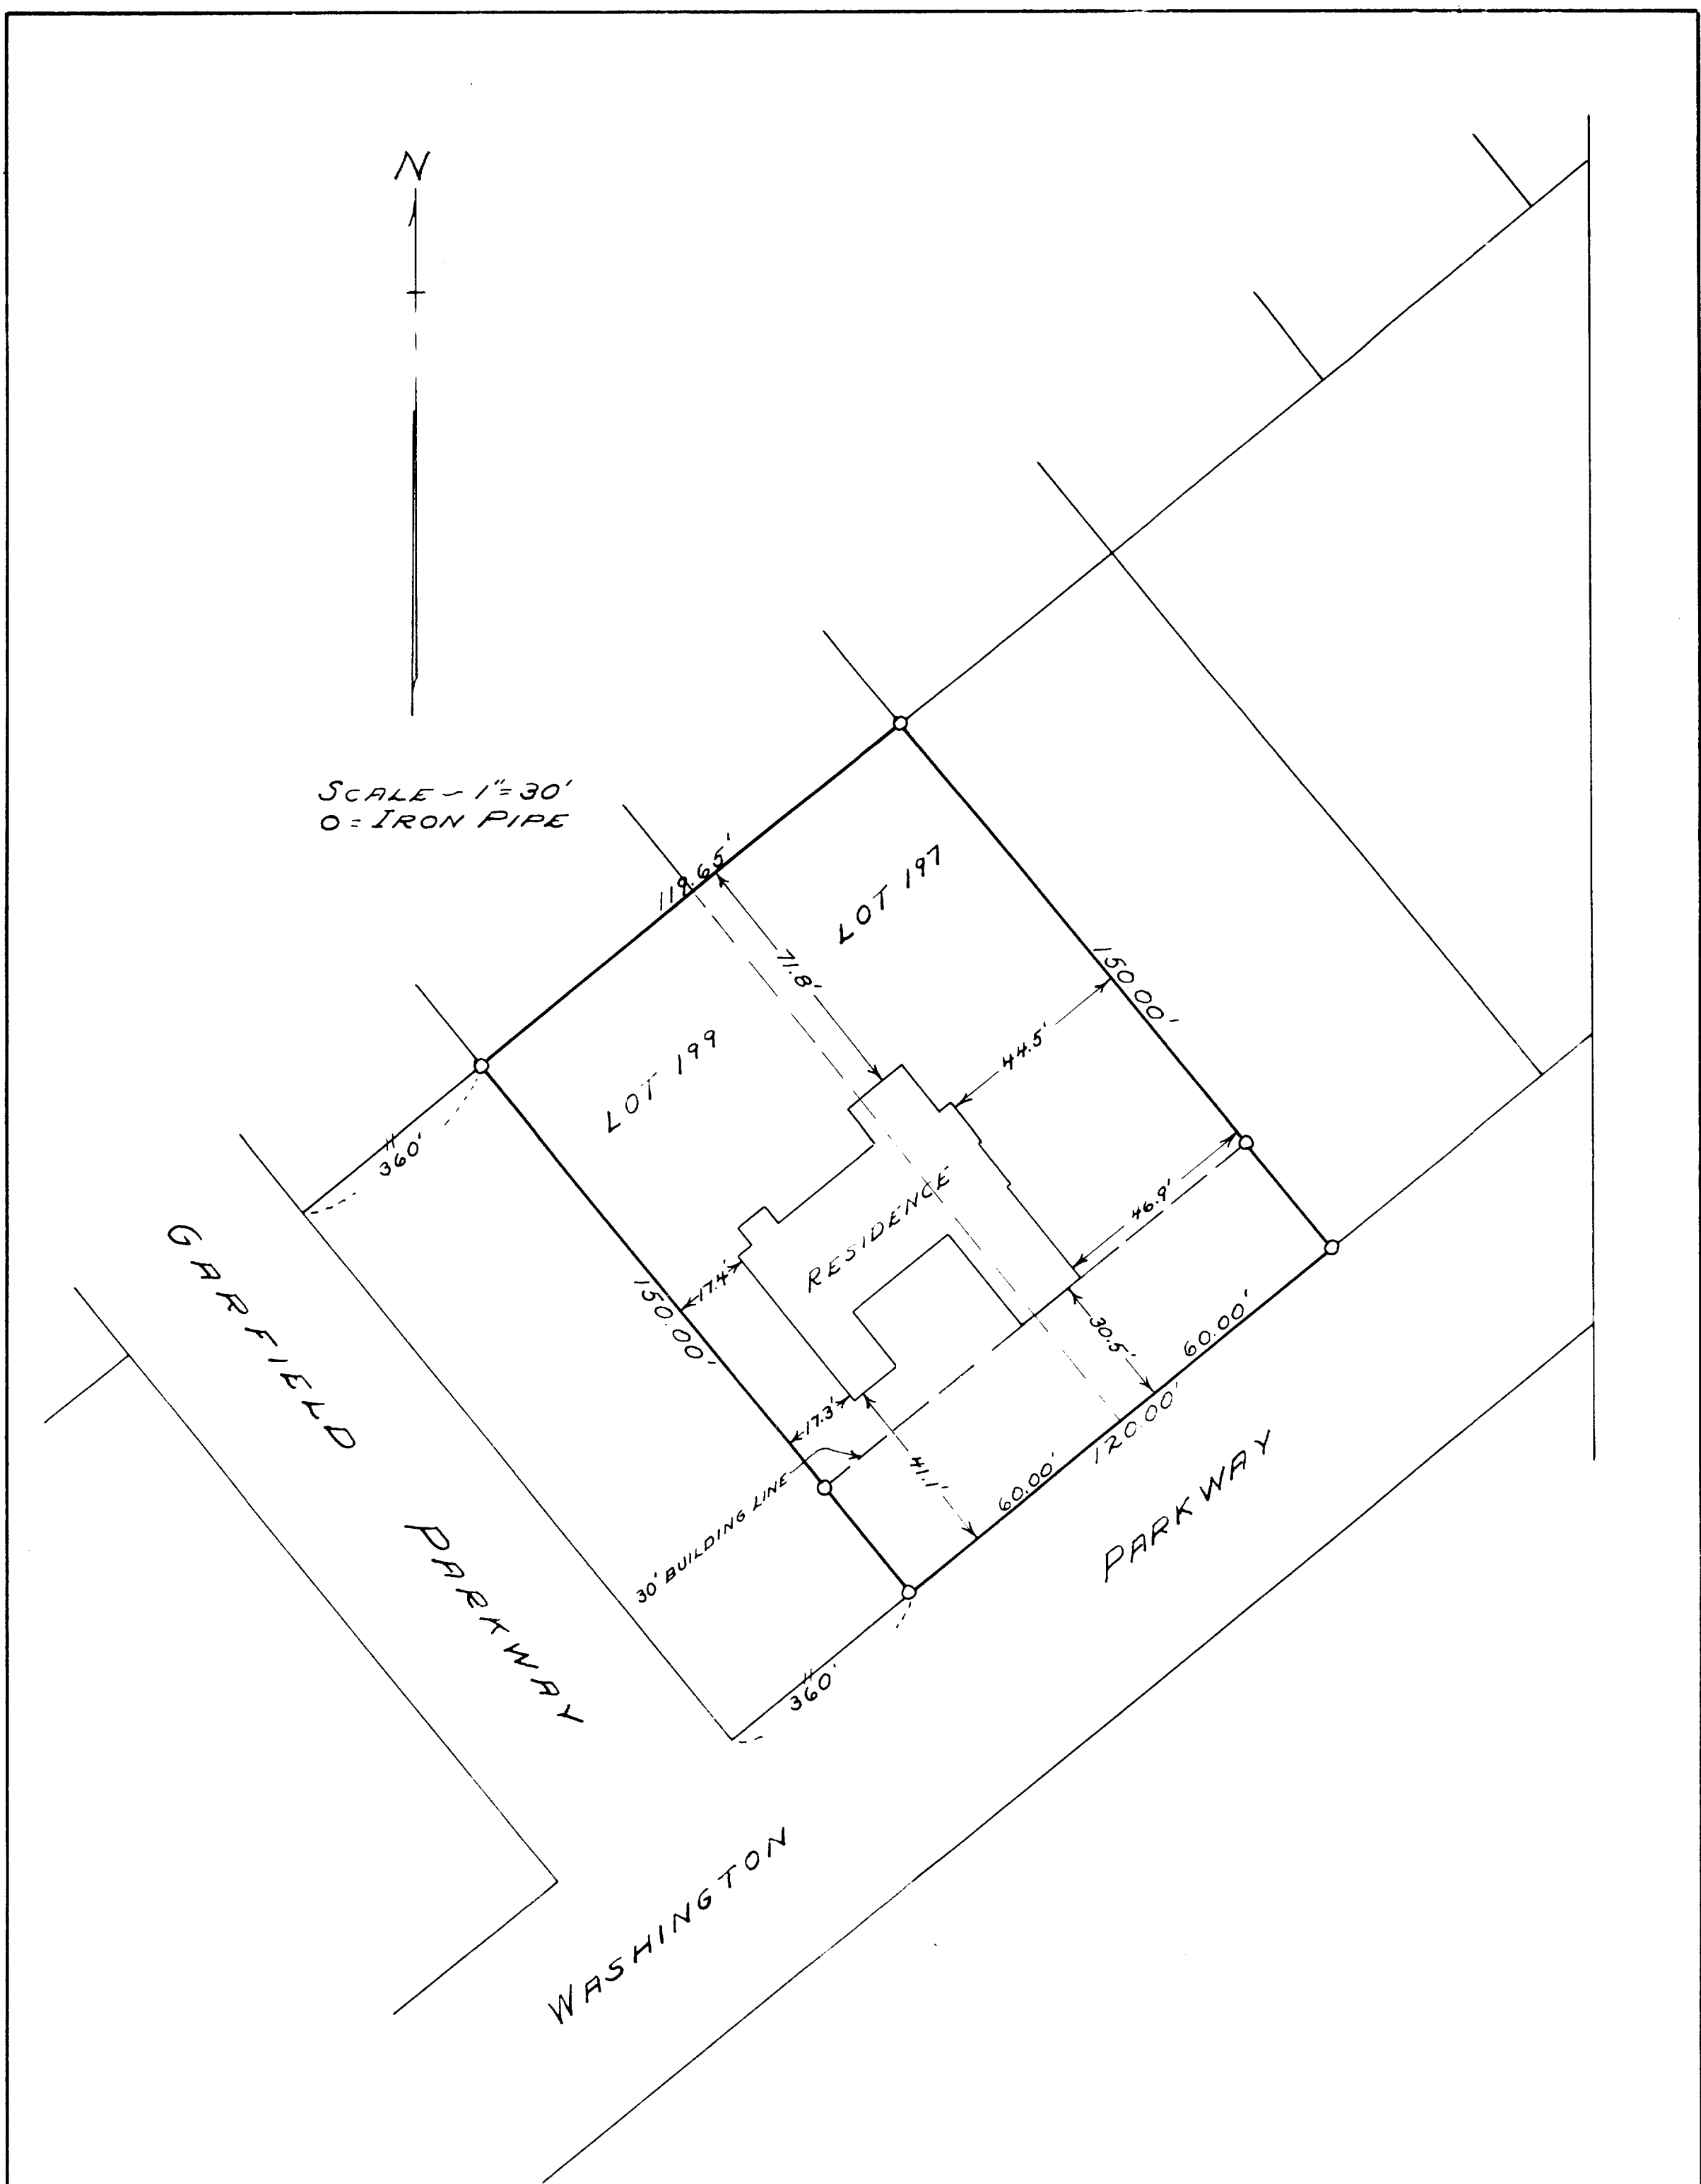

I HEREBY CERTIFY THAT I HAVE SURVEYED LOTS 197 & 199 OF THE ORIGINAL CEDAR POINT PARK SUBDIVISION, LOCATED IN THE VILLAGE OF WILLIAMS BAY, WALWORTH COUNTY, WISCONSIN, AND THAT THE ABOVE PLAT IS A CORRECT REPRESENTATION THEREOF, AND THAT ALL BUILDINGS ARE CORRECTLY SHOWN ON THIS PLAT. I ALSO CERTIFY THAT THE BUILDING HAS BEEN ERECTED IN ACCORDANCE WITH THE ZONING ORDINANCE OF WILLIAMS BAY AND ANY DEED RESTRICTIONS WHICH APPLY. JANUARY 19, 1950

H. E. Johnson
SURVEYOR