


N



SCALE 1"=20'
O IRON PIPE
● CONC. MONU.

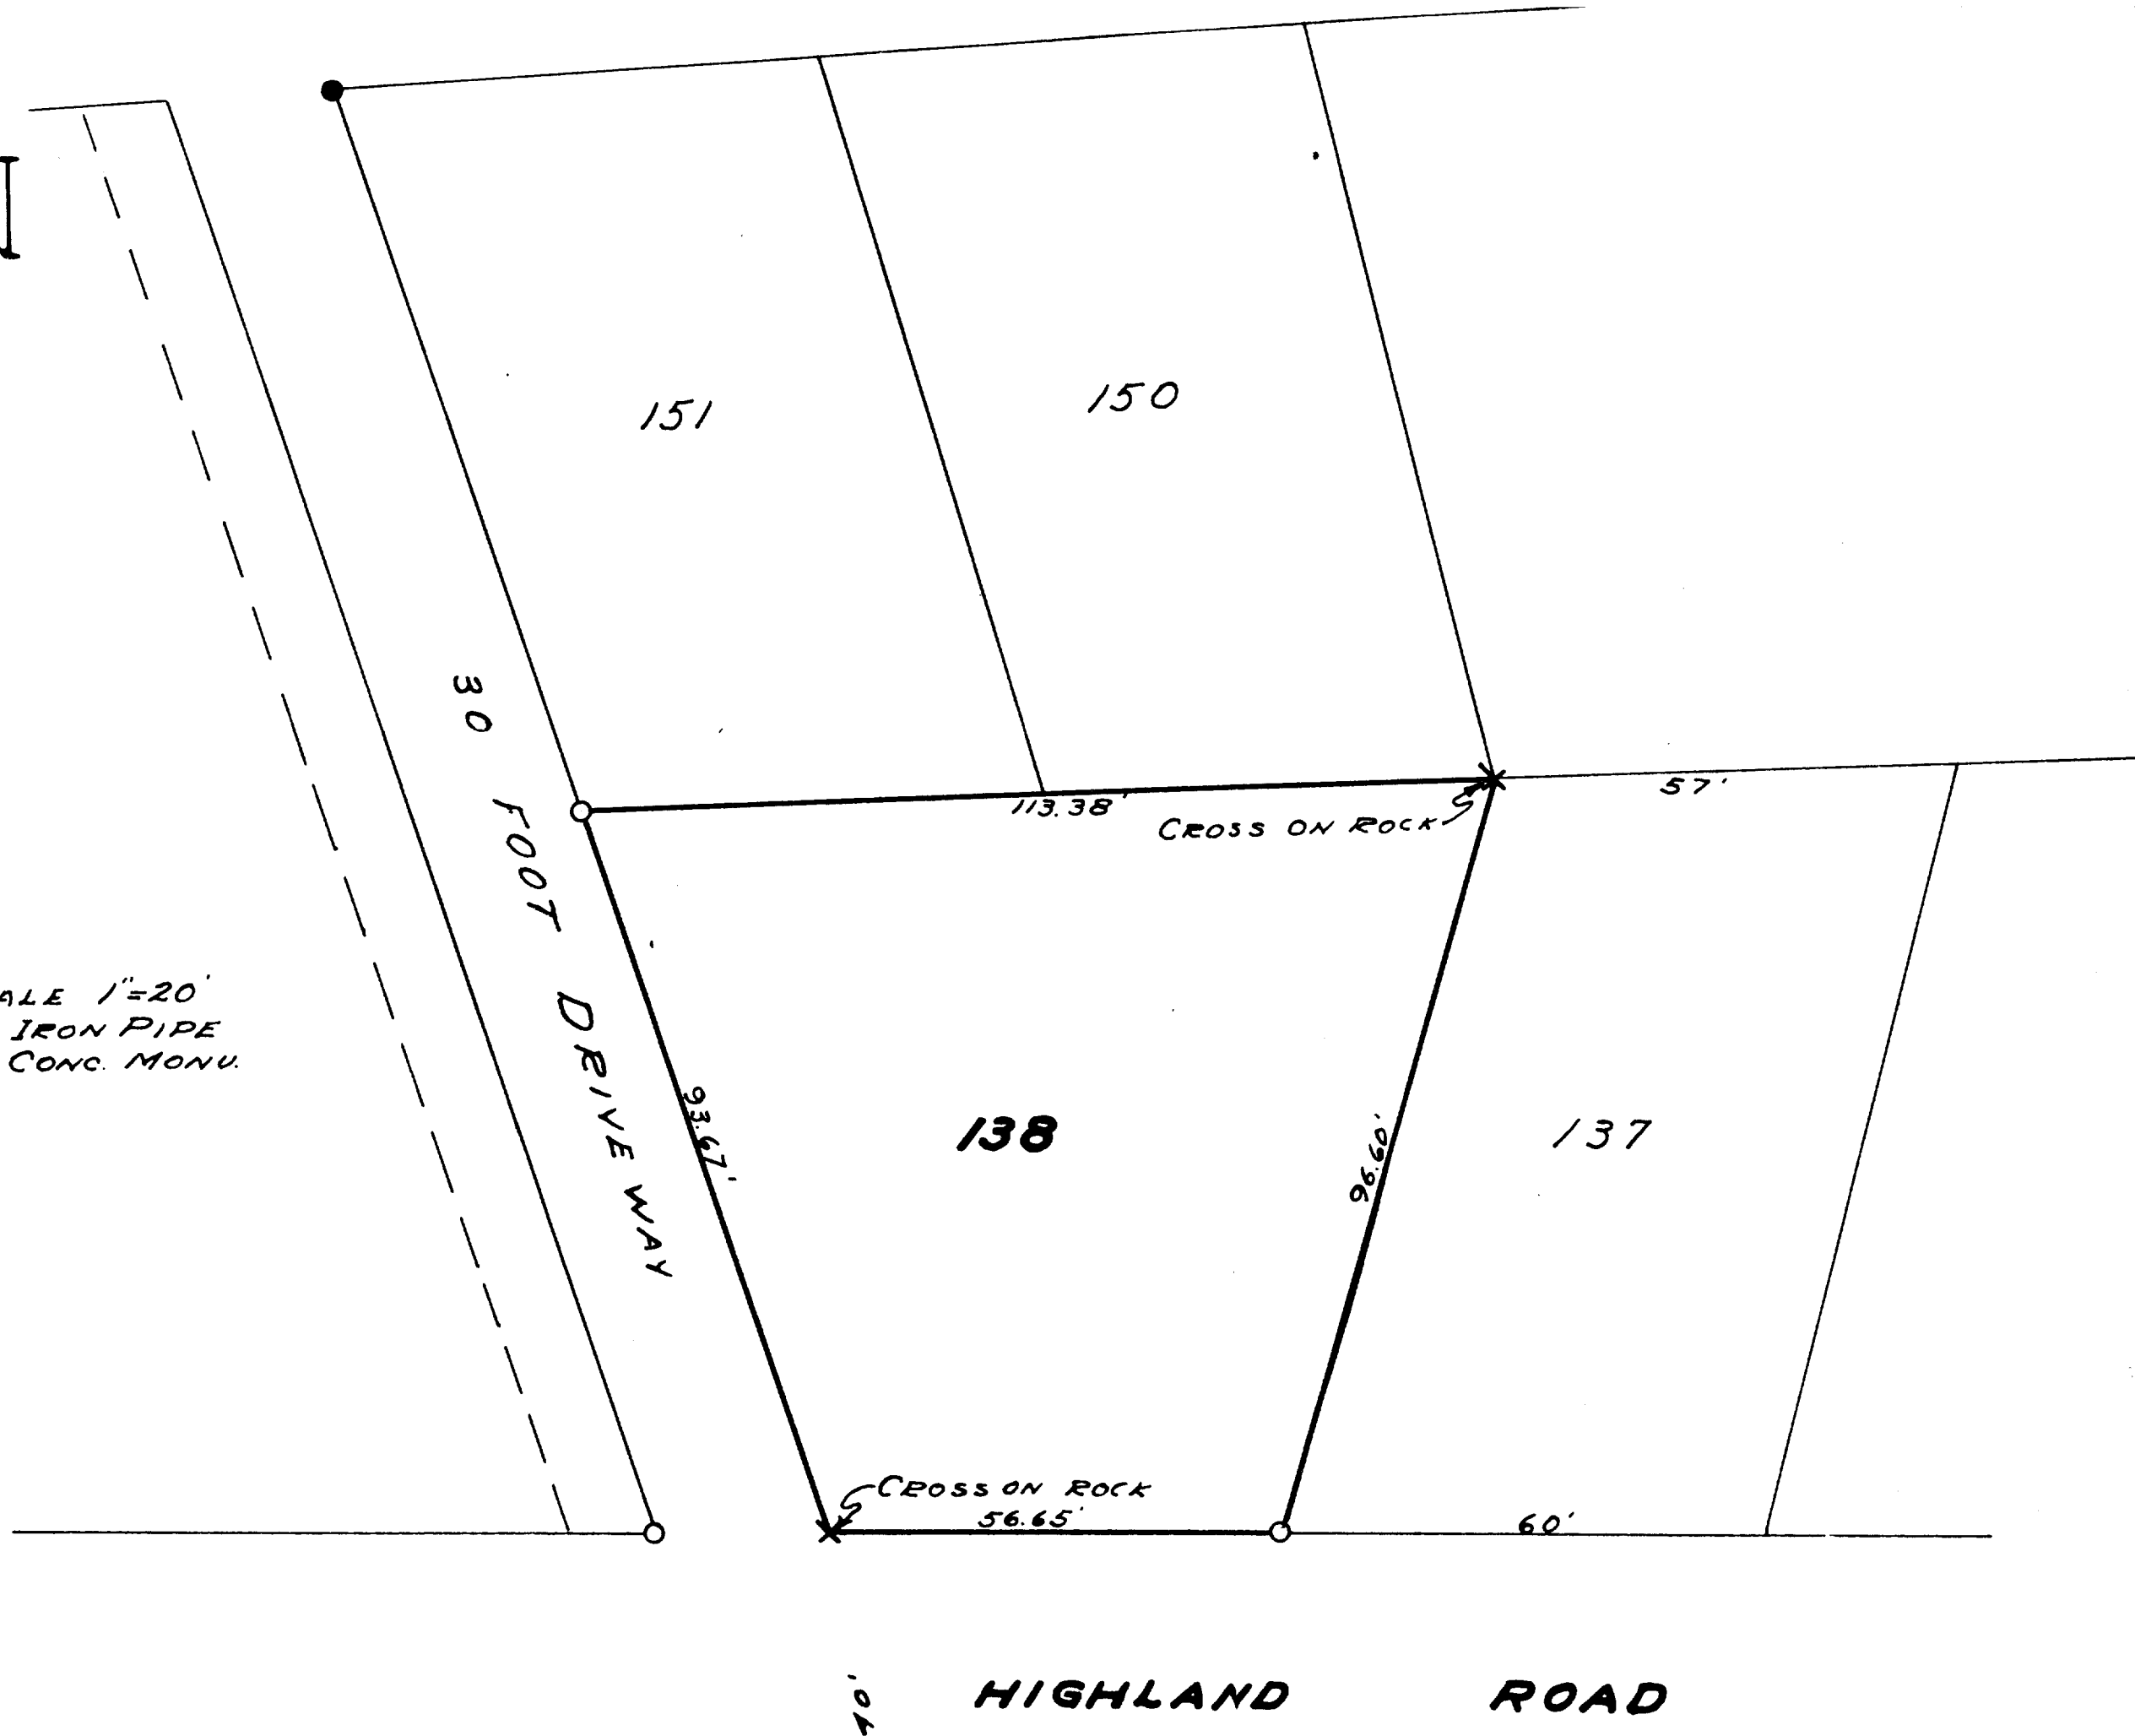

HIGHLAND ROAD

PLAT of SURVEY
LOT 138 OF THE SECOND ADDITION TO
CEDAR POINT PARK SUBDIVISION,
WILLIAMS BAY, WISCONSIN

H.E. Johnson

11-74