


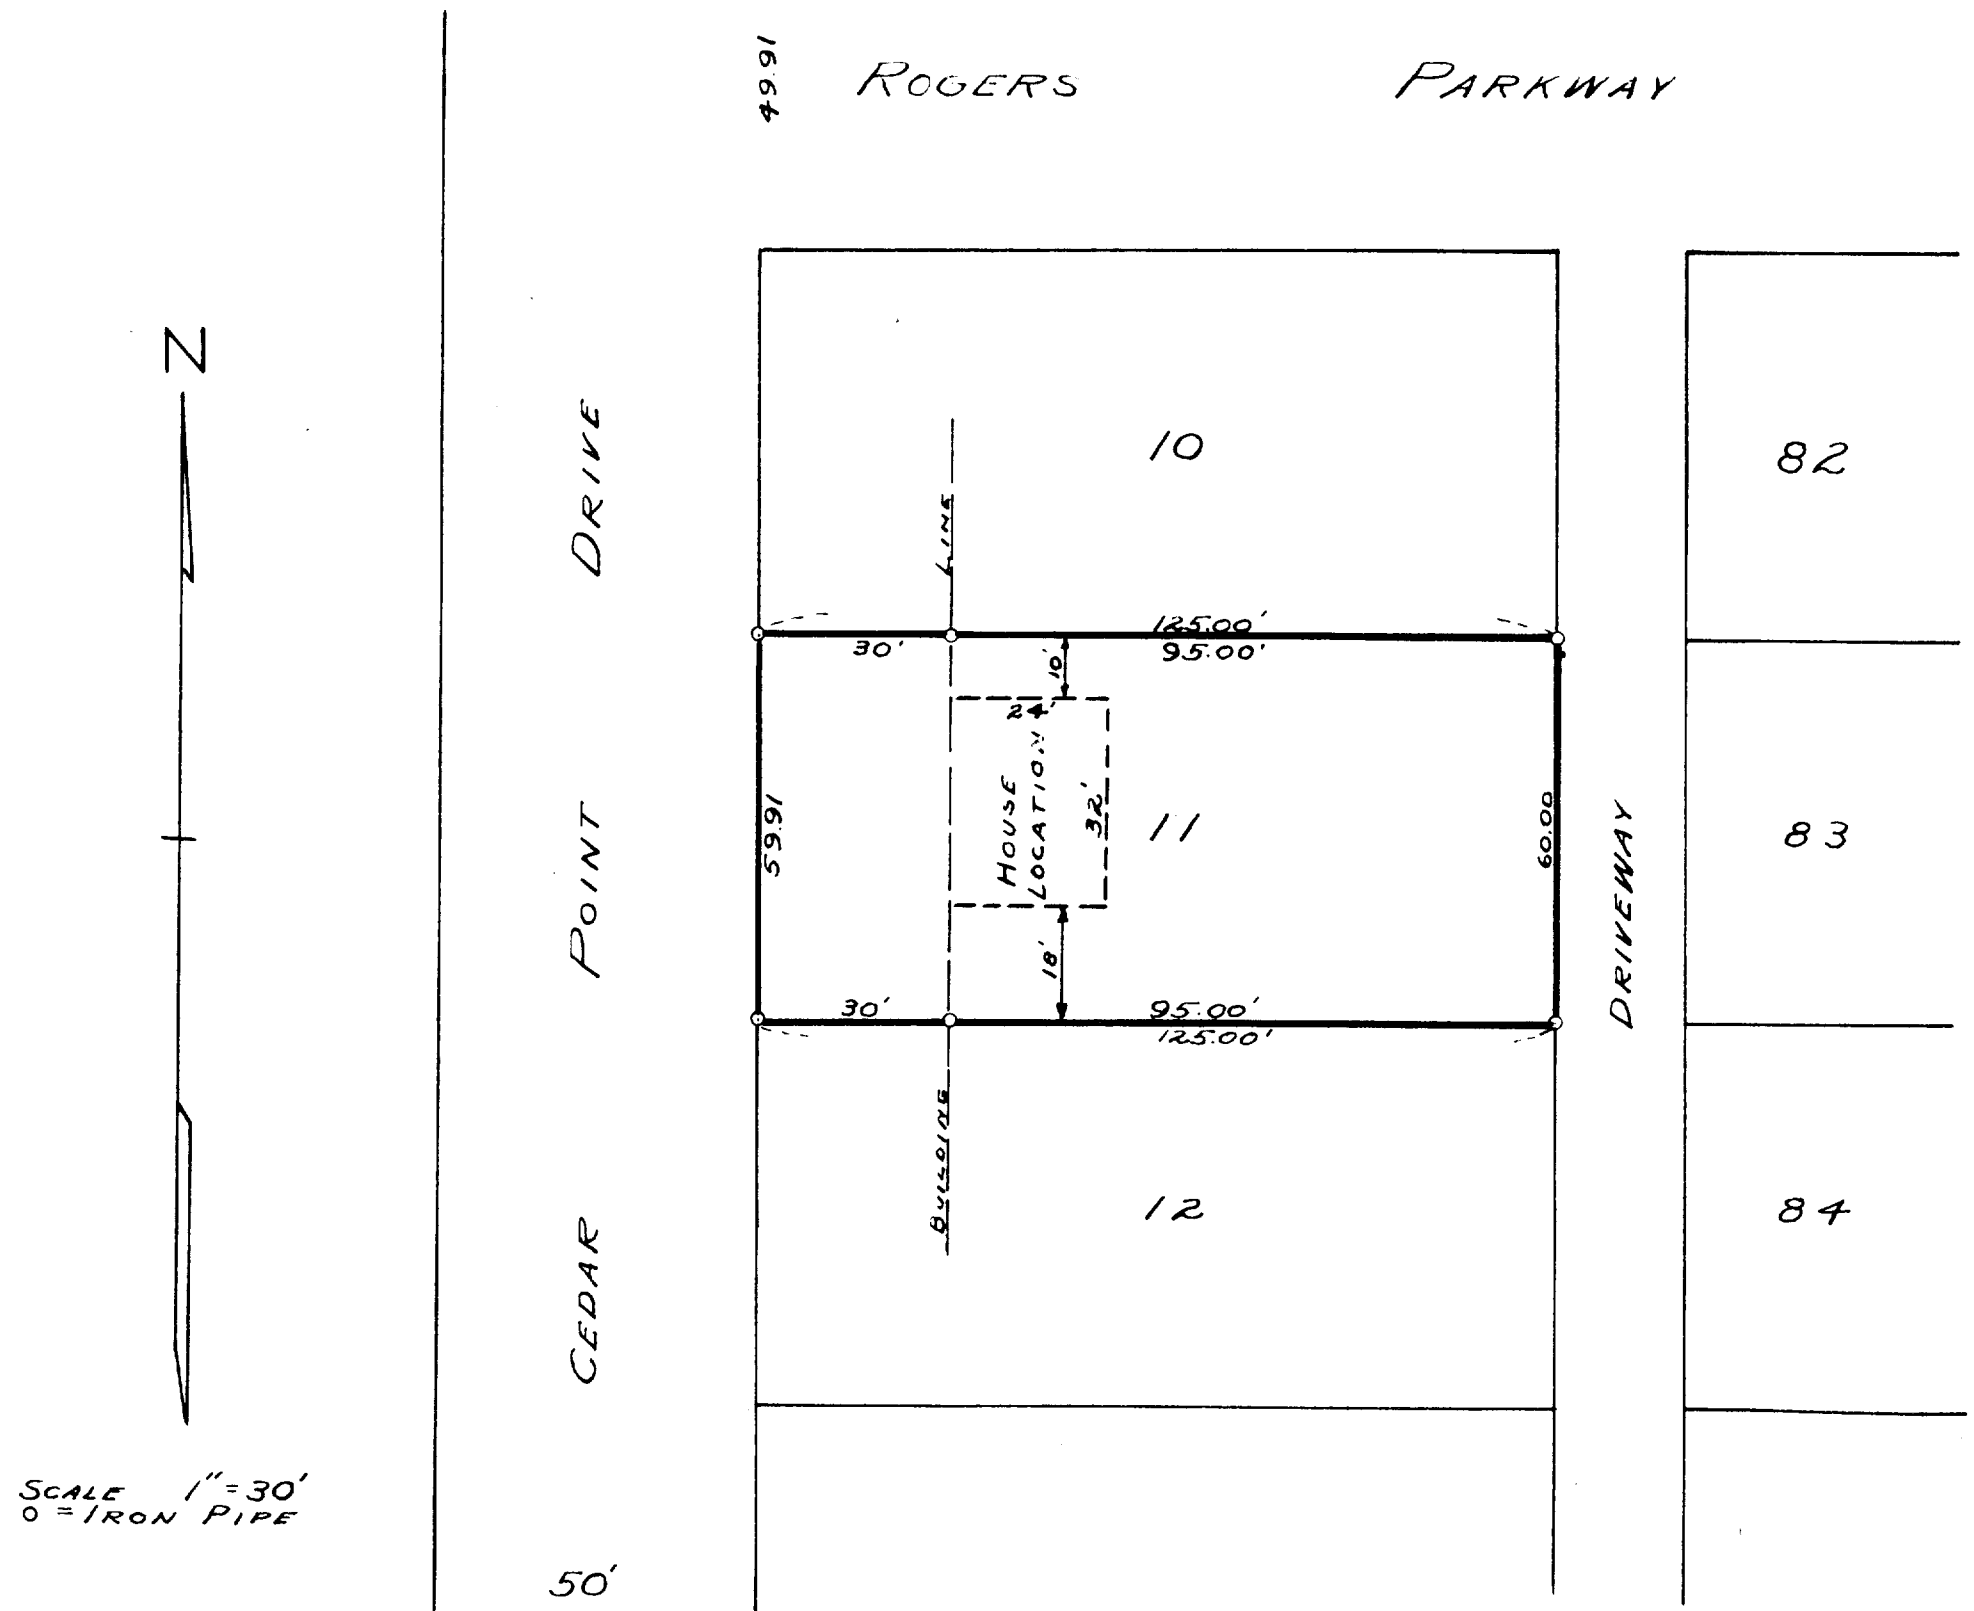

SCALE 1"=30'
 O=IRON PIPE

PLAT OF SURVEY OF LOT 11 OF THE ORIGINAL PLAT OF CEDAR POINT PARK
 IN THE VILLAGE OF WILLIAMS BAY, WALWORTH COUNTY, WISCONSIN

APRIL 29, 1949

COUNTY SURVEYOR

WCP 9