


HAROLD H. KOLB
 REGISTERED PROFESSIONAL LAND SURVEYOR
 LAKE GENEVA, WISCONSIN

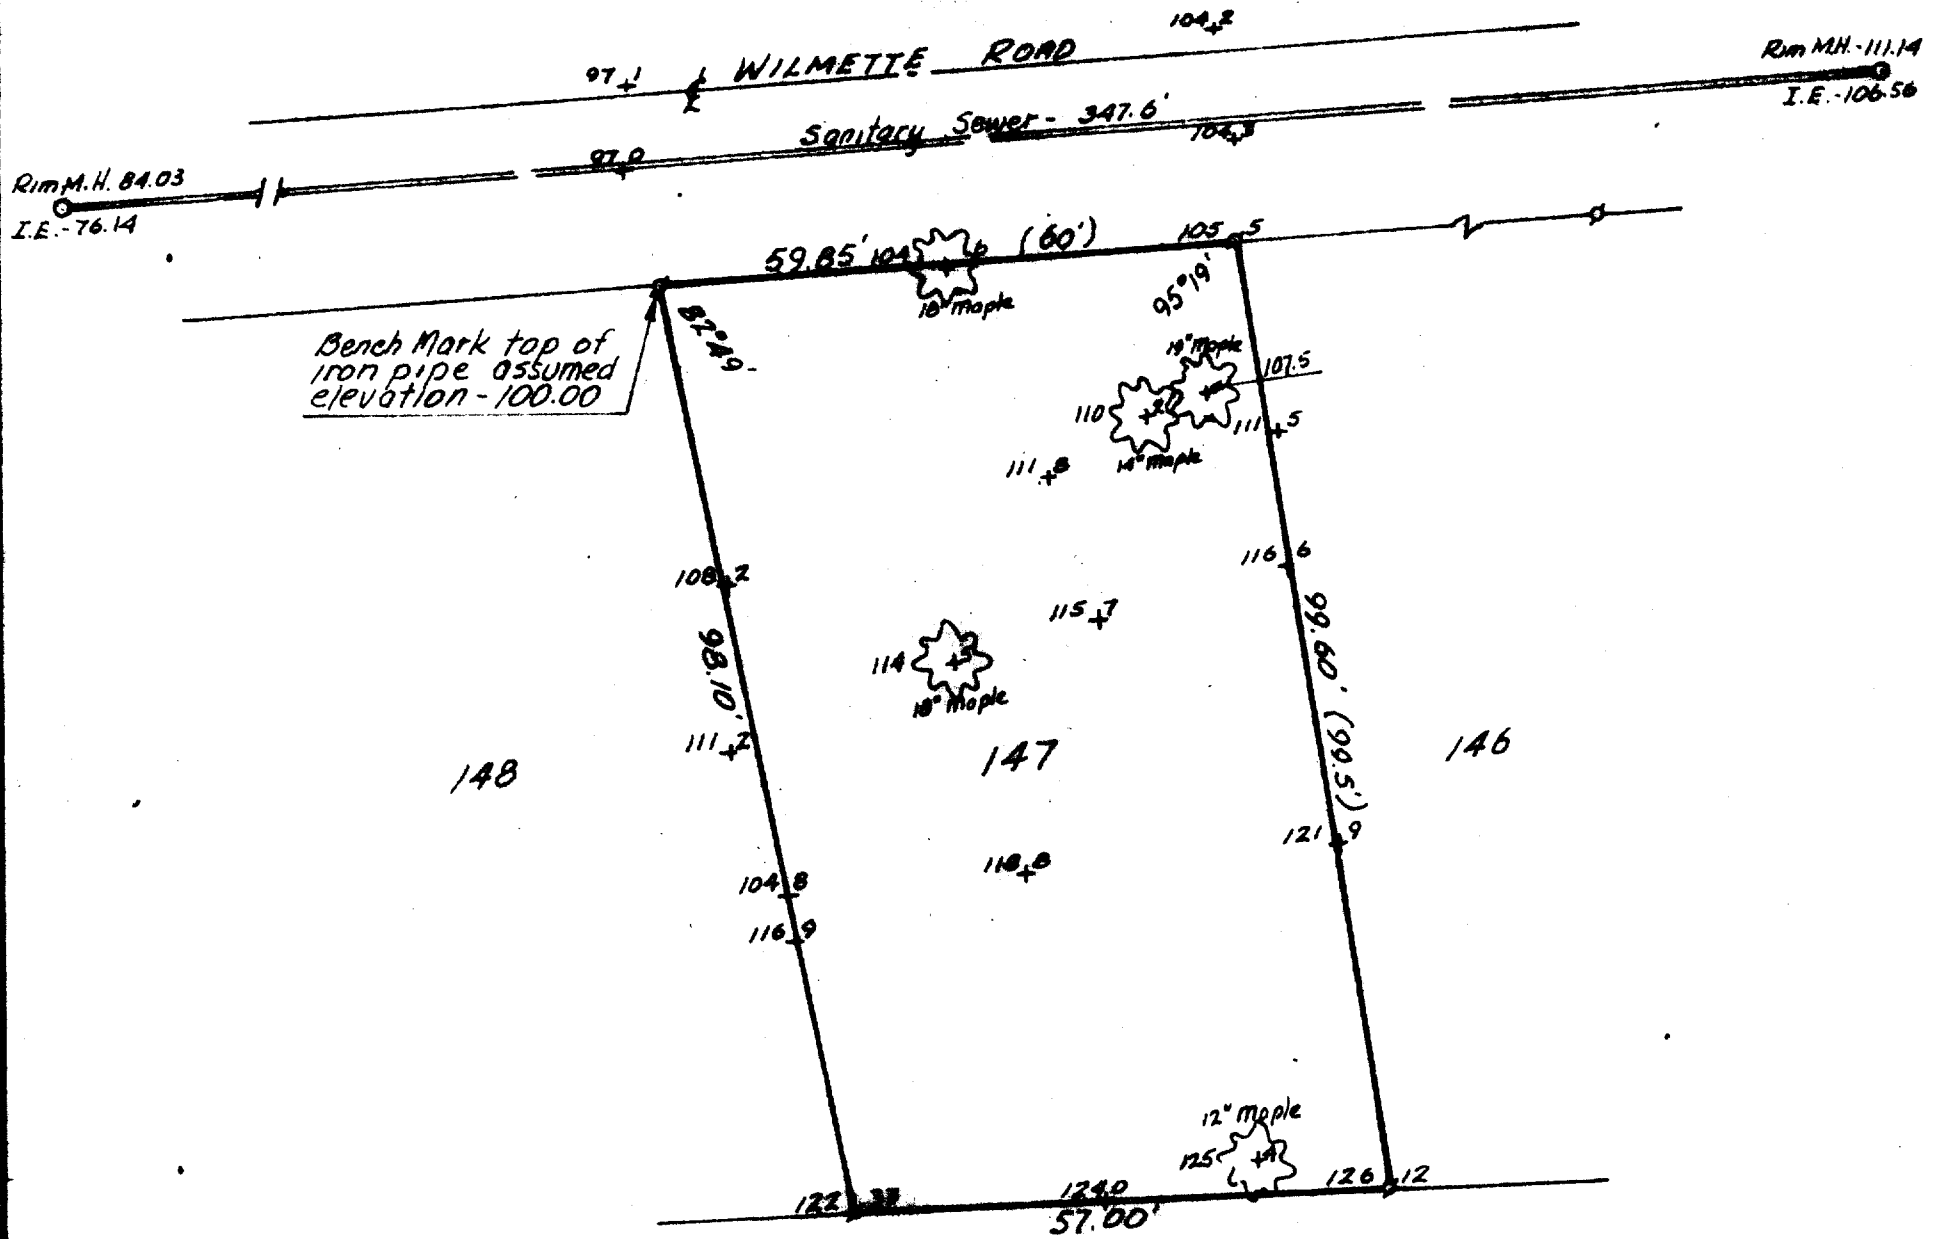

TOPOGRAPHIC SURVEY OF

Lot 147, Cedar Point Park, 2nd Addition,
 Village of Williams Bay, Walworth County,
 Wisconsin


N



Scale - 1" = 20'

LEGEND

- IRON PIPE FOUND
- — IRON PIPE PLACED
- — CONCRETE MONUMENT
- ✕ — SPIKE
- () — Platted as
- 100.4 — Elevation
- MH — Man Hole

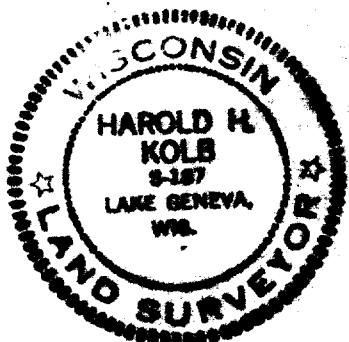

I, HAROLD H. KOLB, DO HEREBY CERTIFY THAT I HAVE
 SURVEYED THE PROPERTY HEREON DESCRIBED ACCORDING
 TO THE OFFICIAL RECORDS, AND THAT THE PLAT HEREON
 IS A CORRECT REPRESENTATION OF THE LOT LINES.

Harold H. Kolb

HAROLD H. KOLB
 WISCONSIN REGISTERED LAND SURVEYOR, 8-187
 DATE Mar. 4, 1971