


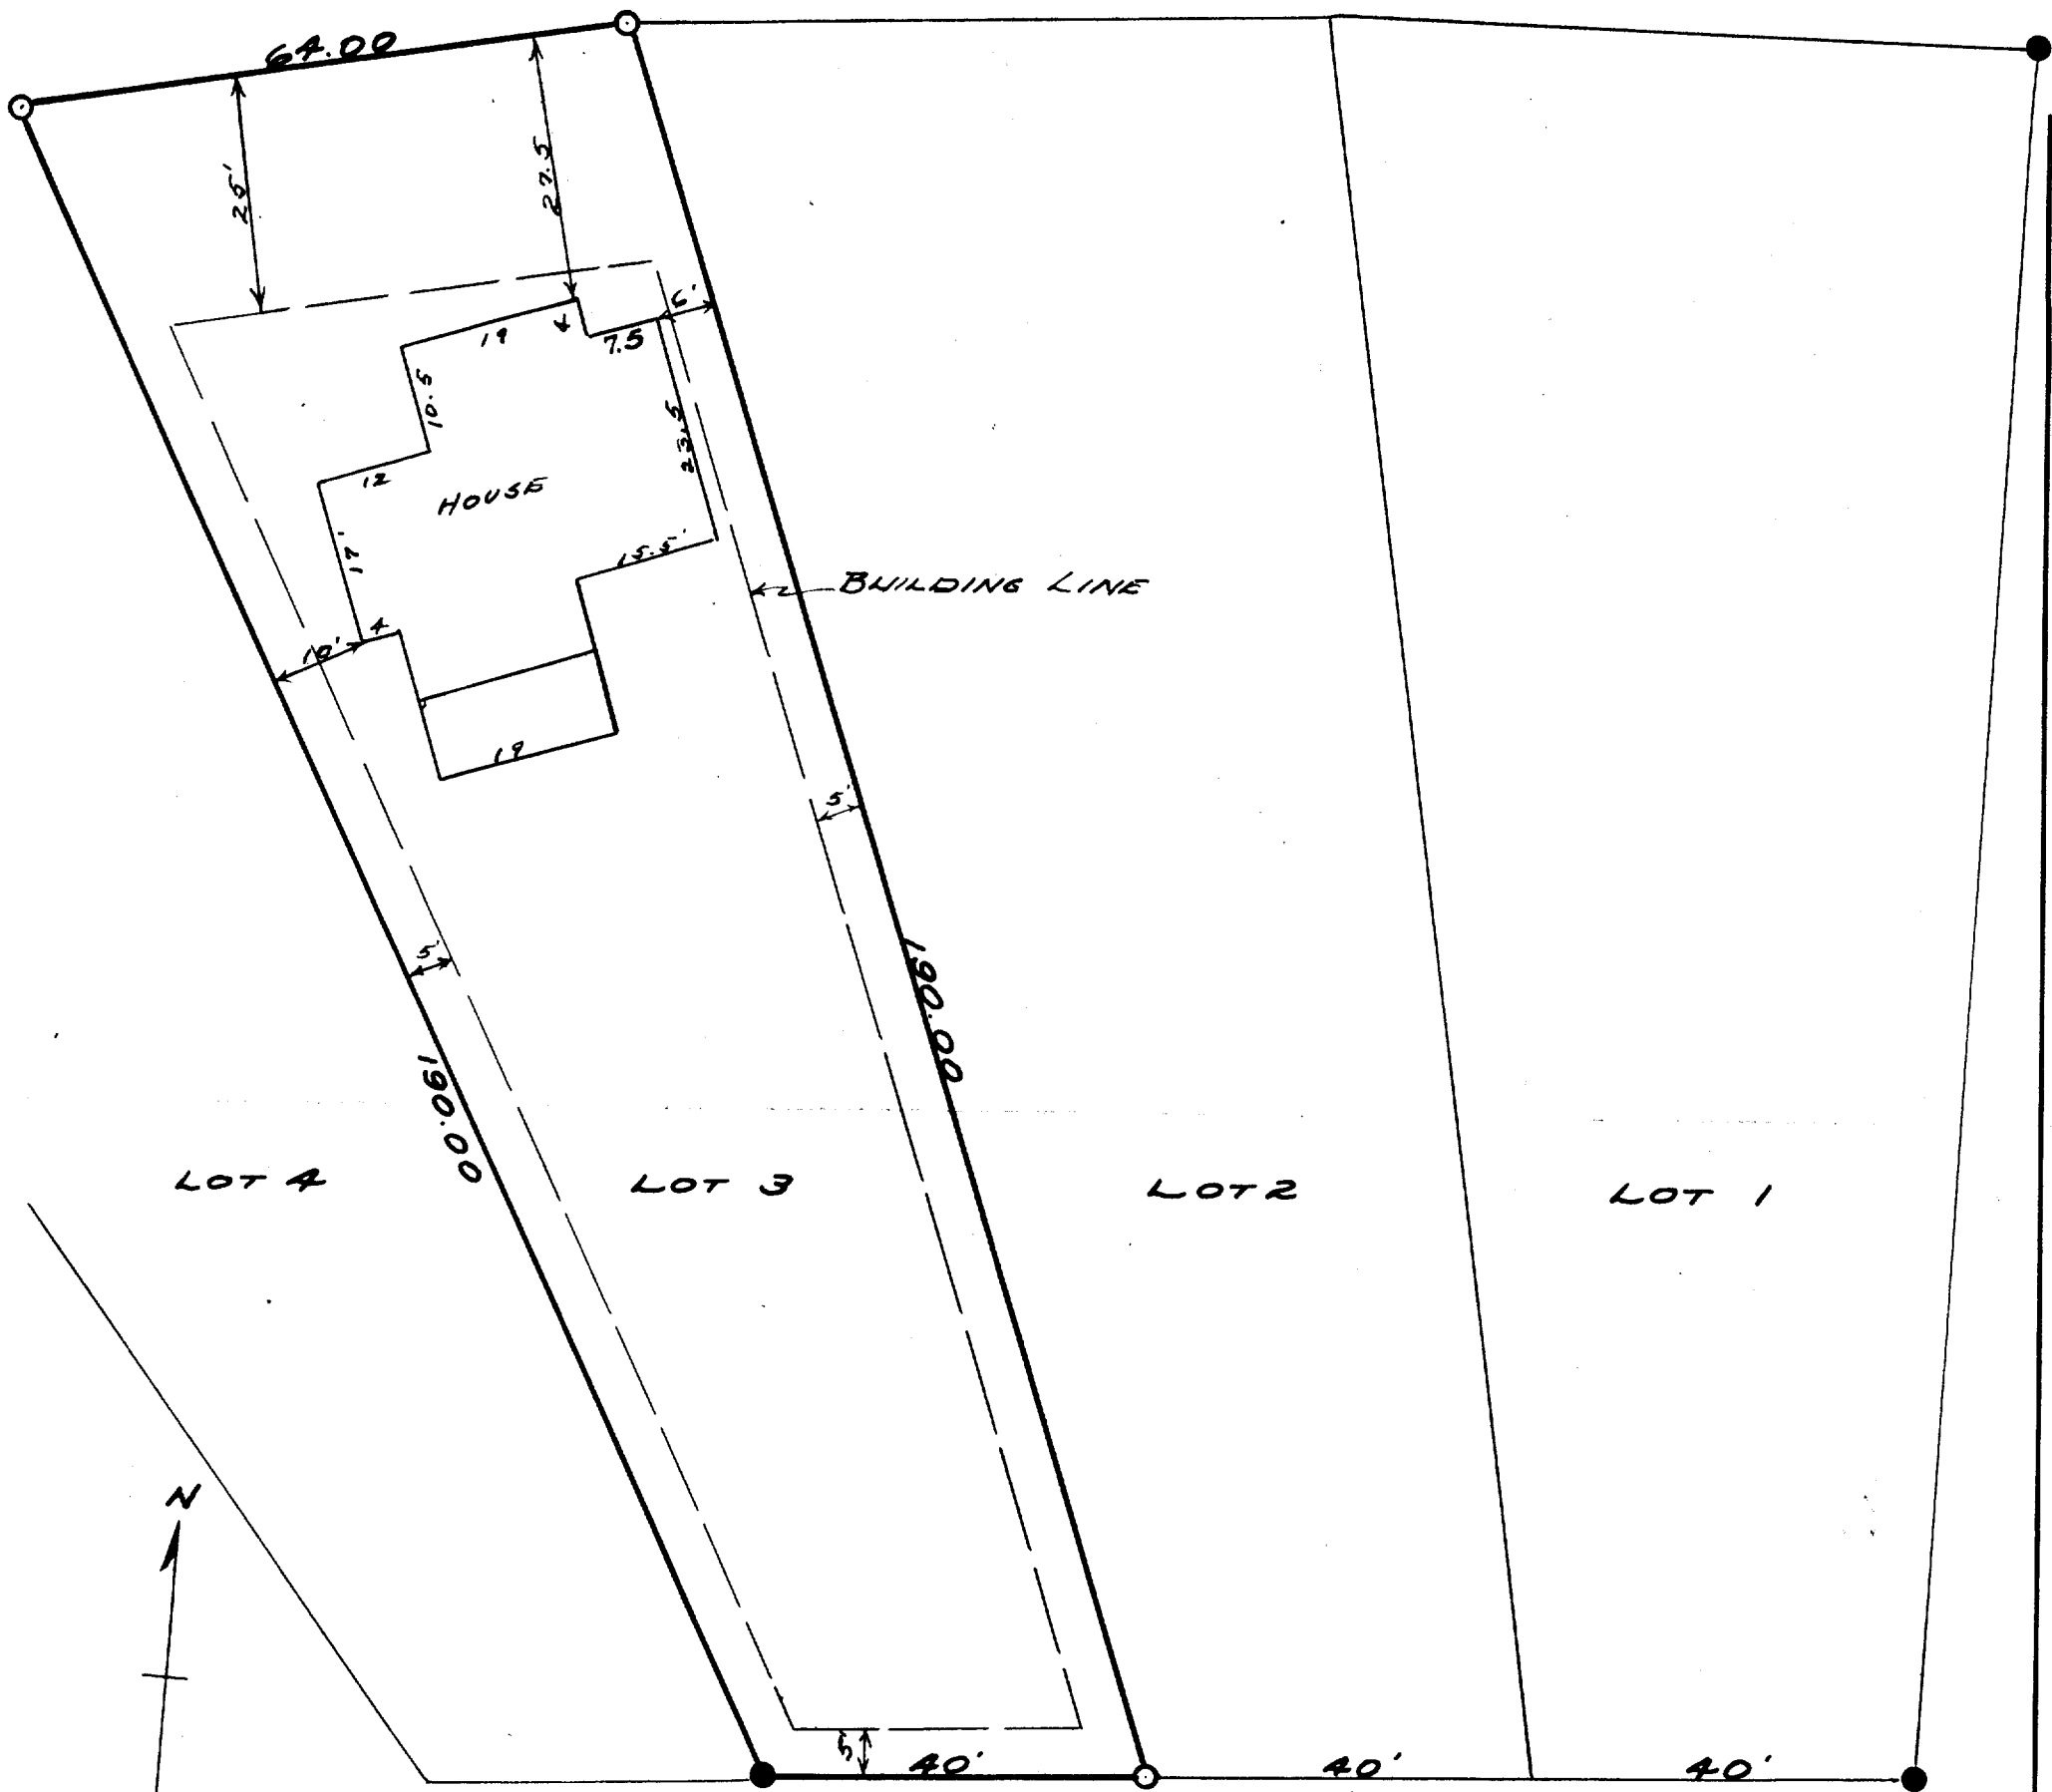

SCALE-1"=20'
 ○ = IRON PIPE
 ● = CONC. MON.

PLAT OF SURVEY OF LOT 3 OF THE
 FIRST ADDITION TO CEDAR POINT PARK,
 WILLIAMS BAY, WALWORTH COUNTY, WISCONSIN

JUNE 21, 1939

Lloyd J. Jensen
 COUNTY SURVEYOR

Sub 21-2