

CLEVELAND PARKWAY


N



SCALE ~ 1" = 20'
O = IRON PIPE

PARKWAY

LINCOLN

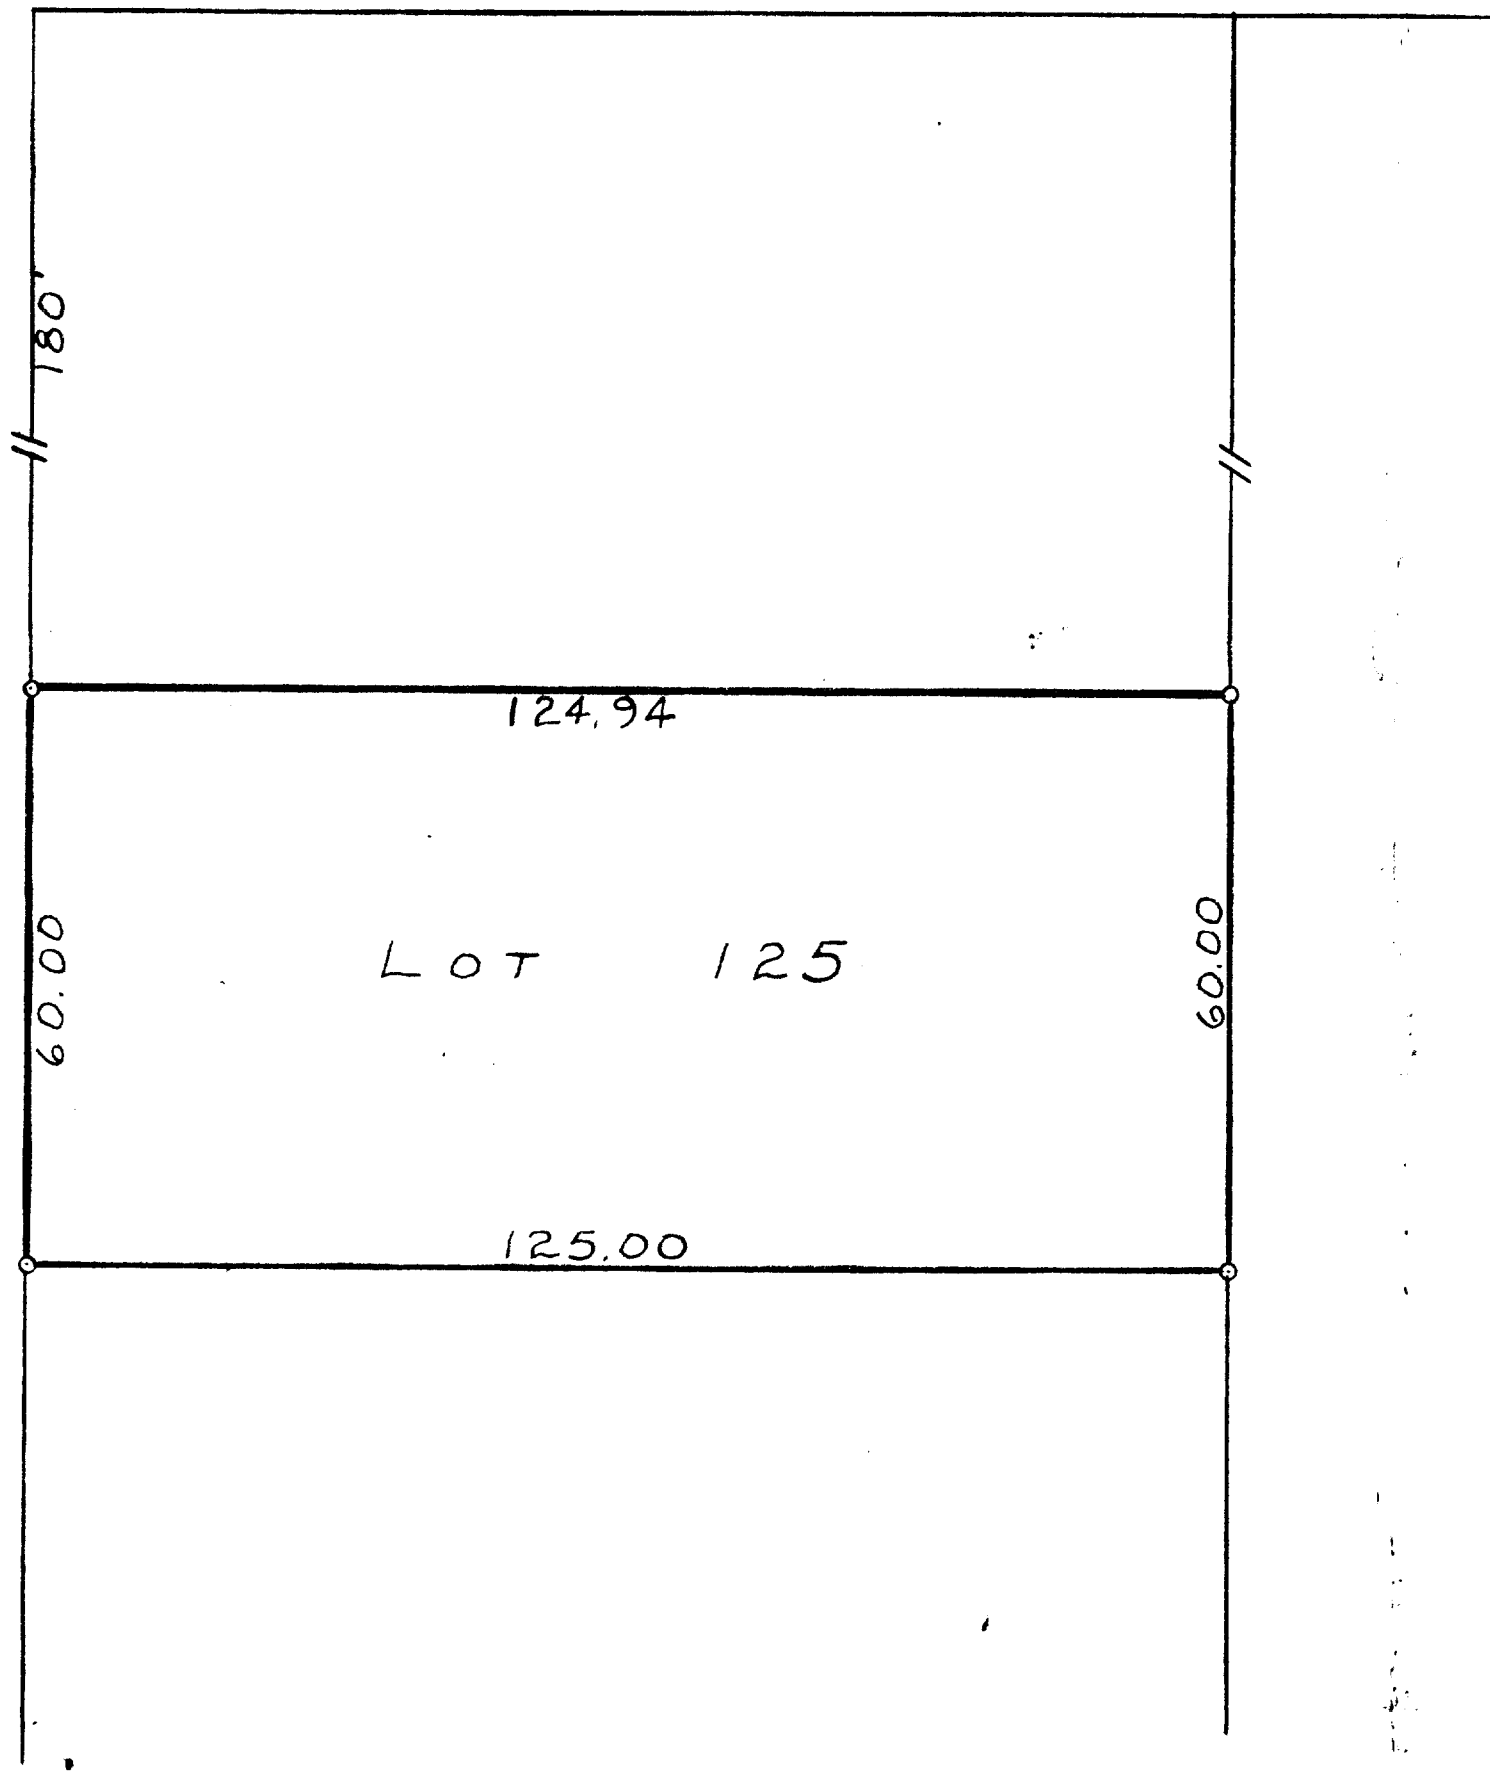

PLAT OF SURVEY OF LOT 125, CEDAR POINT PARK,
LOCATED IN THE VILLAGE OF WILLIAMS BAY, WALWORTH
COUNTY, WISCONSIN
AUGUST 18, 1955

George T. Dunham
GEORGE T. DUNHAM, SURVEYOR
DELAVER, WISCONSIN