


CLEVELAND

PARKWAY

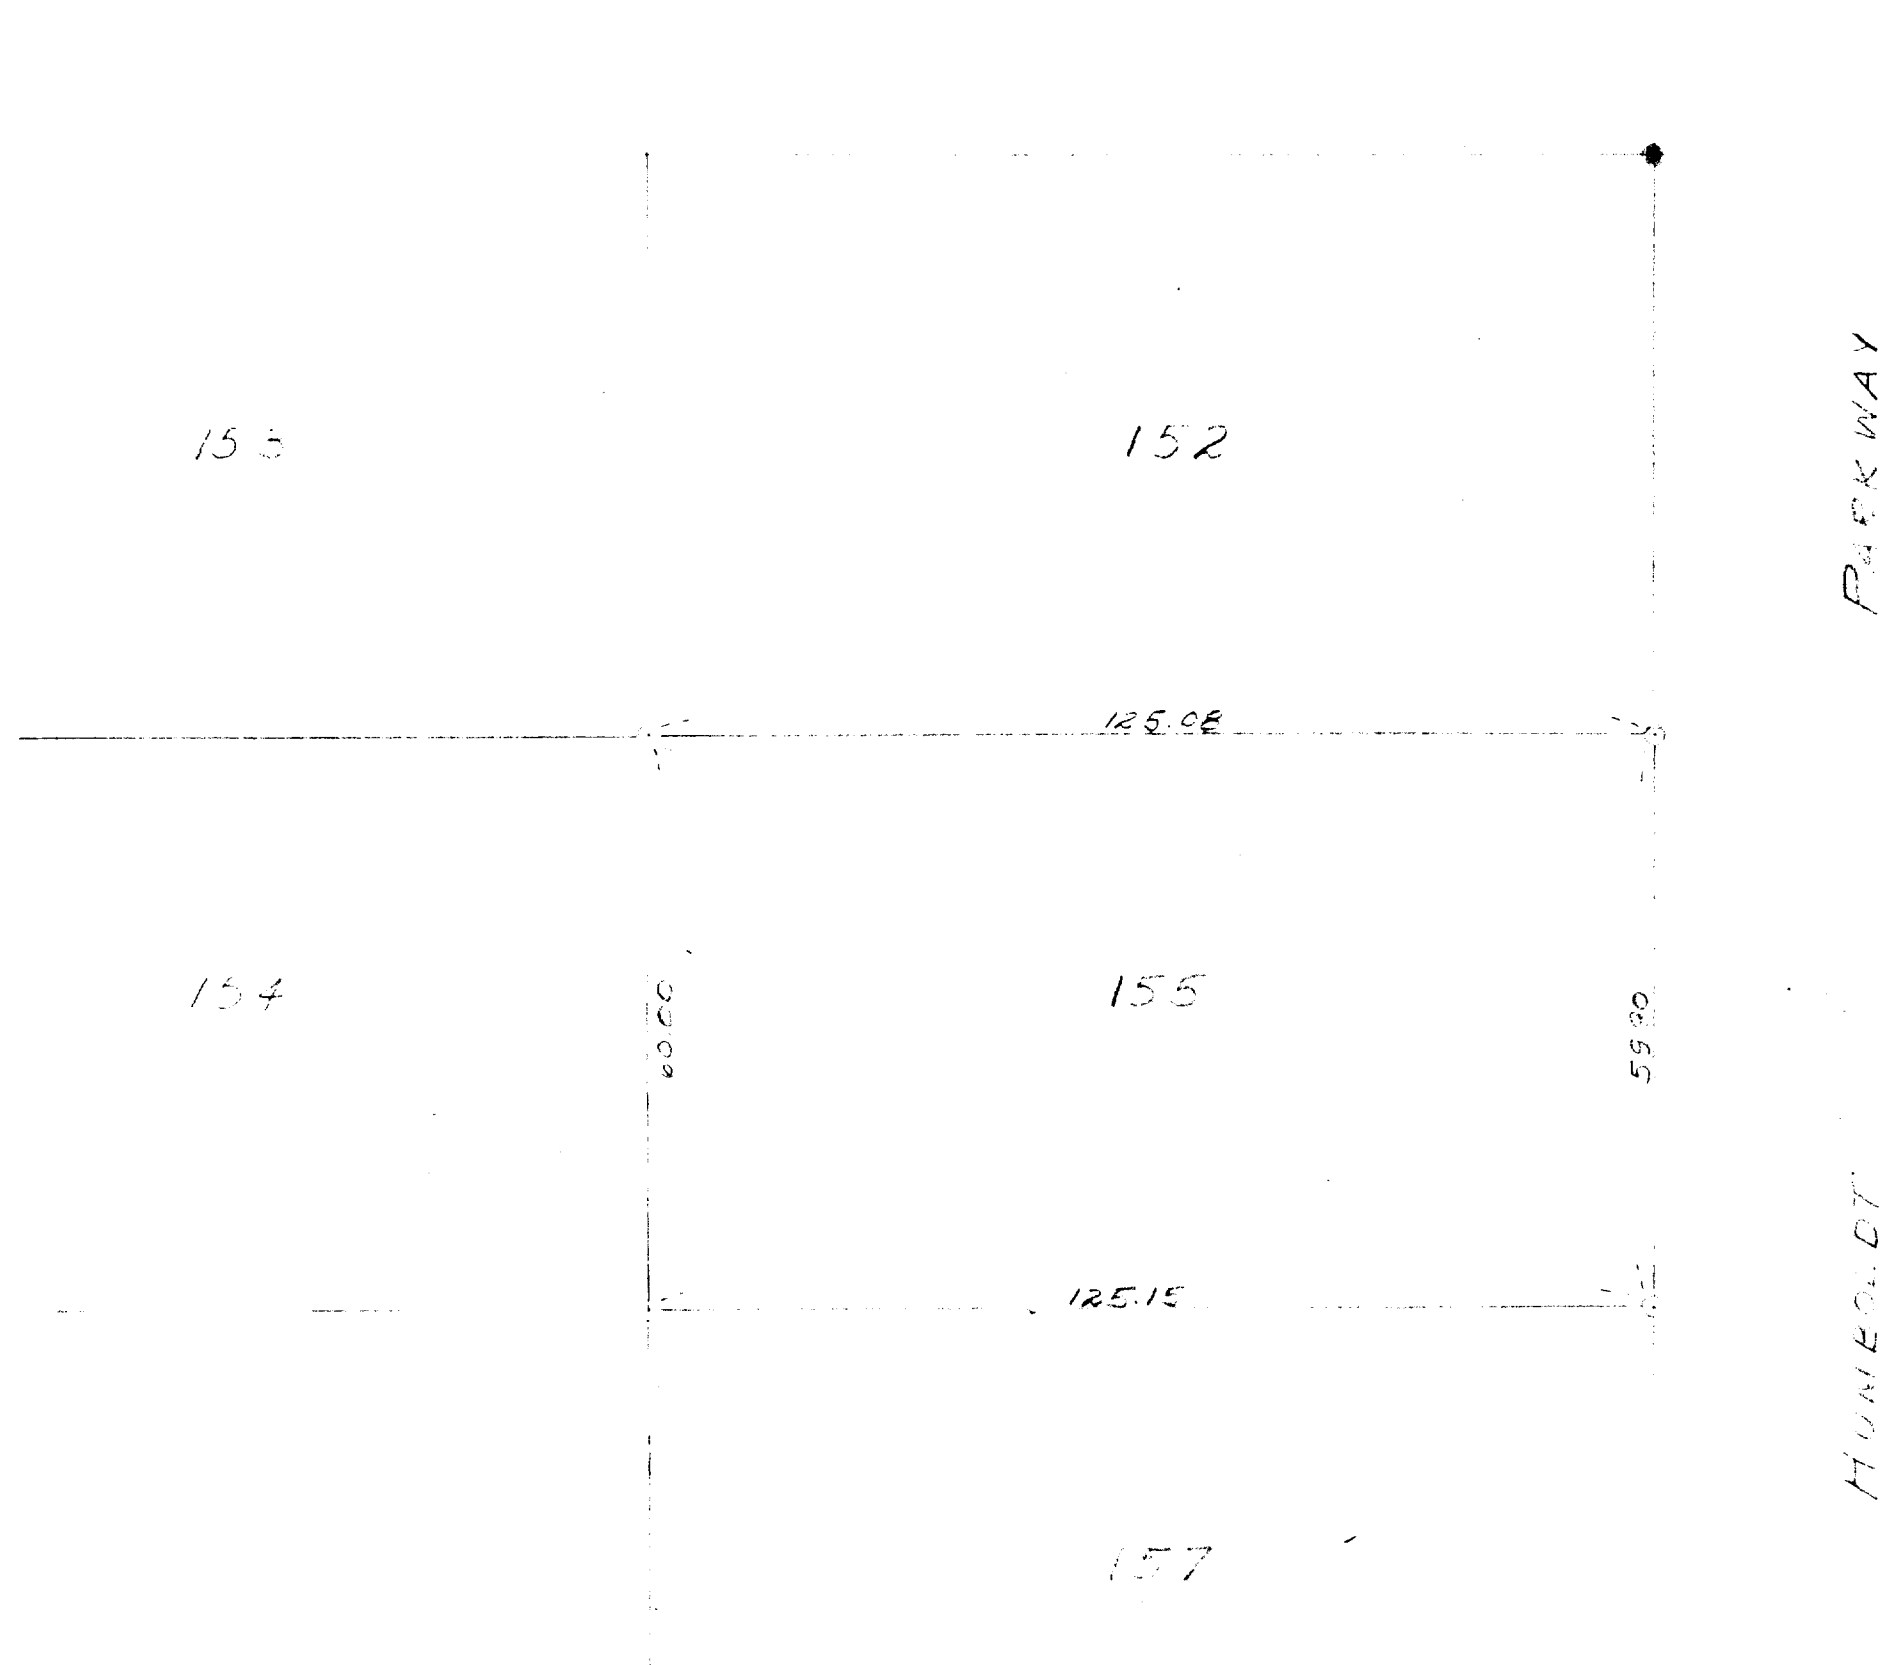

PLAT OF SURVEY OF LOT 155 OF THE ORIGINAL PLAT
OF CEDAR POINT PARK SUBDIVISION, WILLIAMS BAY,
WALWORTH COUNTY, WISCONSIN.
APRIL 15, 1950

H. E. Johnson
SURVEYOR

11-82 J