


HAROLD H. KOLB

REGISTERED PROFESSIONAL LAND SURVEYOR
LAKE GENEVA, WISCONSIN

PLAT OF SURVEY OF

LOT 193, ORIGINAL CEDAR POINT
PARK, VILLAGE OF WILLIAMS BAY,
WALWORTH COUNTY, WISCONSIN.

OWNER: ROGER AND DONALD
ZACHARIES

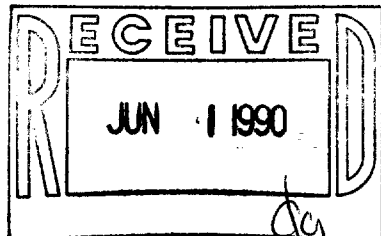

ORDERED BY: GUY MAYCHSZAK
17 FIR STREET
CARPENTERSVILLE,
IL. 60110
4/18/90

NOTE: RELOCATED IRON
PIPE, 4/18/90


N



SCALE: 1"=40'

LEGEND

- φ — IRON PIPE FOUND
- — IRON PIPE PLACED
- — CONCRETE MONUMENT
- ⌵ — SPIKE
- () — As Recorded

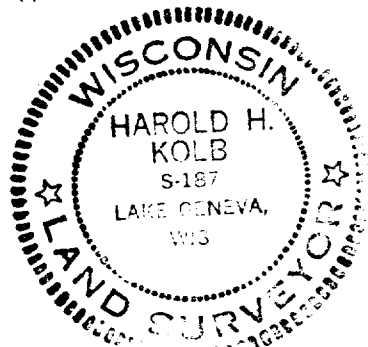

HAROLD H. KOLB
SURVEY IS NOT VALID UNLESS
SURVEYOR'S SIGNATURE IS IN
RED.

ACCURACY: DISTANCES $\pm 0.01'$
ANGLES $\pm 05''$
ERROR OF CLOSURE-
NOT MORE THAN 1 PART
IN 3000

I, HAROLD H. KOLB, DO HEREBY CERTIFY THAT I HAVE
SURVEYED THE PROPERTY HEREON DESCRIBED ACCORDING
TO THE OFFICIAL RECORDS, AND THAT THE PLAT HEREON
IS A CORRECT REPRESENTATION OF THE LOT LINES.

Harold H. Kolb
HAROLD H. KOLB
WISCONSIN REGISTERED LAND SURVEYOR, S-187
DATE Feb. 10, 1976

REVISED: APRIL 18, 1990

