


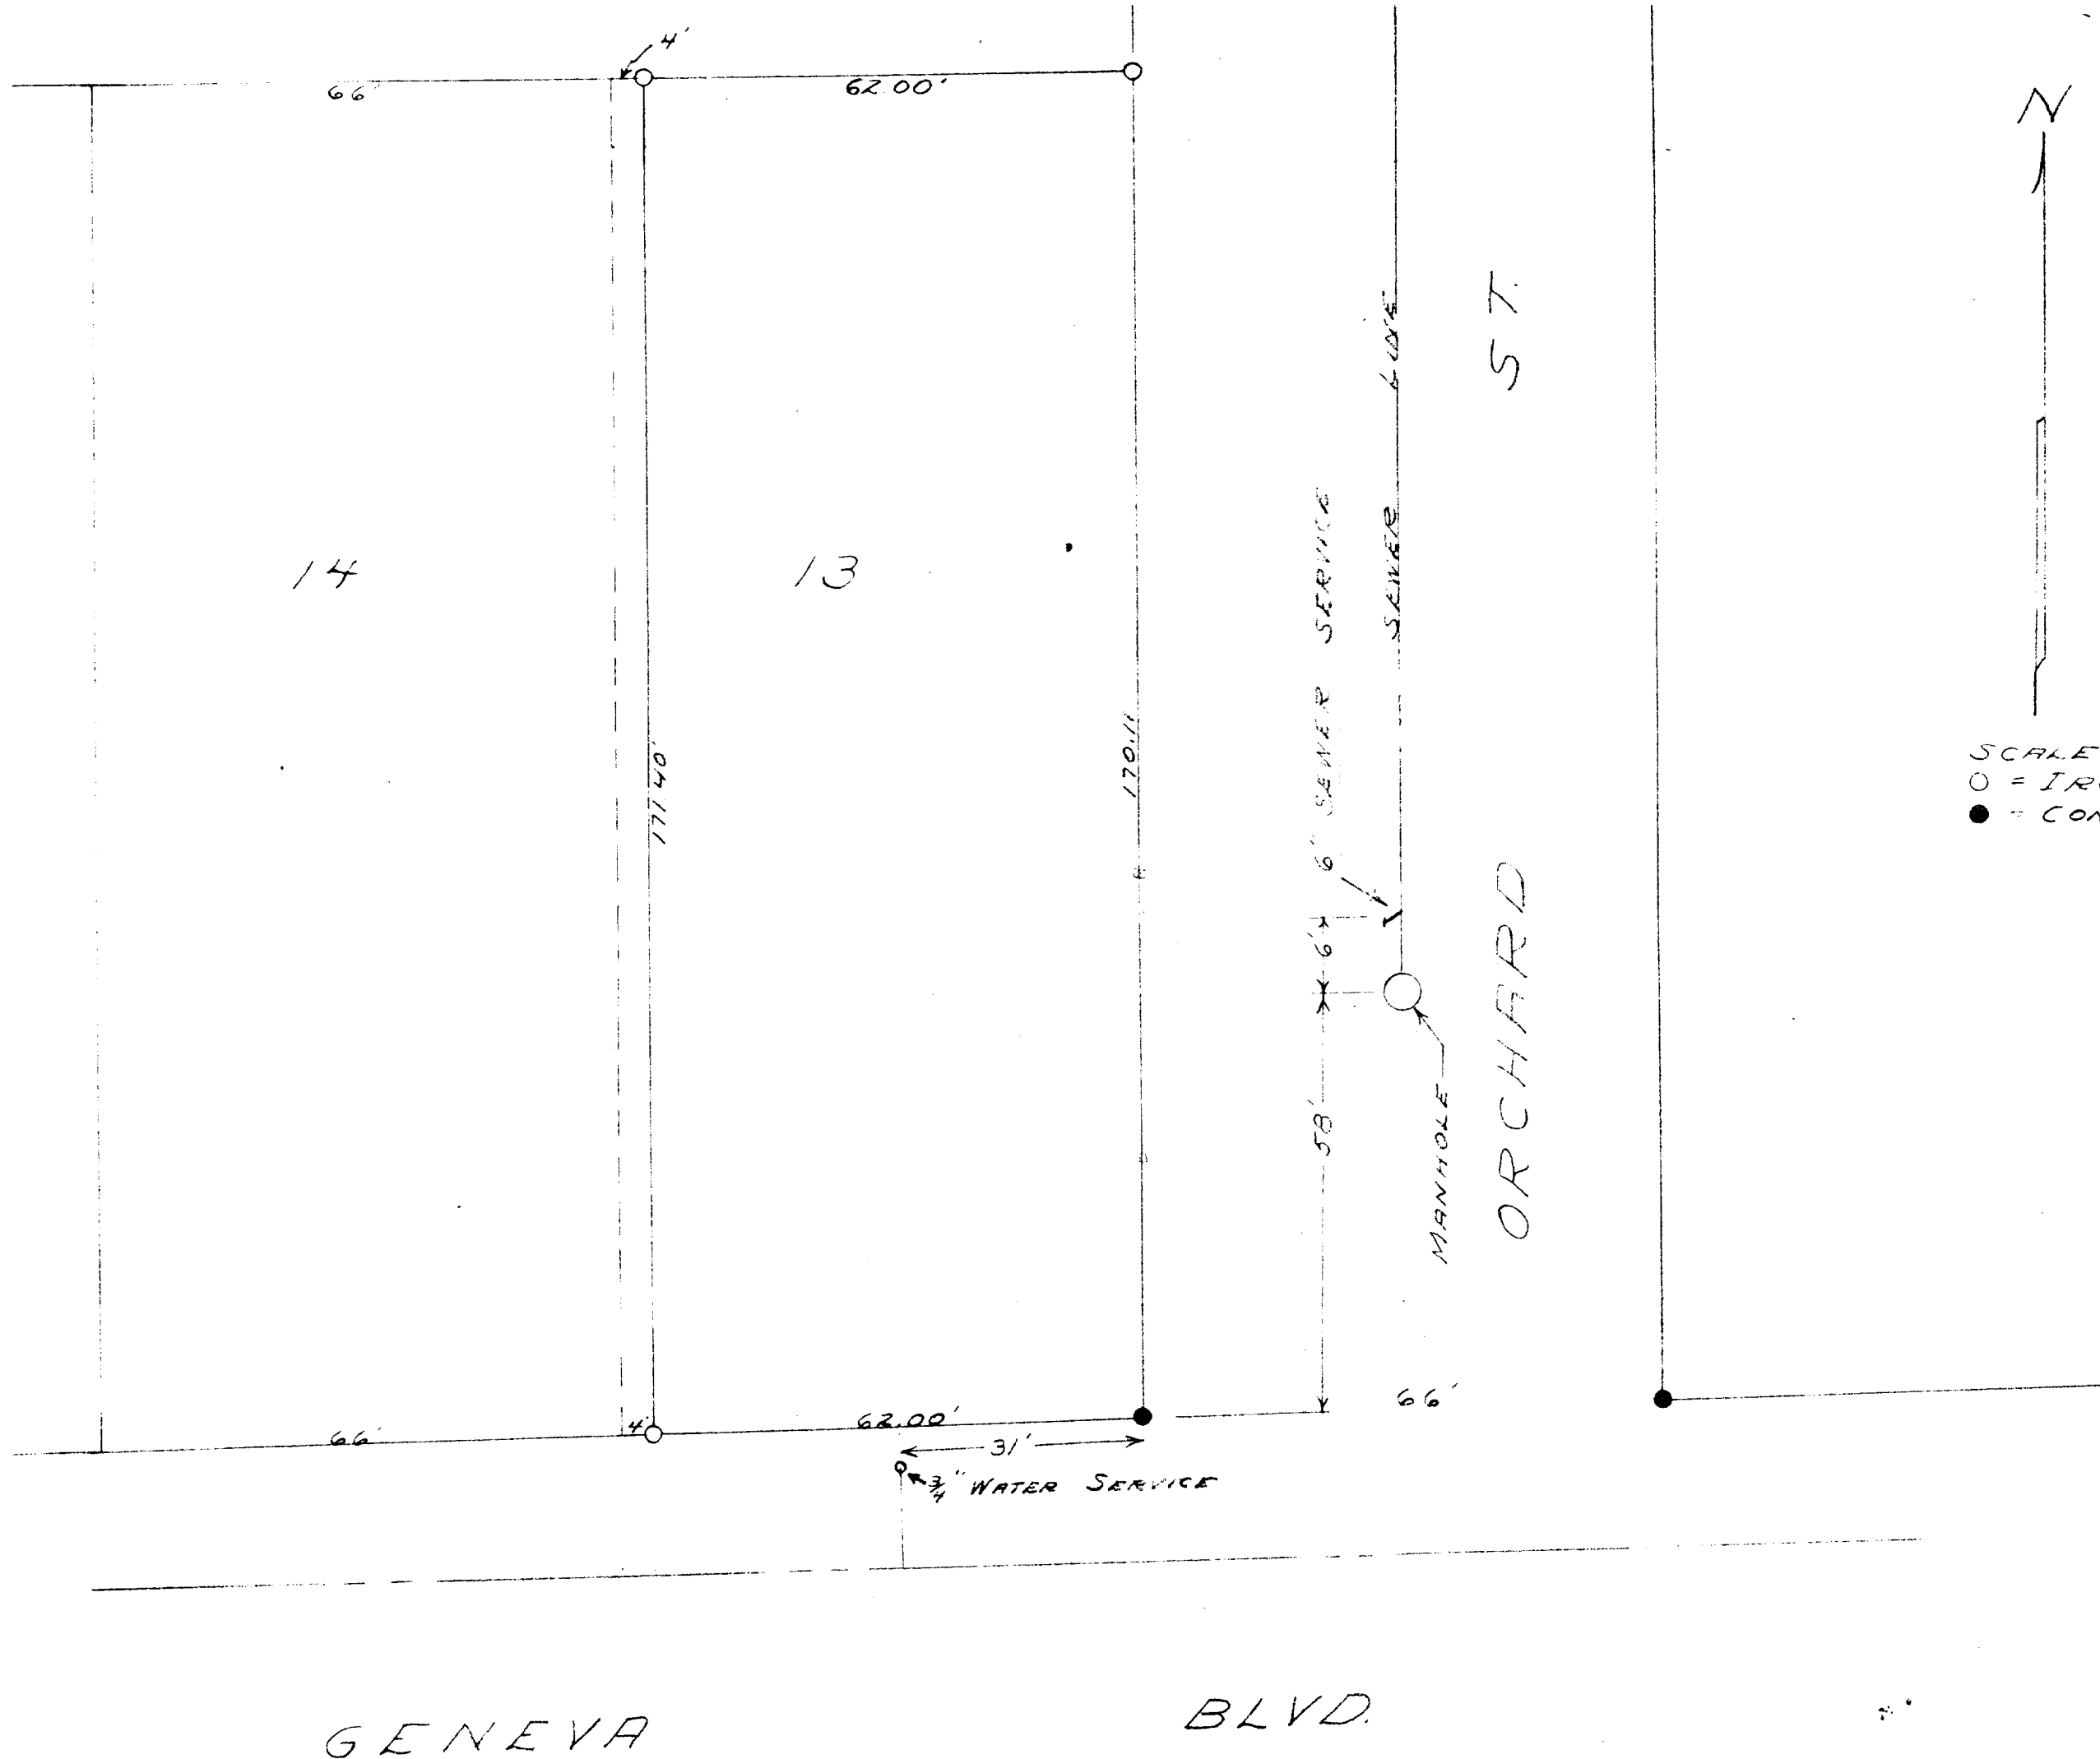

PLAT OF SURVEY OF THE EAST 62 FEET OF
 LOT 13 BLOCK 16 OF WILLIAMS 2ND ADDITION,
 IN THE VILLAGE OF WILLIAMS BAY, WALWORTH
 COUNTY, WISCONSIN.
 APRIL 8, 1950

H. E. Johnson
 SURVEYOR

11-83 J