


**REGISTERED PROFESSIONAL LAND SURVEYOR
LAKE GENEVA, WISCONSIN**




PLAT OF SURVEY OF
The North 28.00 feet of Lot 14, Block 11, Williams
2nd. Addition, Village of Williams Bay, Walworth
County, Wisconsin

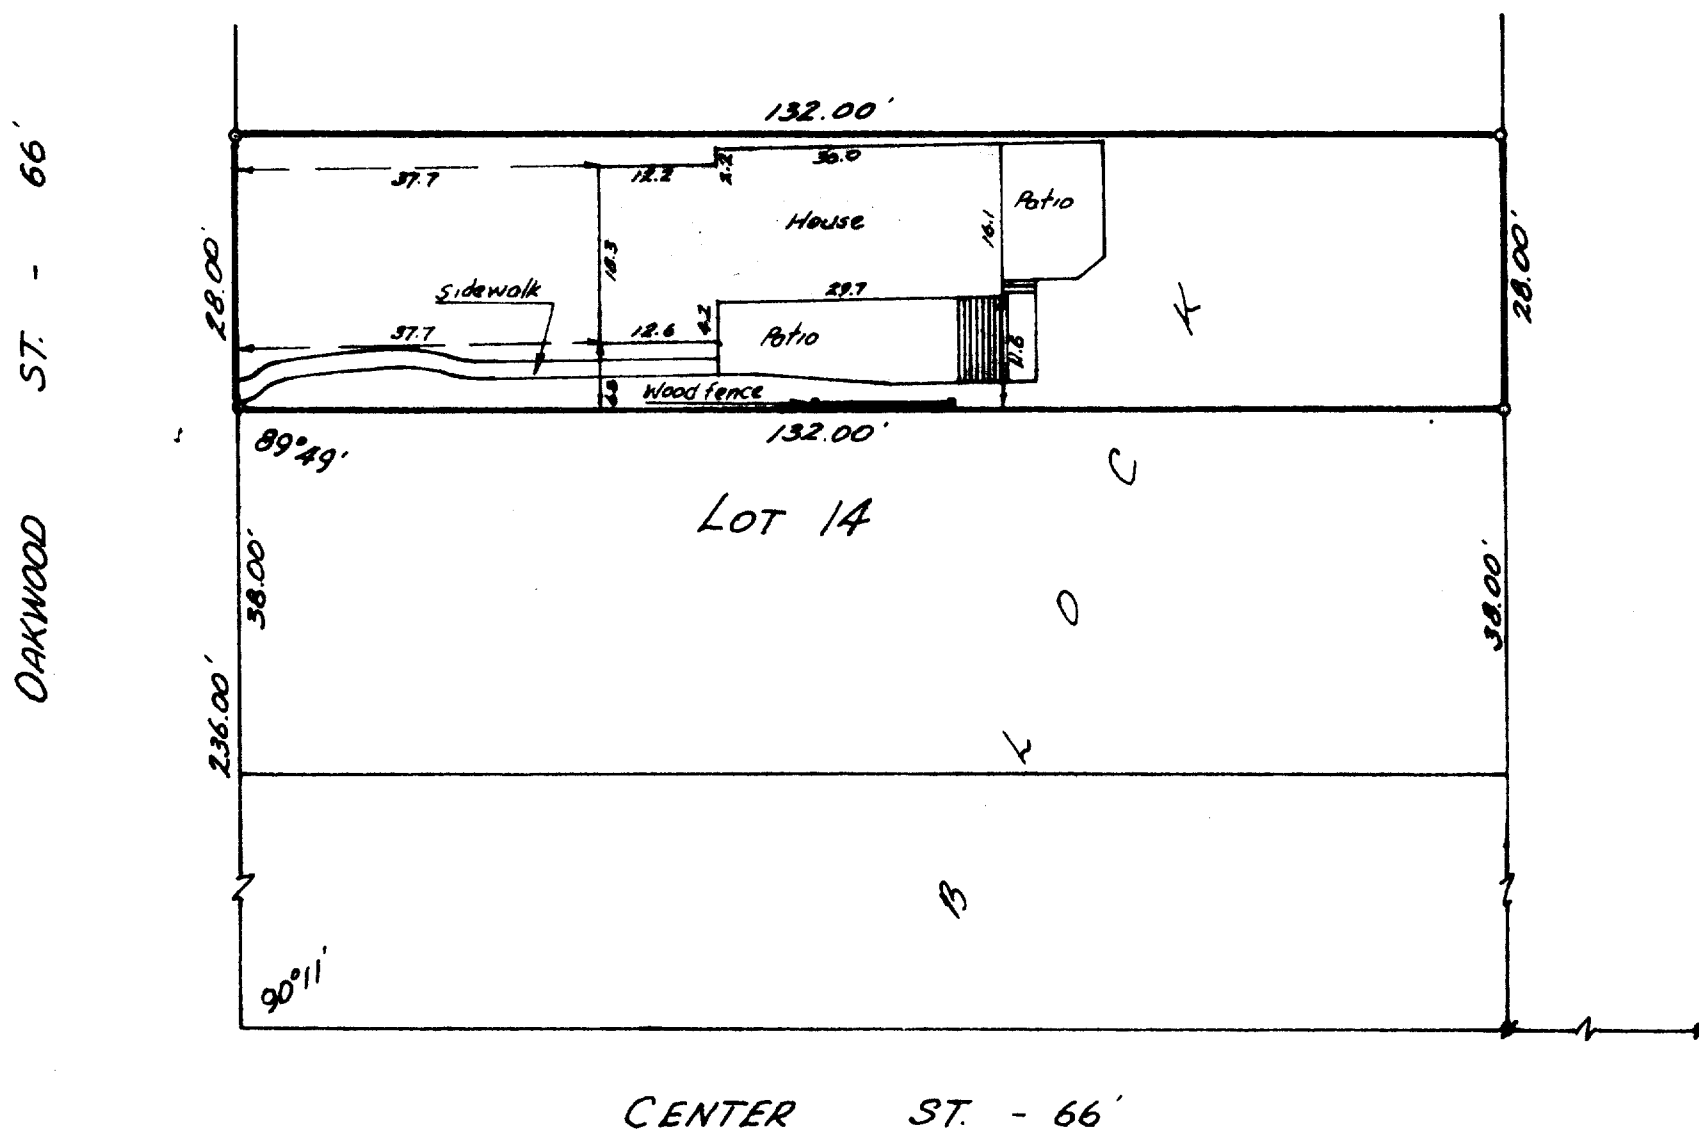

Scale-1"=20'

LEGEND

- Ø - IRON PIPE FOUND
O - IRON PIPE PLACED
● - CONCRETE MONUMENT
X - SPIKE

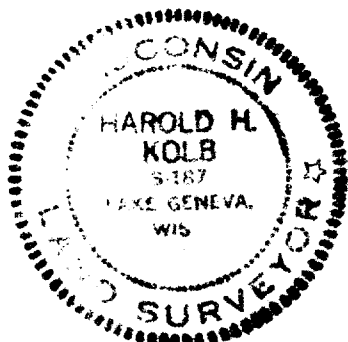

I, HAROLD H. KOLB, DO HEREBY CERTIFY THAT I HAVE SURVEYED THE PROPERTY HEREON DESCRIBED ACCORDING TO THE OFFICIAL RECORDS, AND THAT THE PLAT HEREON IS A CORRECT REPRESENTATION OF THE LOT LINES, and the principle lines of the improvements thereon.

Harold N. Zell

HAROLD H. KOLB

WISCONSIN REGISTERED LAND SURVEYOR, 8-187

DATE August 12, 1970

OP-165

11-84