


KOLB LAND CONSULTING, INC.
LAND SURVEYING • SUBDIVIDING • LAND PLANNING

929 WILLIAMS STREET LAKE GENEVA, WISCONSIN 53147 414-248-3697

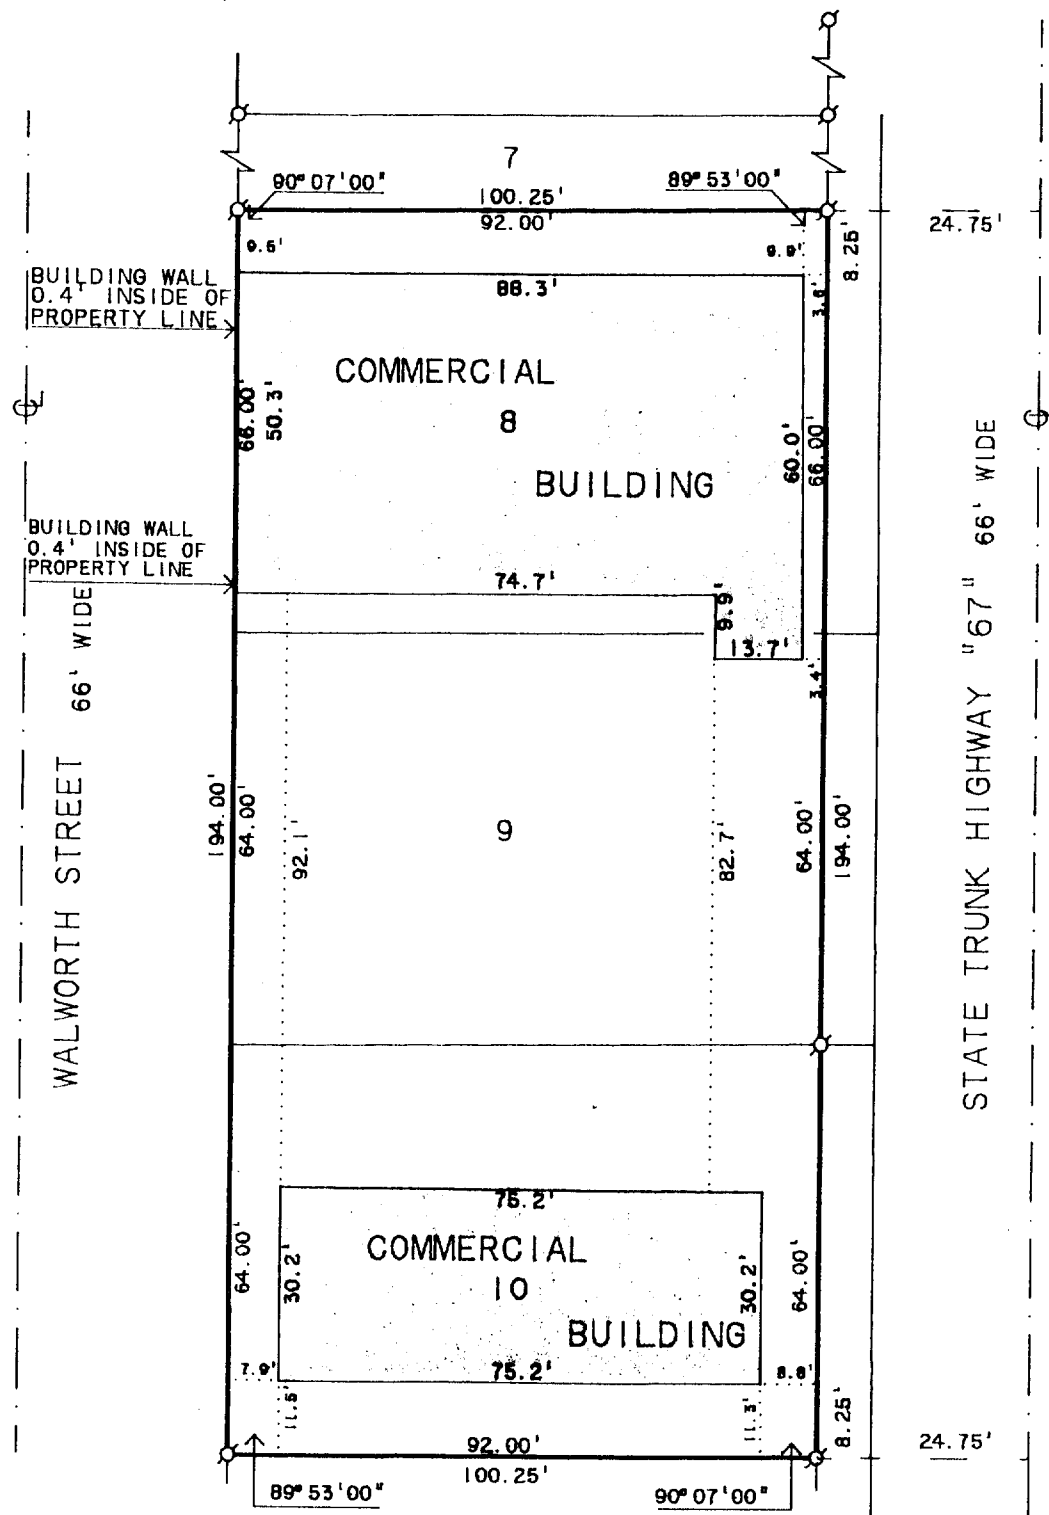

SCALE 1" = 30'

LEGEND


X - IRON PIPE FOUND

ORDERED BY:
ACKMAN GLASS & MIRROR
P.O. BOX 998
WILLIAMS BAY, WI 53191

PLAT OF SURVEY OF
THE WEST 92.00 FEET OF LOTS 8-10 OF THE
WILLIAM H. FRANCIS SUBDIVISION OF OUTLOT
NO. 1 OF THE ORIGINAL PLAT OF THE VILLAGE
OF WILLIAMS BAY, WALWORTH COUNTY, WISCONSIN.

I HAROLD H. KOLB, DO HEREBY CERTIFY THAT
I HAVE SURVEYED THE PROPERTY HEREON DES-
CRIBED ACCORDING TO THE OFFICAL RECORDS,
AND THAT THE PLAT HEREON IS A CORRECT REP-
RESENTATION OF THE LOT LINES AND PRINCIPAL
BUILDING LINES TO THE BEST OF MY KNOWLEDGE
AND BELIEF.

SURVEY IS NOT VALID UNLESS SURVEYOR'S
SIGNATURE IS IN RED.

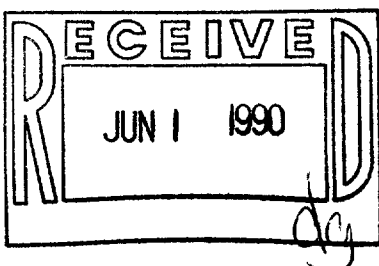

HAROLD H. KOLB

WISCONSIN REGISTERED LAND SURVEYOR, S-187
DATE JANUARY 10, 1990

REVISED _____

REVISED _____

011-841

WMB-179

WFS 00003A
WFS 00004