


HAROLD H. KOLB

REGISTERED PROFESSIONAL LAND SURVEYOR
LAKE GENEVA, WISCONSIN

40' WIDE DRIVE

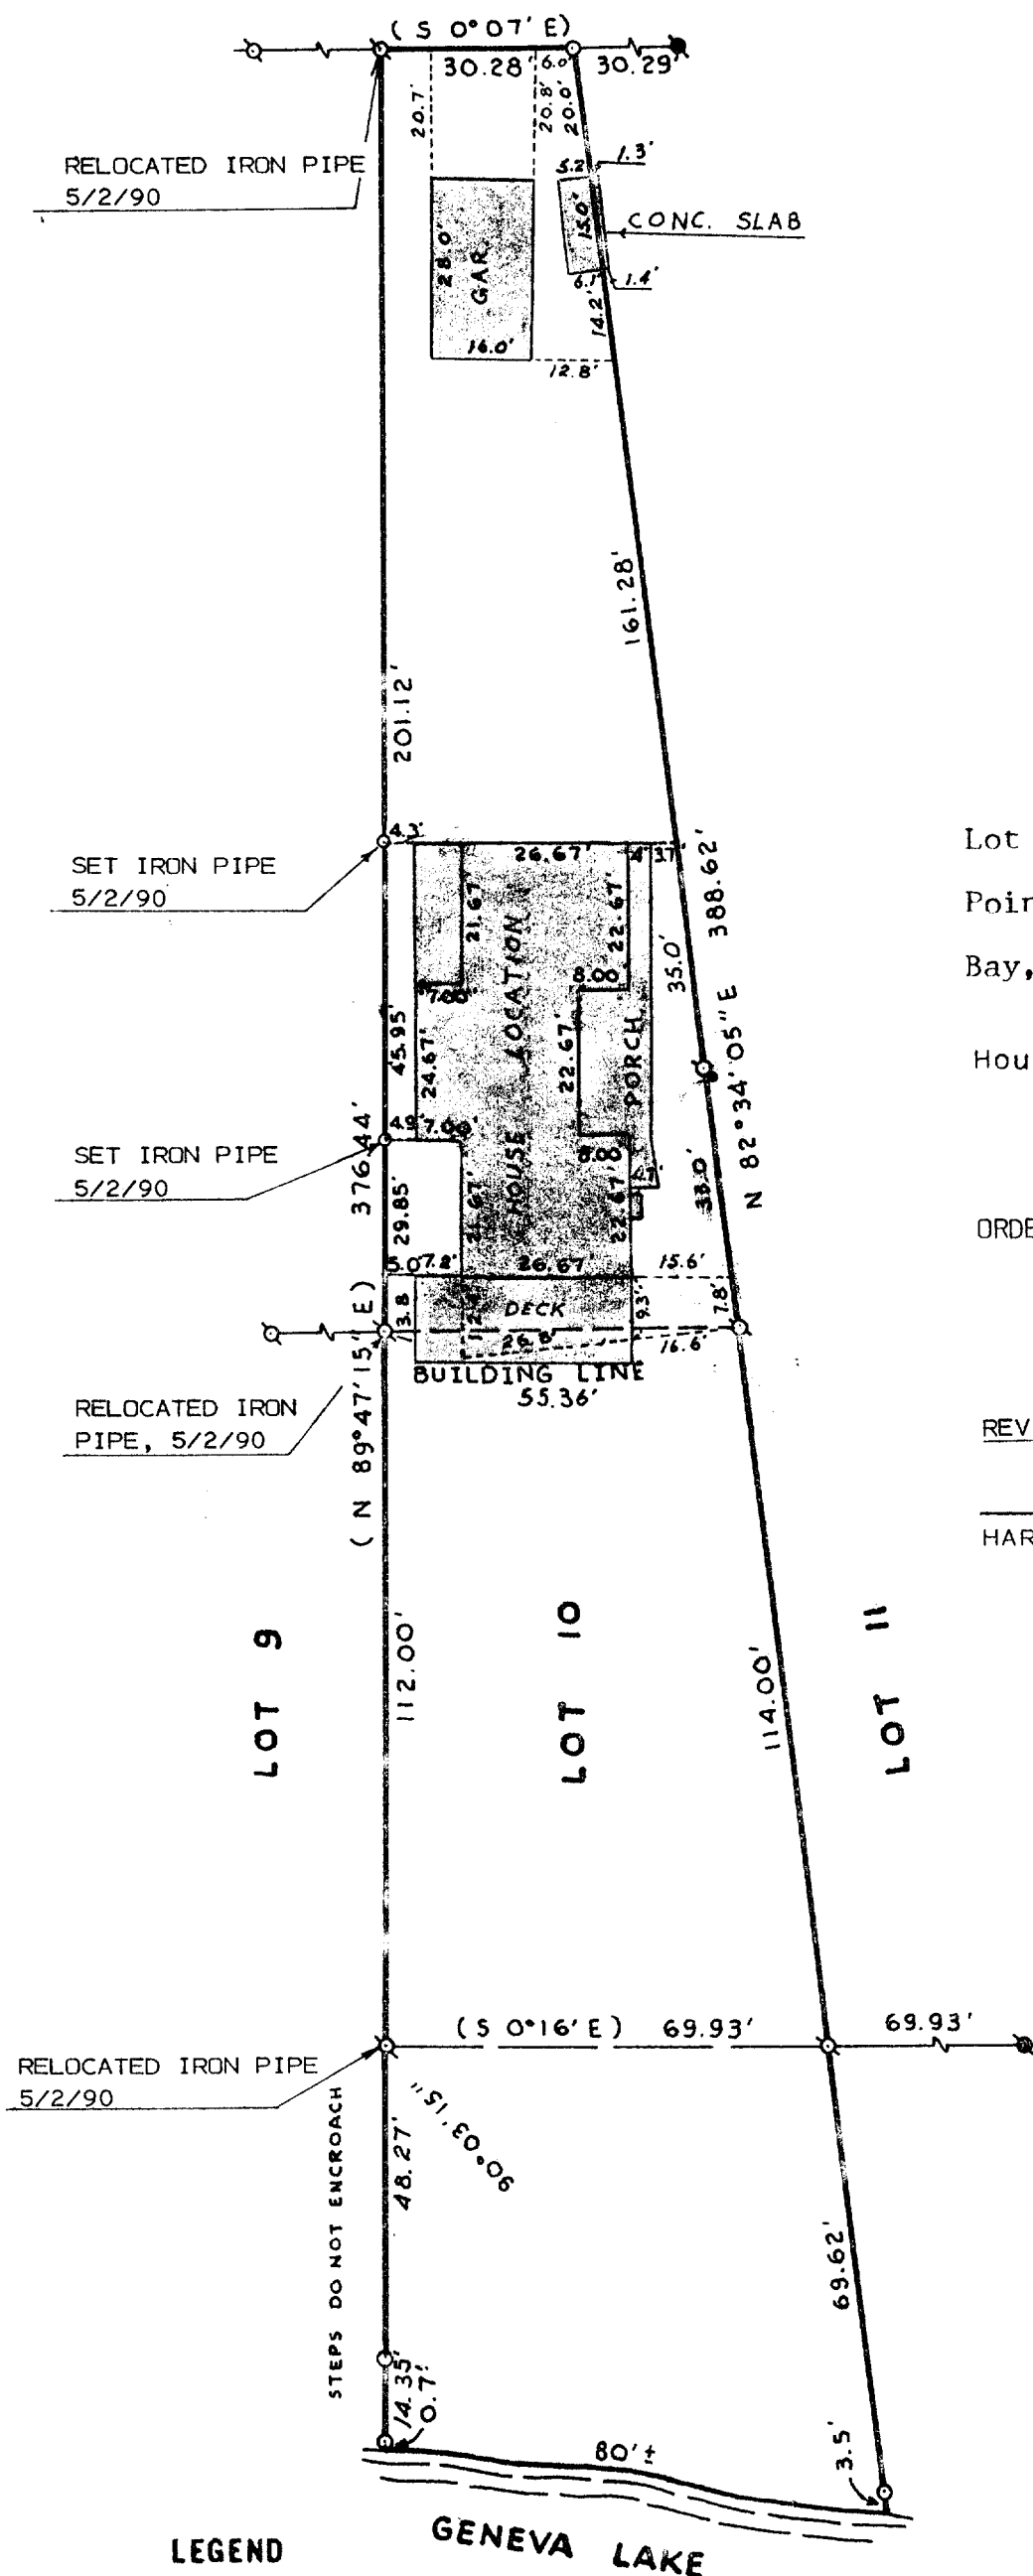

PLAT OF SURVEY OF



Lot 10, First Addition to Cedar
Point Park, Village of Williams
Bay, Walworth County, Wisconsin

House Location: September 5, 1974

ORDERED BY: ROBERT HAWKINSON
284 MAPLE STREET
GLEN ELLYN, IL. 60137

REVISED: MAY 3, 1990


HAROLD H. KOLB

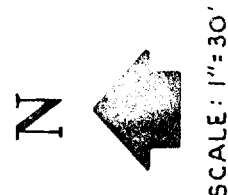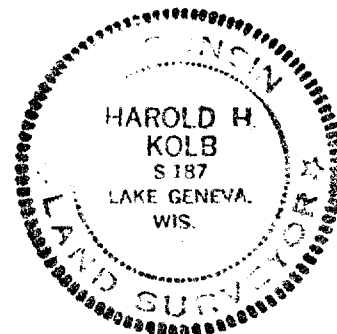

I, HAROLD H. KOLB, DO HEREBY CERTIFY THAT I HAVE
SURVEYED THE PROPERTY HEREON DESCRIBED ACCORDING
TO THE OFFICIAL RECORDS, AND THAT THE PLAT HEREON
IS A CORRECT REPRESENTATION OF THE LOT LINES, and the
principle lines of the buildings thereon.

Harold H. Kolb
HAROLD H. KOLB
WISCONSIN REGISTERED LAND SURVEYOR, S-187
DATE August 31, 1973

REVISED: SEPTEMBER 12, 1974

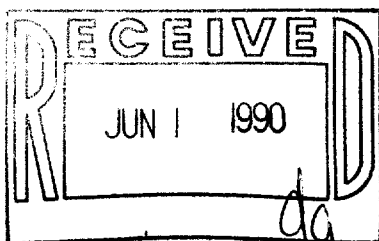

011-844

WCP1 00009

Wms B-112