

PLAT OF SURVEY

LOCATION:

State Highway 36, Williams Bay, Wisconsin


LEGAL DESCRIPTION: Lot 20 in BAYWOOD HEIGHTS SUBDIVISION, a Subdivision located in the SE 1/4 of the NW 1/4 and the SW 1/4 of the NW 1/4 of Section 1, Town 1 North, Range 16 East, in the Village of Williams Bay, Walworth County, Wisconsin.

June 26, 1990

Survey No. 77026



E/L SMYTHE DR.

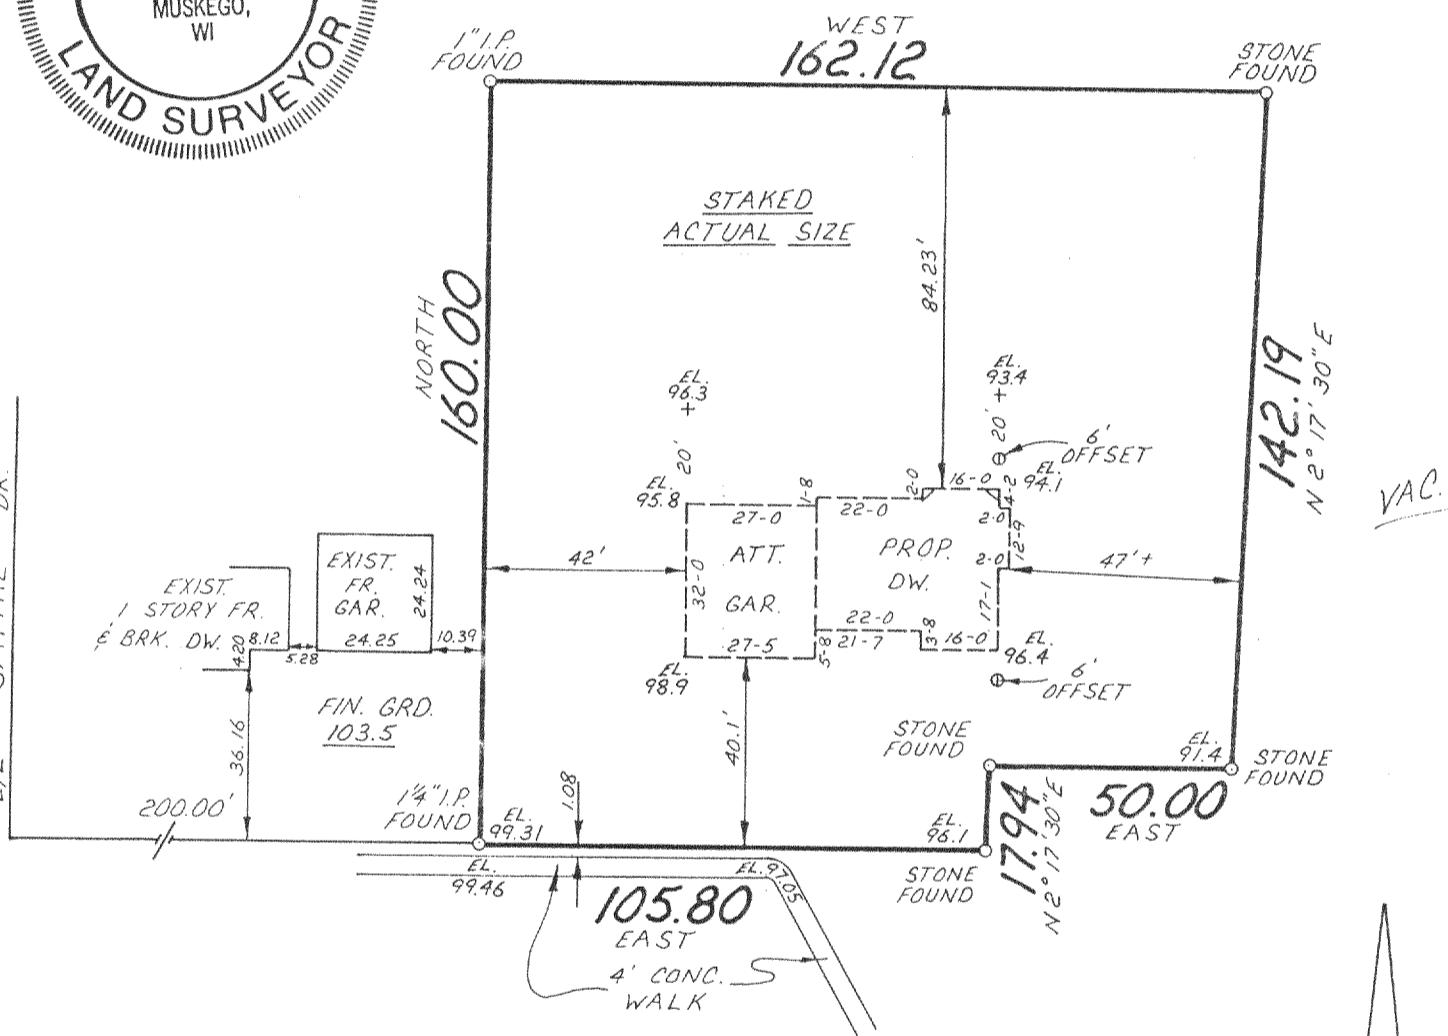


S.T.H.

"36"

(100' R.O.W.) M.H.  
RIM. = 100.00  
INV. = 93.52

1" = 40'

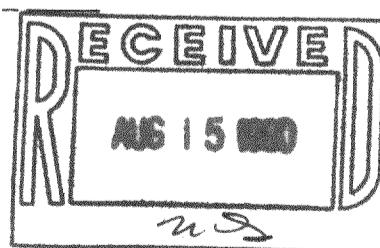

METROPOLITAN SURVEY SERVICE, INC.

REGISTERED LAND SURVEYORS

9415 W. FOREST HOME AVE., SUITE 107 HALES CORNERS, WI 53130  
529-5380

I HEREBY CERTIFY THAT I HAVE SURVEYED THE ABOVE DESCRIBED PROPERTY AND THAT THE ABOVE MAP IS A TRUE REPRESENTATION THEREOF AND SHOWS THE SIZE AND LOCATION OF THE PROPERTY, ITS EXTERIOR BOUNDARIES, THE LOCATION OF ALL VISIBLE STRUCTURES AND DIMENSIONS OF ALL PRINCIPAL BUILDINGS THEREON, BOUNDARY FENCES, APPARENT EASEMENTS AND ROADWAYS AND VISIBLE ENCROACHMENTS, IF ANY.

THIS SURVEY IS MADE FOR THE EXCLUSIVE USE OF THE PRESENT OWNERS OF THE PROPERTY, AND ALSO THOSE WHO PURCHASE, MORTGAGE, OR GUARANTEE THE TITLE THERETO WITHIN ONE (1) YEAR FROM DATE HEREOF.

SIGNED

Gerald E. Casey  
Registered Land Surveyor S-1329

Coventry Homes  
Dick & Janet Grotta


PLAT OF SURVEY

LOCATION: State Highway #8, Williams Bay, Wisconsin

LEGAL DESCRIPTION: Lot 20 in BAYWOOD HEIGHTS SUBDIVISION, a Subdivision located in the SE 1/4 of the NW 1/4 and the SW 1/4 of the NW 1/4 of Section 1, Town 1 North, Range 16 East, in the Village of Williams Bay, Walworth County, Wisconsin.

October 8, 1990


Survey No. 77728

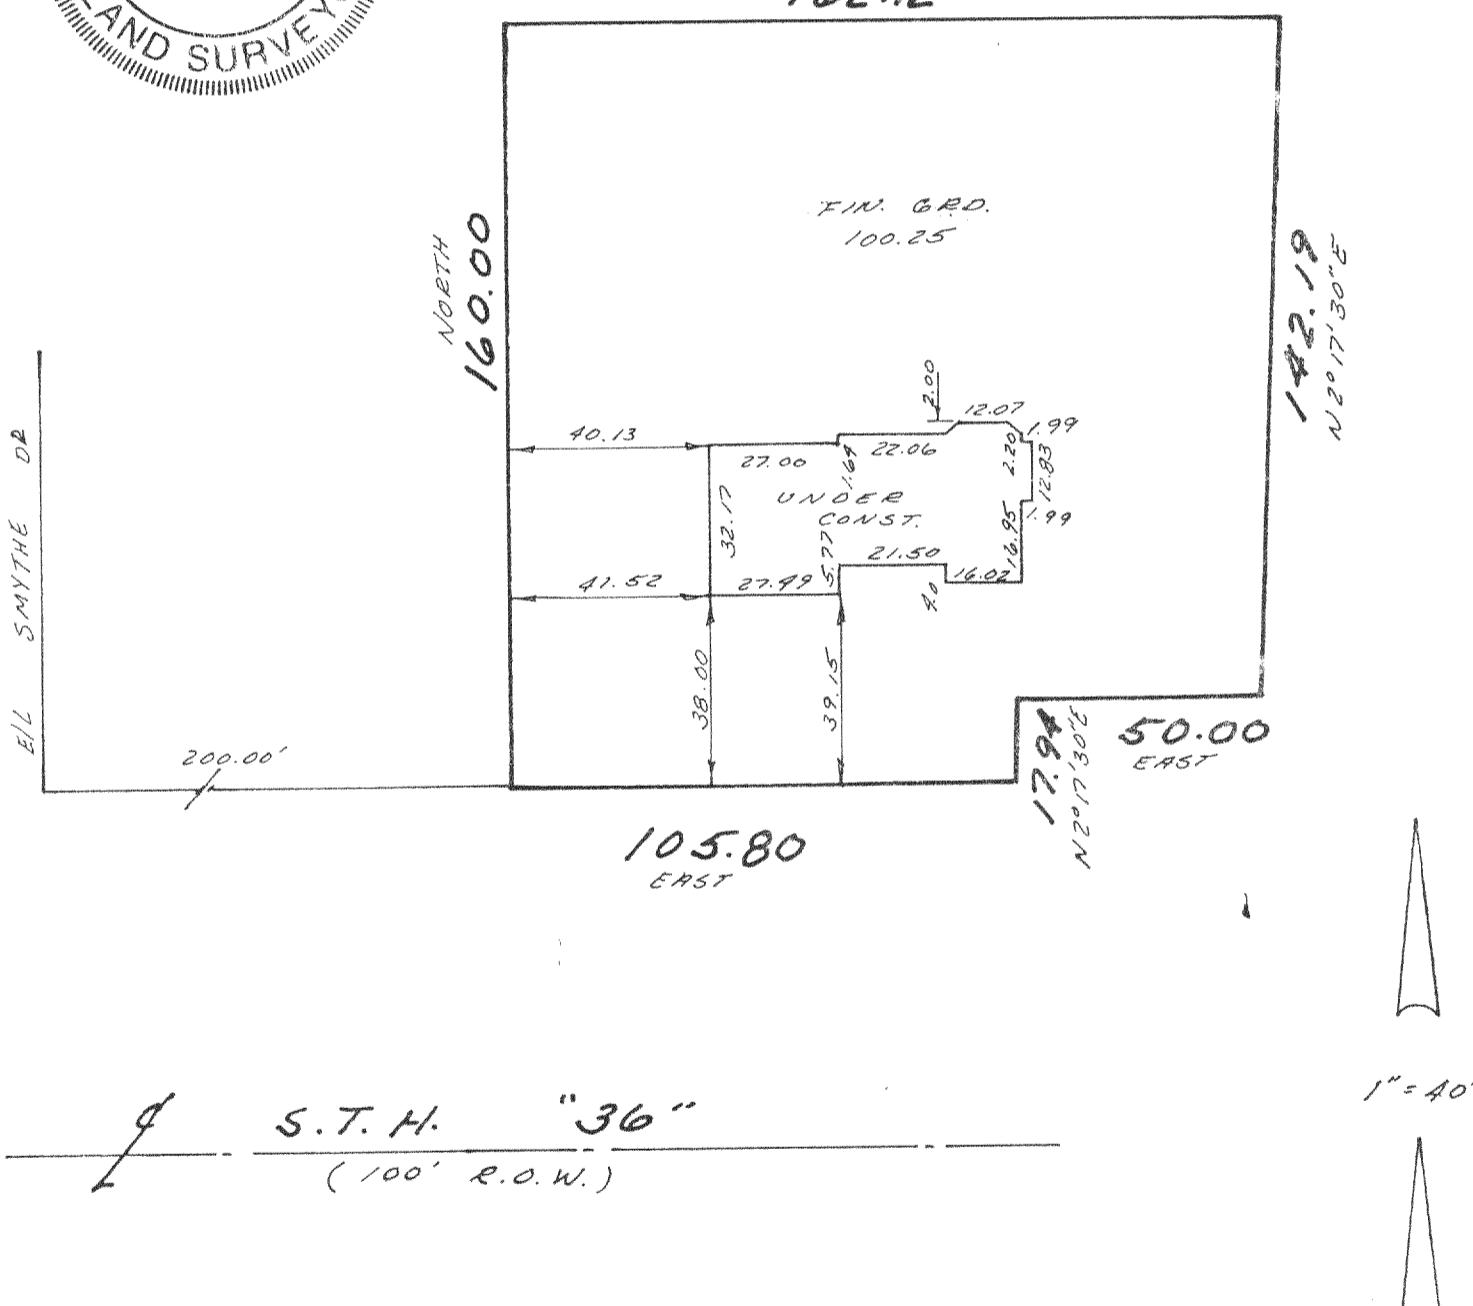

METROPOLITAN SURVEY SERVICE, INC.

REGISTERED LAND SURVEYORS

9415 W. FOREST HOME AVE., SUITE 107 HALES CORNERS, WI 53130  
529-5380

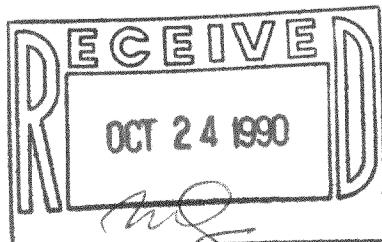

I HEREBY CERTIFY THAT I HAVE SURVEYED THE ABOVE DESCRIBED PROPERTY AND THAT THE ABOVE MAP IS A TRUE REPRESENTATION THEREOF AND SHOWS THE SIZE AND LOCATION OF THE PROPERTY, ITS EXTERIOR BOUNDARIES, THE LOCATION OF ALL VISIBLE STRUCTURES AND DIMENSIONS OF ALL PRINCIPAL BUILDINGS THEREON, BOUNDARY FENCES, APPARENT EASEMENTS AND ROADWAYS AND VISIBLE ENCROACHMENTS, IF ANY.

THIS SURVEY IS MADE FOR THE EXCLUSIVE USE OF THE PRESENT OWNERS OF THE PROPERTY, AND ALSO THOSE WHO PURCHASE, MORTGAGE, OR GUARANTEE THE TITLE THERETO WITHIN ONE (1) YEAR FROM DATE HEREOF.

SIGNED

Gerald E. Casey  
Registered Land Surveyor S-1329

WBW 000020