


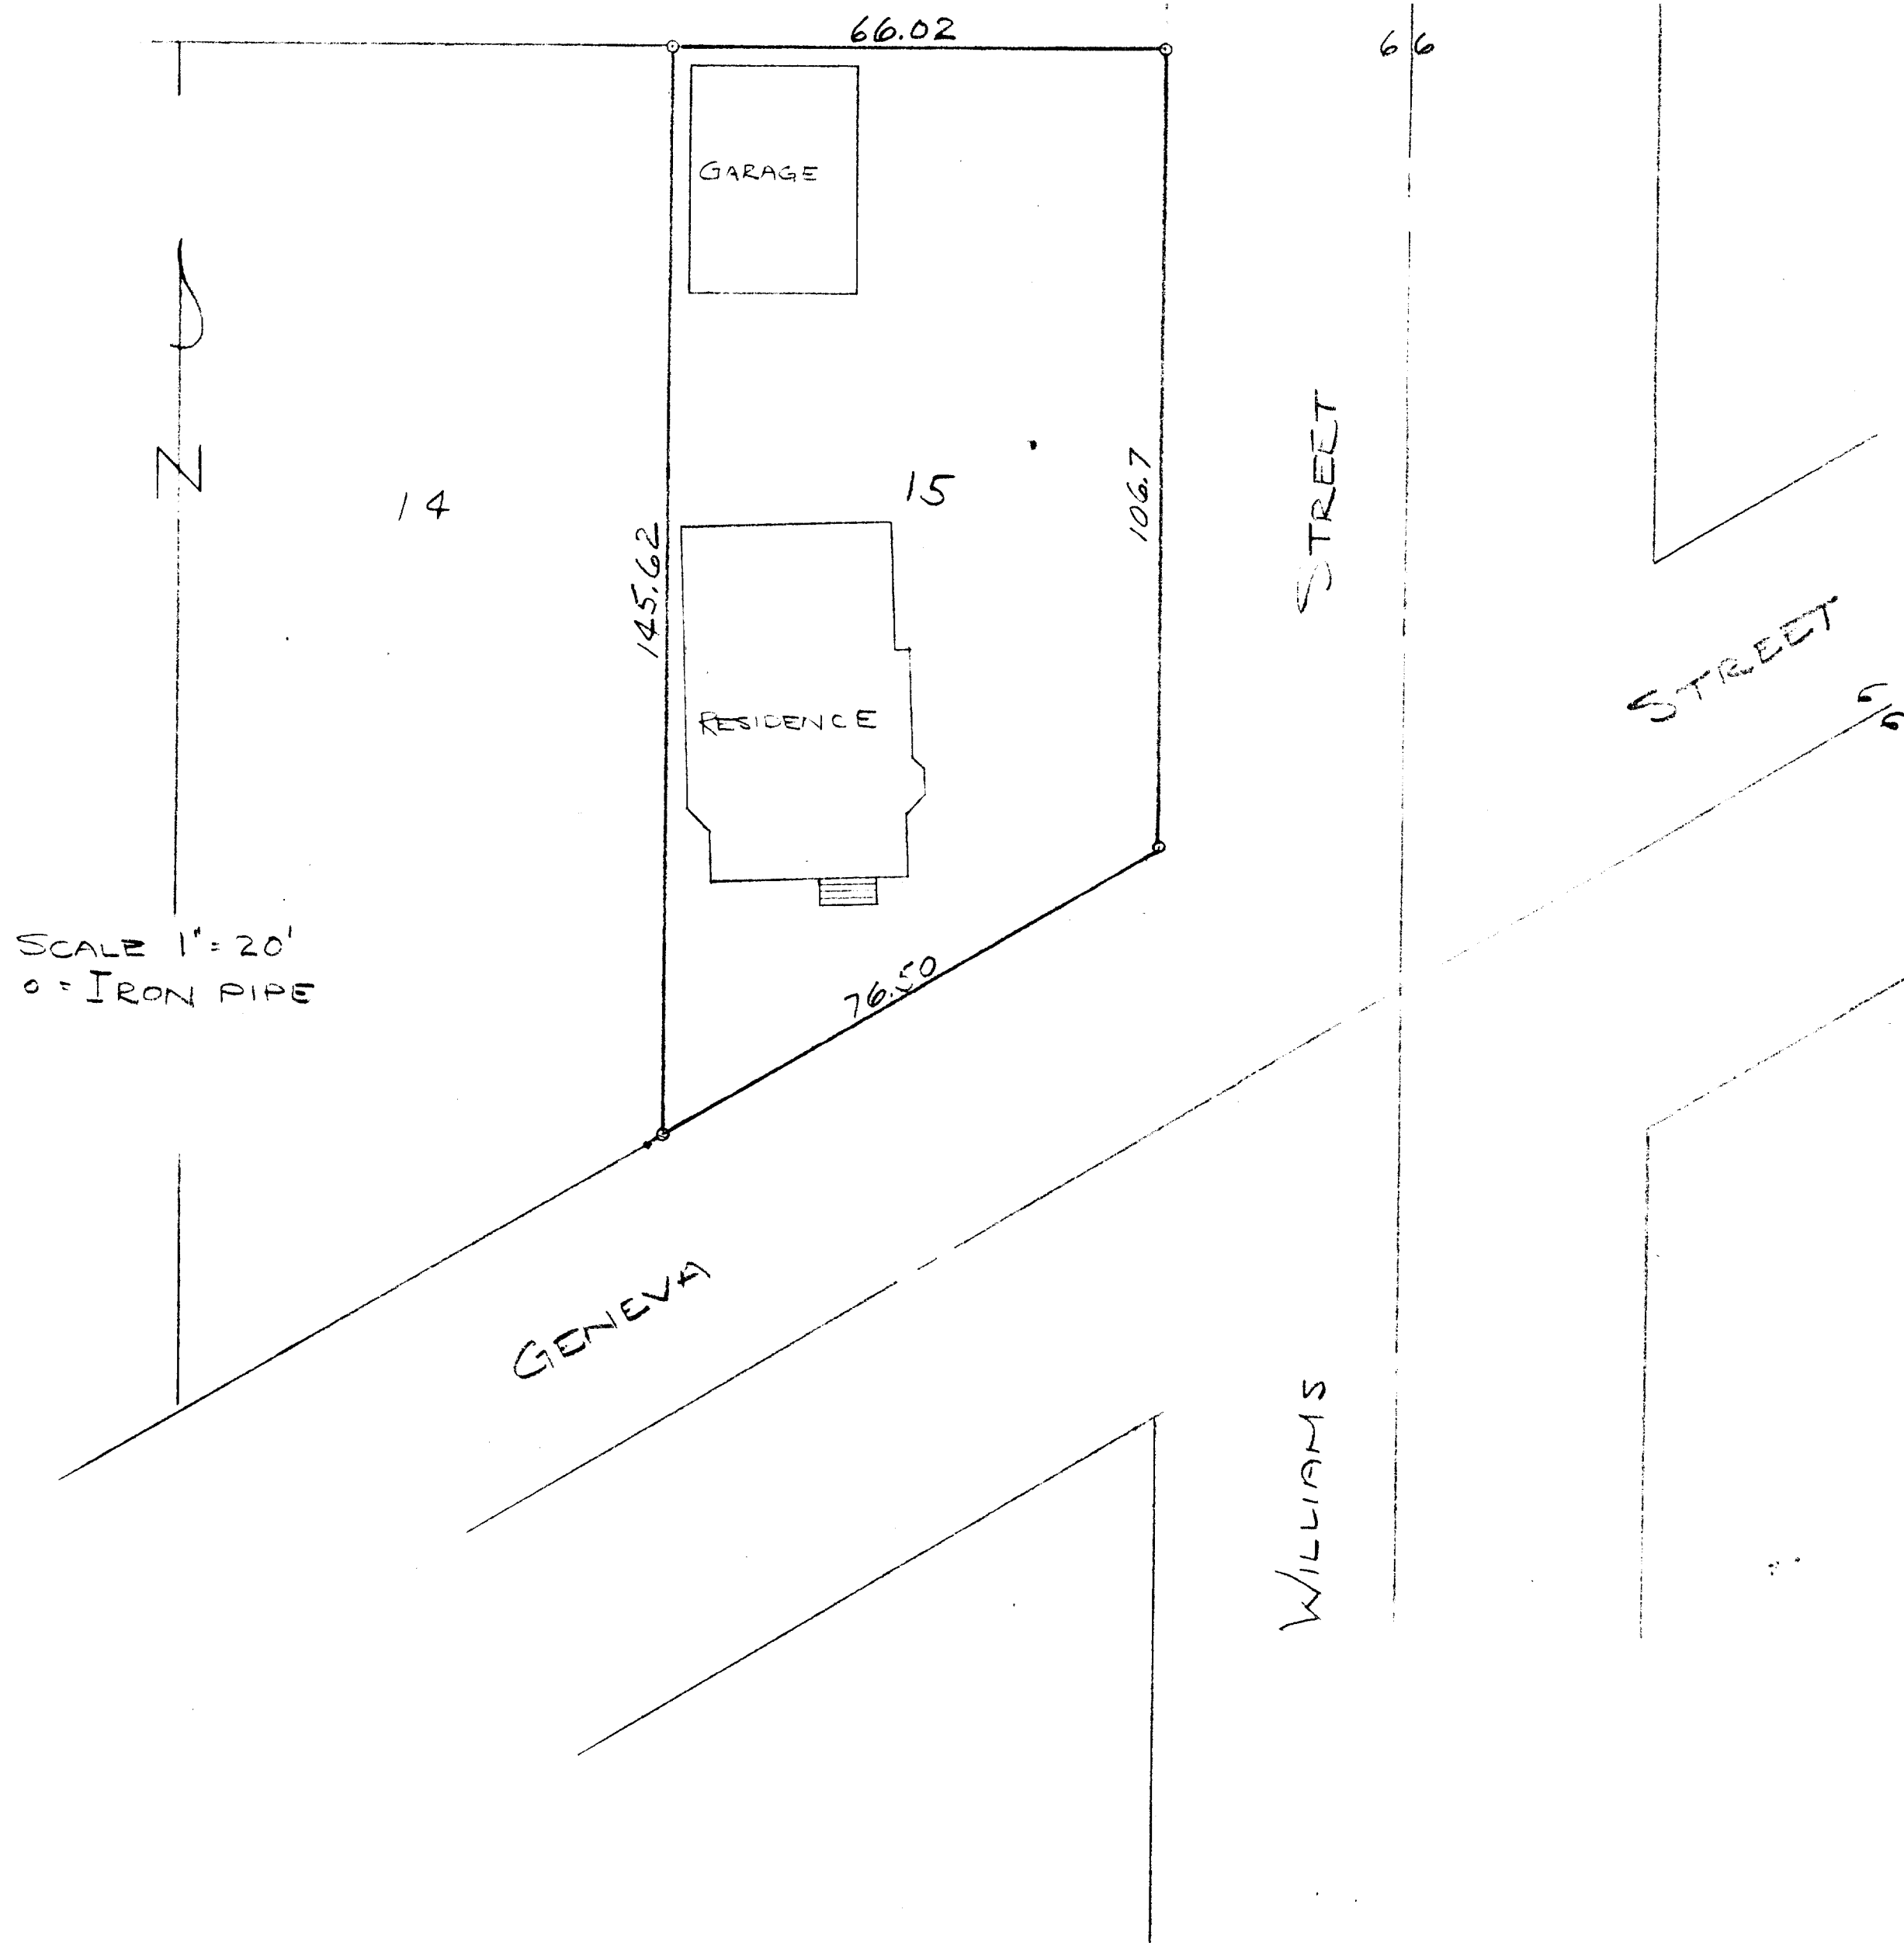

PLAT OF SURVEY OF LOT 15 OF BLOCK 9 OF
WILLIAMS 2ND ADDITION TO THE VILLAGE OF
WILLIAMS BAY, WALWORTH COUNTY, WISCONSIN

OCT. 1950

Lloyd L. Jensen
COUNTY SURVEYOR

11-85