
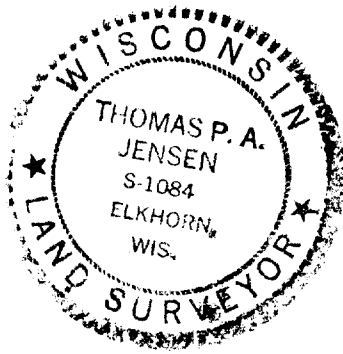
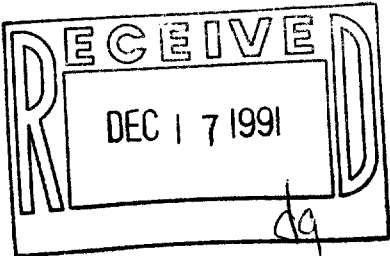


Plat of Survey  
of

The West line of Lot 21 of Lackey Brothers Subdivision, Village of  
Williams Bay, Walworth County, Wisconsin.

Surveyed for: Al Johnson  
83 Lackey Drive  
Williams Bay, Wisconsin. 53191

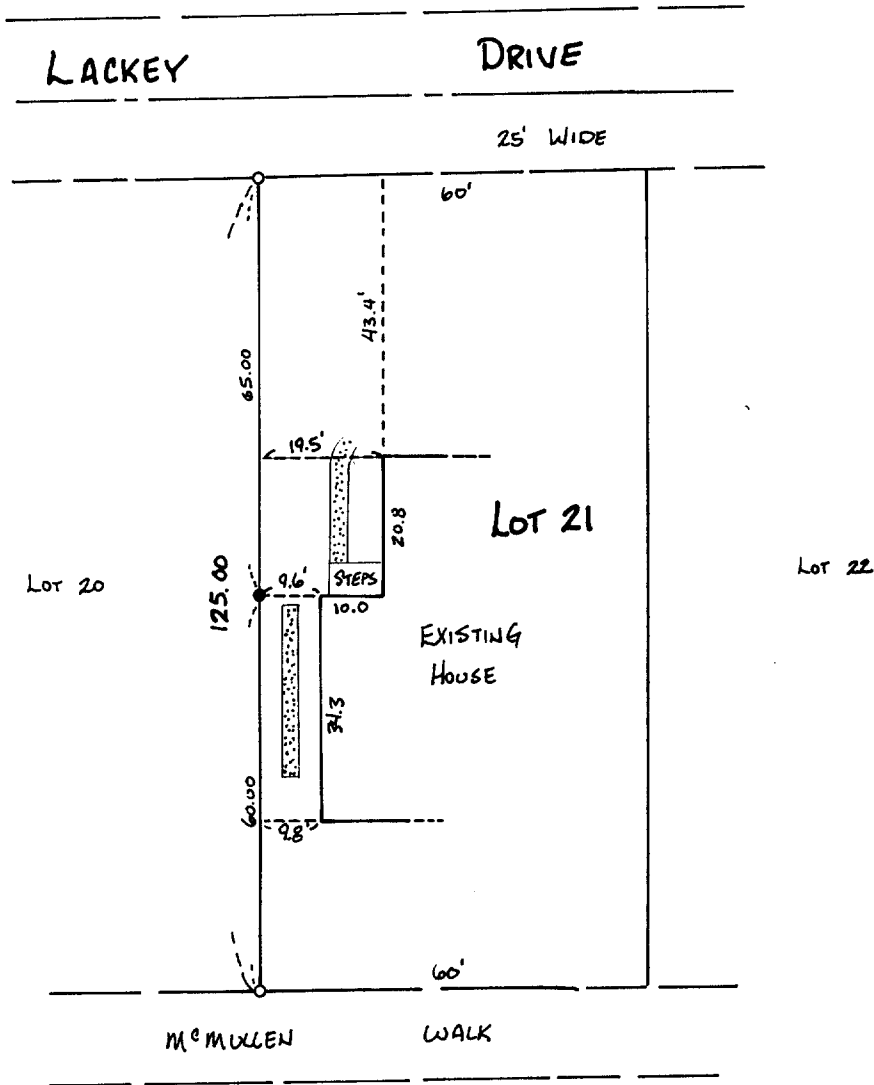

Copyright © 1990 by Jensen Surveying & Mapping S.C.  
All rights reserved. No part of this survey plat may be reproduced or transmitted in any form  
by any means - graphic, electronic, or mechanical, including photocopying, tracing, or infor-  
mation storage and retrieval systems - without permission in writing from Thomas P.A. Jensen.

I, Thomas P.A. Jensen, Wisconsin Registered Land Surveyor, do hereby certify that this  
survey was performed by me, or under my direction, in full compliance with the owner's/agent's  
instructions and Chapter A-E 7 of the Wisconsin Administrative Code 'Minimum Standards For  
Property Surveys', and that this map is an accurate representation thereof to the best of my  
knowledge and belief.

Note: This survey plat is not  
certified unless signed  
and sealed in red ink.

*Thomas P.A. Jensen*  
Thomas P.A. Jensen R.L.S. 1084

Legend

- o ~ Found iron pipe
- ~ Set iron rod 3/4 dia.
- ▨ ~ Concrete surface (SIDEWALK)

**Jensen Surveying & Mapping S.C.**  
45 South Wisconsin Street P.O. Box 322  
Elkhorn, Wisconsin. 53121.  
(414) 723-3434

Mapping date: October 2, 1990

Revisions: \_\_\_\_\_

Sheet 1 of 1 Sheets

Job reference number:

1990.152 X

Scale: 1 = 30'



011-867

WLB-21