


PLAT OF SURVEY

OF THE NORTH 22 FEET OF LOT 16 AND THE SOUTH 22 FEET OF LOT 13 BLOCK 13, OF WILLIAMS SECOND ADDITION TO THE VILLAGE OF WILLIAMS BAY, LOCATED IN THE N.E. 1/4 OF SECTION 1, TOWN 1 NORTH, RANGE 16 EAST, WALWORTH COUNTY, WISCONSIN.

JENSEN SURVEYING & MAPPING S.C.

P.O. Box 322 - ELKHORN, WI - 53121

(414) 723-3434

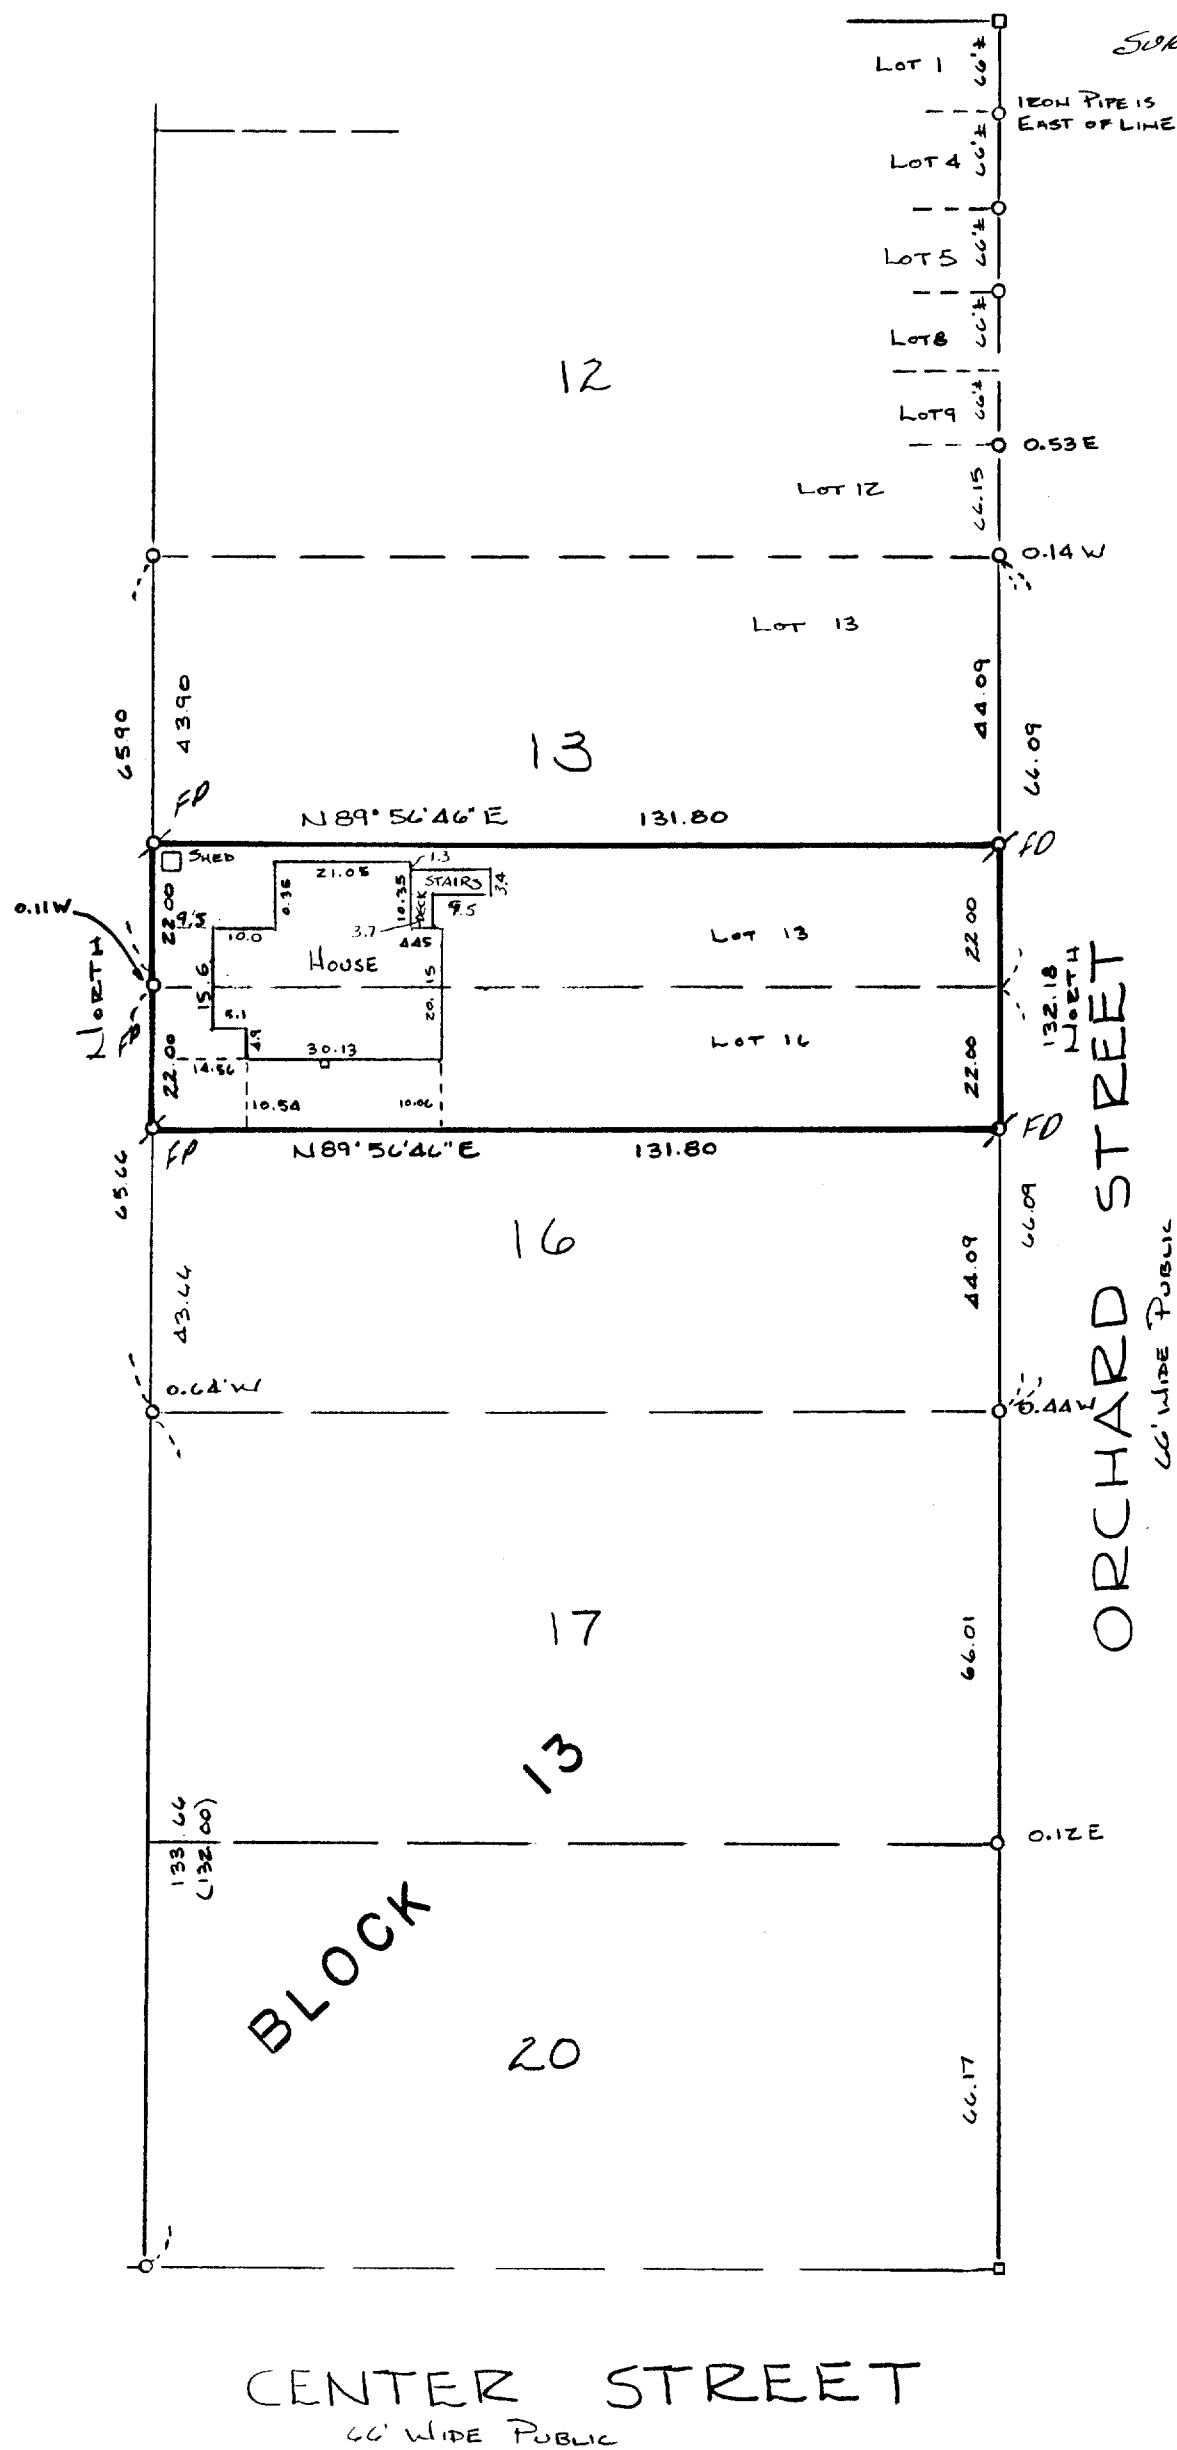

I, Thomas P.A. Jensen, Wisconsin Registered Land Surveyor, do hereby certify that this survey was performed by me or under my direction in full compliance with the owner's / agent's instructions and Chapter AE-5 of the Wisconsin Administrative Code "Minimum Standards for Property Surveys"; and that this map is an accurate representation thereof to the best of knowledge and belief.

REVISED: Aug 31, 1987
REVISED OCT. 2, 1991

11-874