


ABELL SURVEYING & MAPPING

DELAVAN, WISCONSIN 53115

414-728-6737

SPRING

STREET

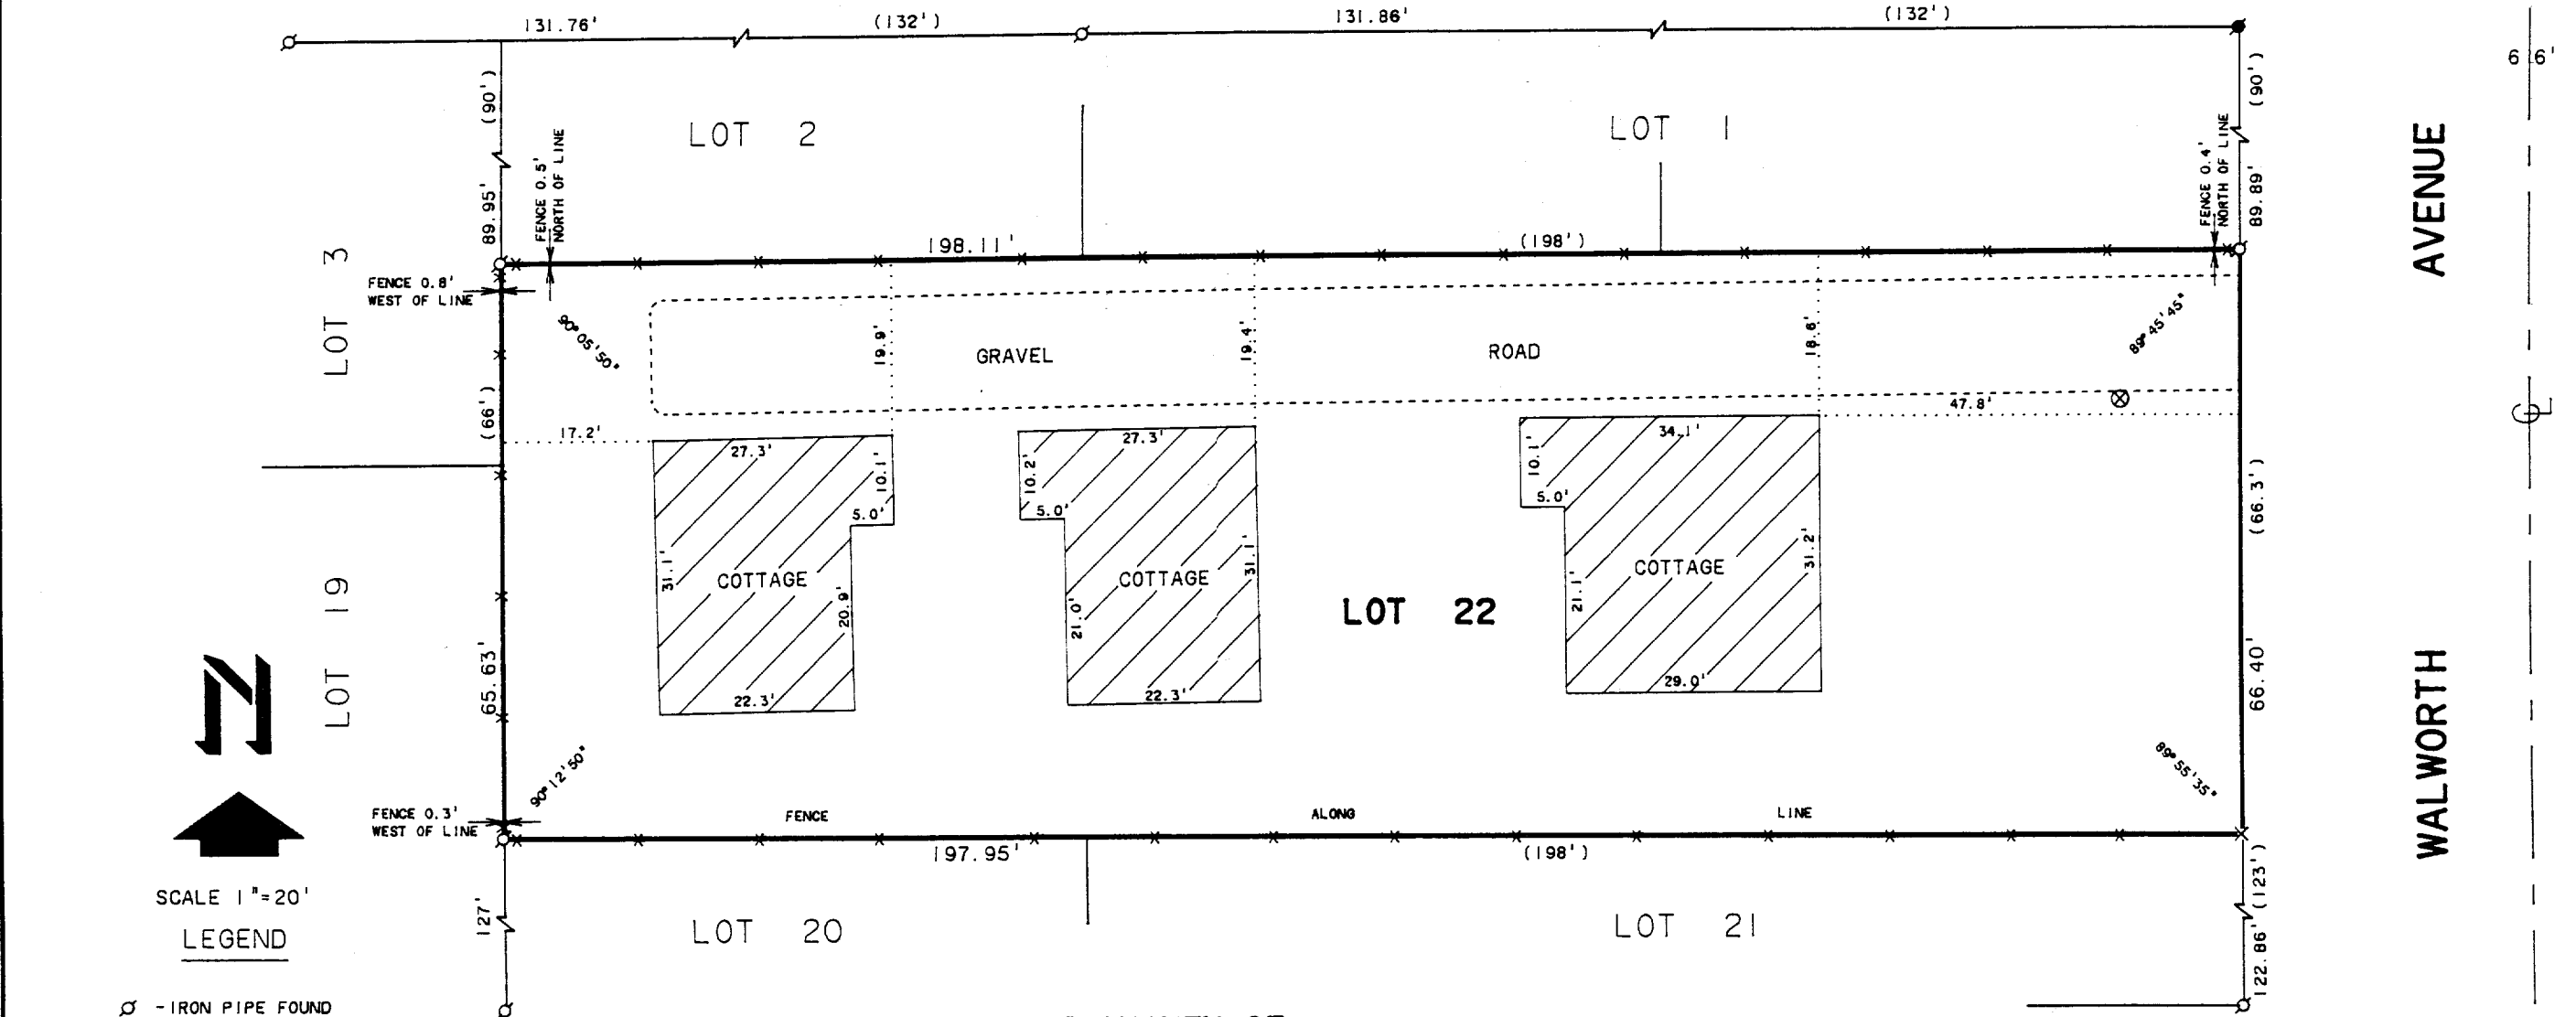

SCALE 1"=20'


LEGEND

- - IRON PIPE FOUND
- - IRON ROD FOUND
- × - CUT CROSS IN CONCRETE WALL FOUND
- ⊗ - MANHOLE COVER
- *— - FENCE
- () - RECORDED AS

ORDERED BY: JOHN BOUMENOT
P. O. BOX 653
DELAVAN, WI. 53115

PLAT OF SURVEY OF

LOT 22, JOHNSON'S ADDITION TO THE VILLAGE
OF WILLIAMS BAY, WALWORTH COUNTY, WISCONSIN.

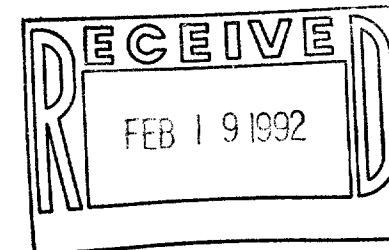

I, DAVID F. ABELL, DO HEREBY CERTIFY THAT I HAVE SURVEYED THE PROPERTY HEREON DESCRIBED ACCORDING TO THE OFFICAL RECORDS AND THAT THE PLAT HEREON IS A CORRECT REPRESENTATION OF THE PROPERTY LINES TO THE BEST OF MY KNOWLEDGE AND BELIEF.

David F. Abell

DAVID F. ABELL
WISCONSIN REGISTERED LAND SURVEYOR, S-1596

December 16, 1991

DATE: _____ JOB NUMBER: _____
NOTE: THIS IS NOT A CERTIFIED COPY UNLESS SEALED.

011-892

WJA-21