

PLAT OF SURVEY OF
LOT 164 OF CEDAR POINT
PARK 2ND ADDITION
VILLAGE OF WILLIAMS BAY
WALWORTH CO., WI.
FOR: DON DUDA


FARRIS, HANSEN & ASSOCIATES, INC.

7 RIDGEWAY COURT, P.O. BOX 437
ELKHORN, WISCONSIN 53121

PHONE: (414) 723-2048
FAX: (414) 723-6888



MAP SCALE IN FEET

GLEN VIEW RD.

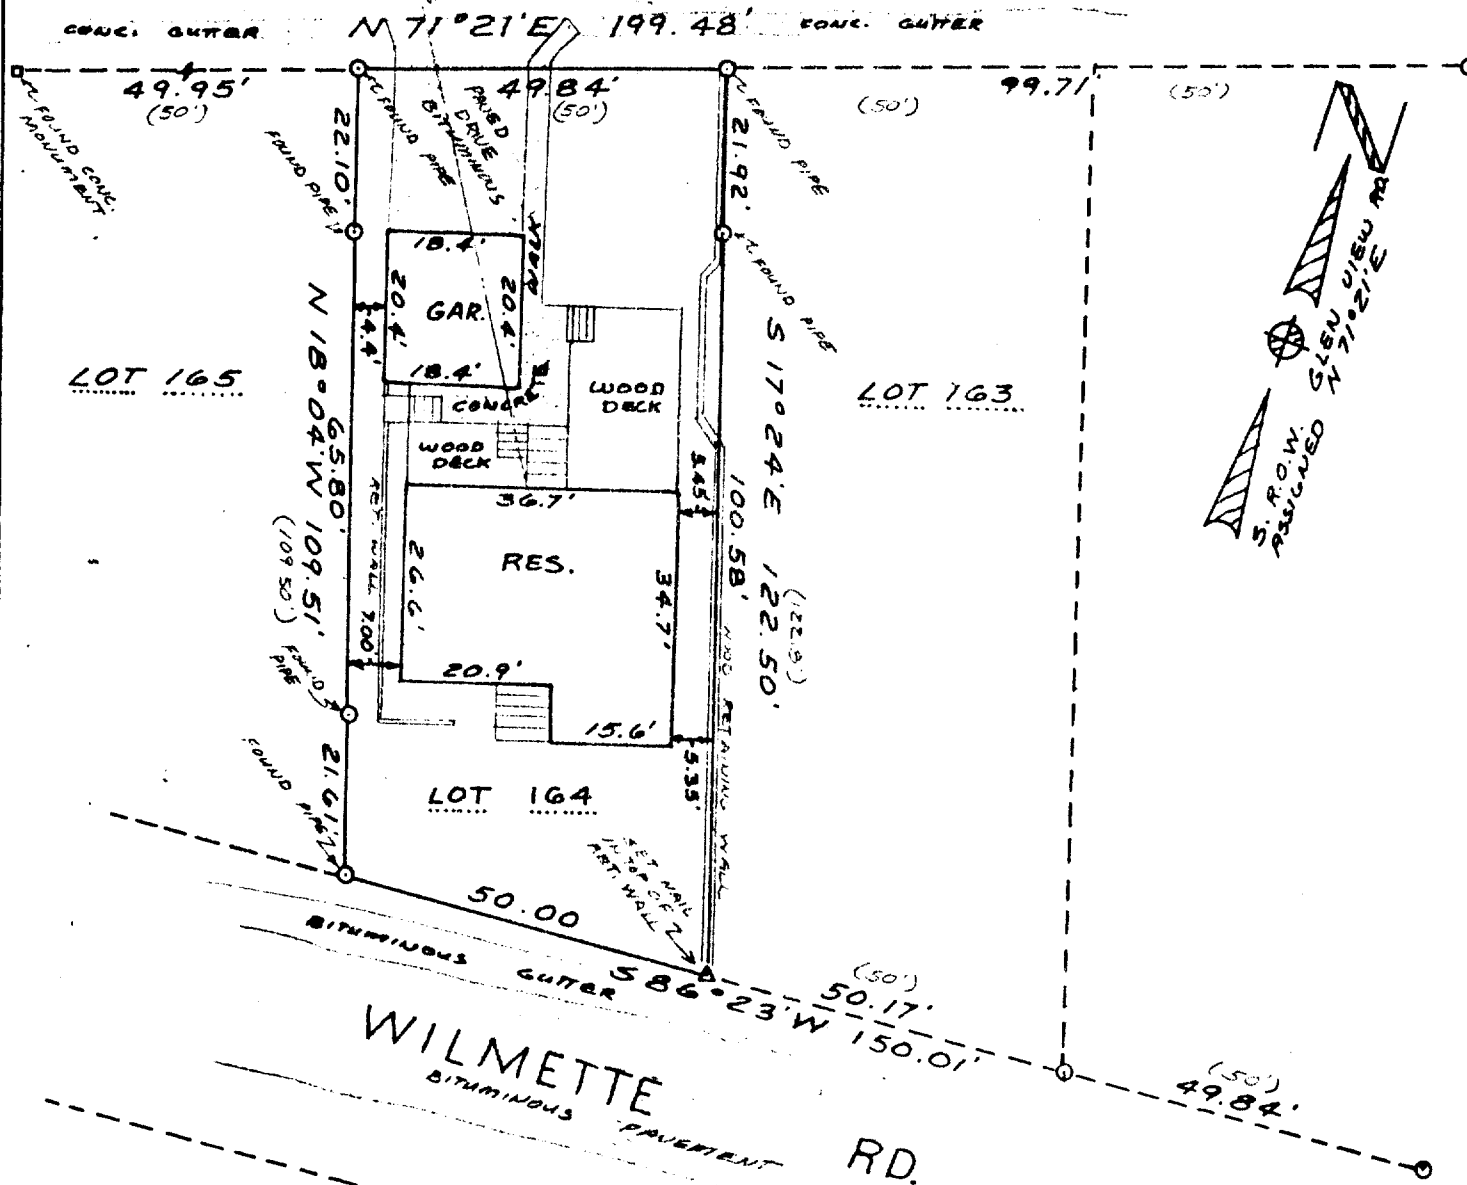

I hereby certify that I have surveyed the above described property and that the above map is a true representation thereof and shows the size and location of the property, its exterior boundaries, the location of all visible structures and dimensions of all principal buildings thereon, boundary enclosures, apparent easements, roadways and visible encroachments, if any. This survey is made for the use of the present owners of the property, and also those who purchase, mortgage, or guarantee the title thereto within one (1) year from the date hereof.

DATED: 11/15/91

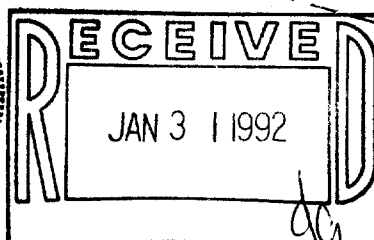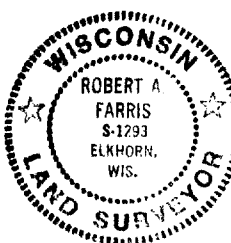

PROJECT NO. 3576

011-893

WCP2-56