


KOLB LAND CONSULTING, INC.
LAND SURVEYING • SUBDIVIDING • LAND PLANNING

929 WILLIAMS STREET LAKE GENEVA, WISCONSIN 53147 414-248-3697

CLEVELAND PARKWAY

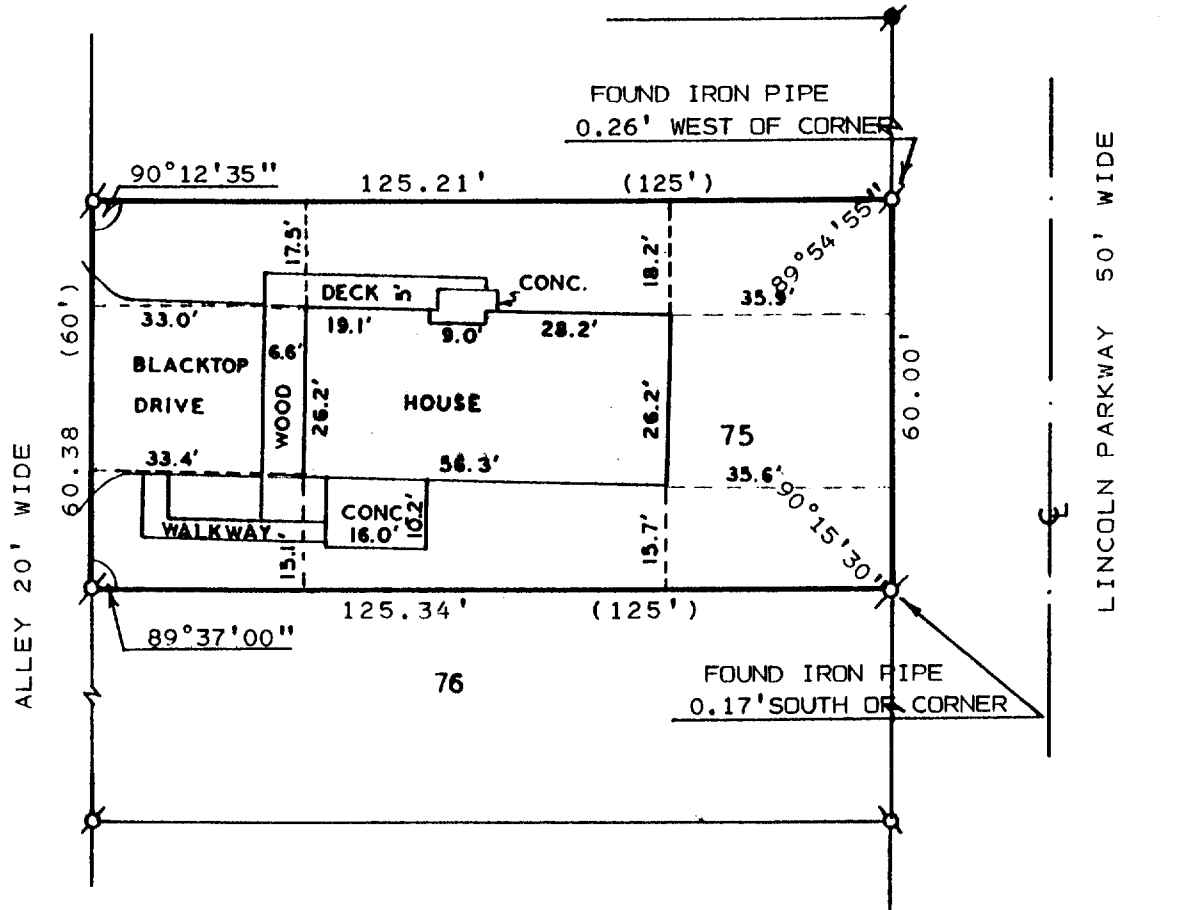

PLAT OF SURVEY OF

LOT 75 OF CEDAR POINT PARK, A SUBDIVISION
LOCATED IN THE VILLAGE OF WILLIAMS BAY,
WALWORTH COUNTY, WISCONSIN.




SCALE: 1" = 30'

ORDERED BY: MRS. HERBERT GUSTAVSON
P.O. BOX 15
WILLIAMS BAY, WI. 53191

LEGEND

- ⊕ - IRON PIPE FOUND
- - CONC. MONUMENT FOUND
- () - AS RECORDED

I, HAROLD H. KOLB, DO HEREBY CERTIFY
THAT I HAVE SURVEYED THE PROPERTY
HEREON DESCRIBED ACCORDING TO THE
OFFICIAL RECORDS AND THAT THE PLAT
HEREON IS A CORRECT REPRESENTATION
OF THE LOT LINES TO THE BEST OF MY
KNOWLEDGE AND BELIEF,
SURVEY NOT VALID UNLESS SURVEYOR'S
SIGNATURE IS IN RED.

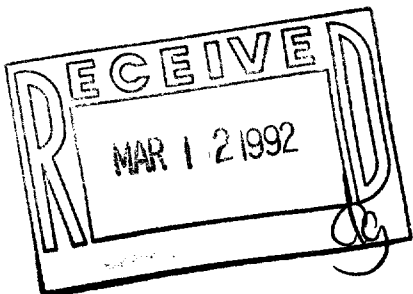

HAROLD H. KOLB

WISCONSIN REGISTERED LAND SURVEYOR, S-187

DATE JULY 16, 1991

REVISED _____

REVISED _____

011-898

WMB-176 WCP-59