


#62-70

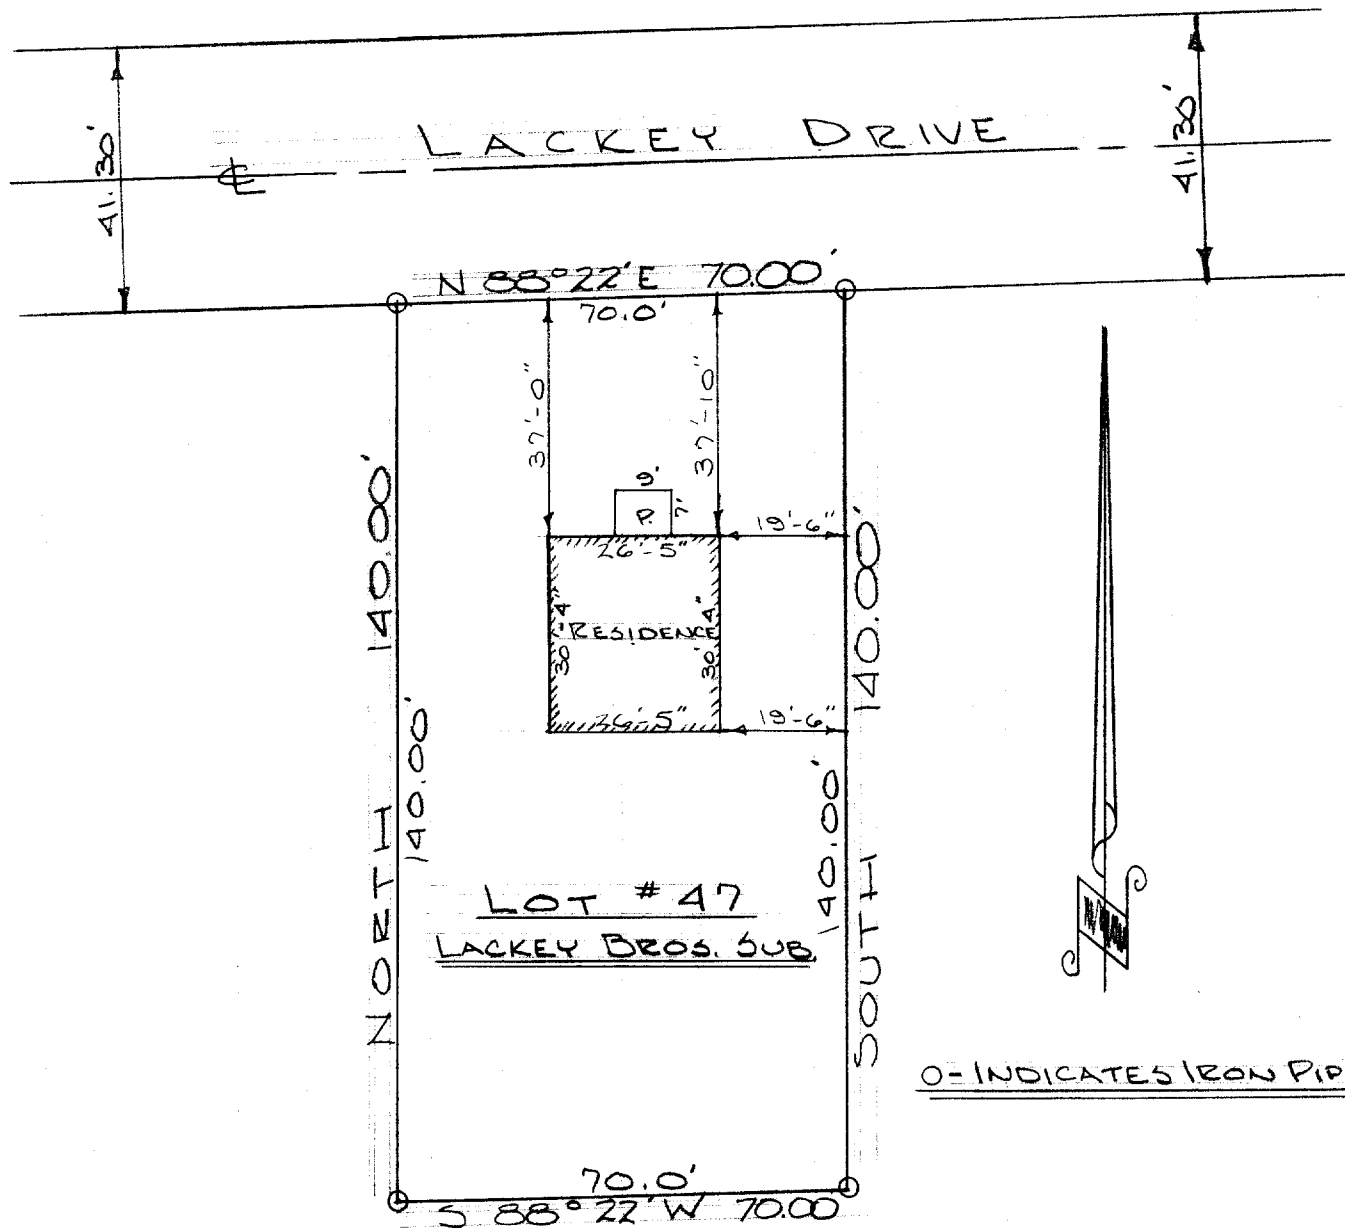


DESCRIPTION:

Lot 47 in Lackey Brothers Addition located in the Village of Williams Bay, Walworth County, Wisconsin.

CERTIFICATE:

I, James F. Biagi, surveyor, do hereby certify that I have surveyed the property hereon described and that the location of the improvements are as shown.

March 27, 1970.

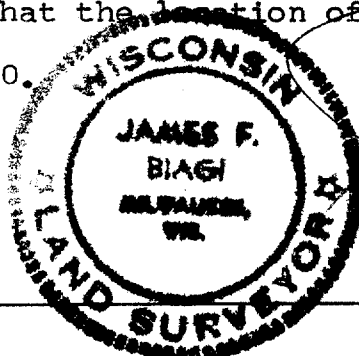

James F. Biagi, R.L.S. 272

11-8B