


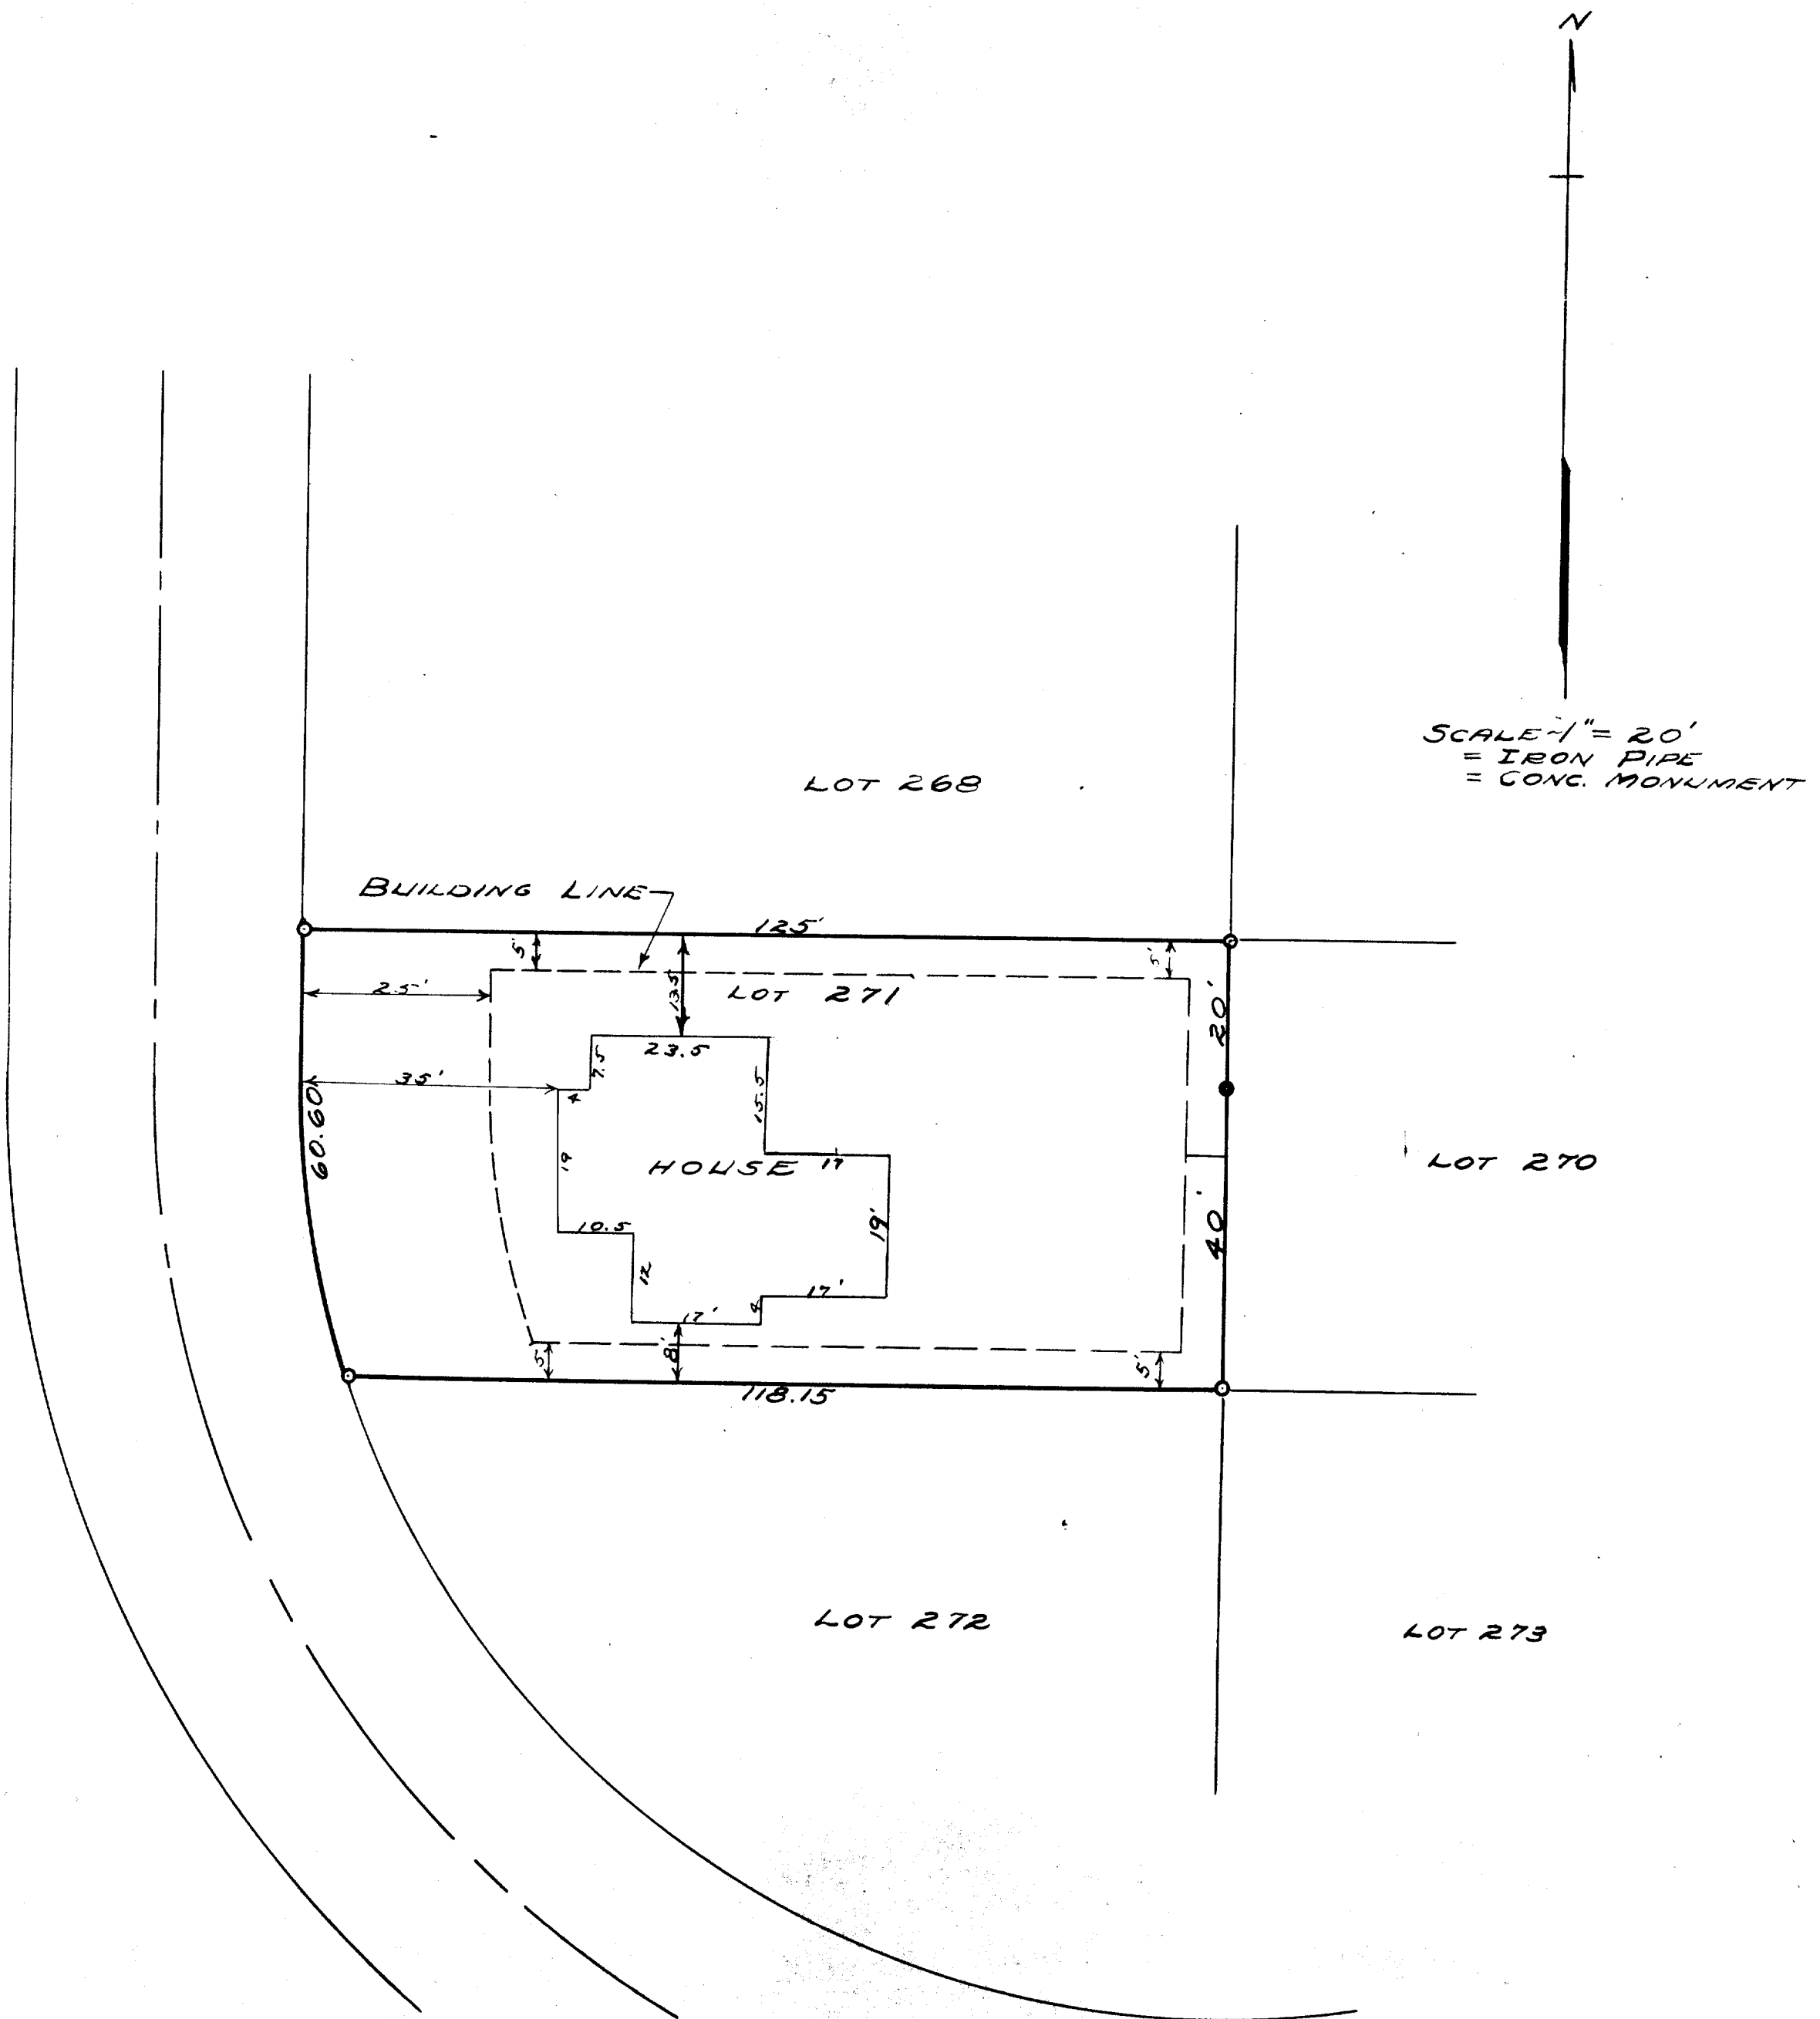

PLAT OF SURVEY OF LOT 271 OF THE THIRD ADDITION
TO CEDAR POINT PARK, WILLIAMS BAY, WALWORTH COUNTY, WISCONSIN.

CP3-60

JUNE 2, 1939

Lloyd Jensen
COUNTY SURVEYOR

11-8 J