


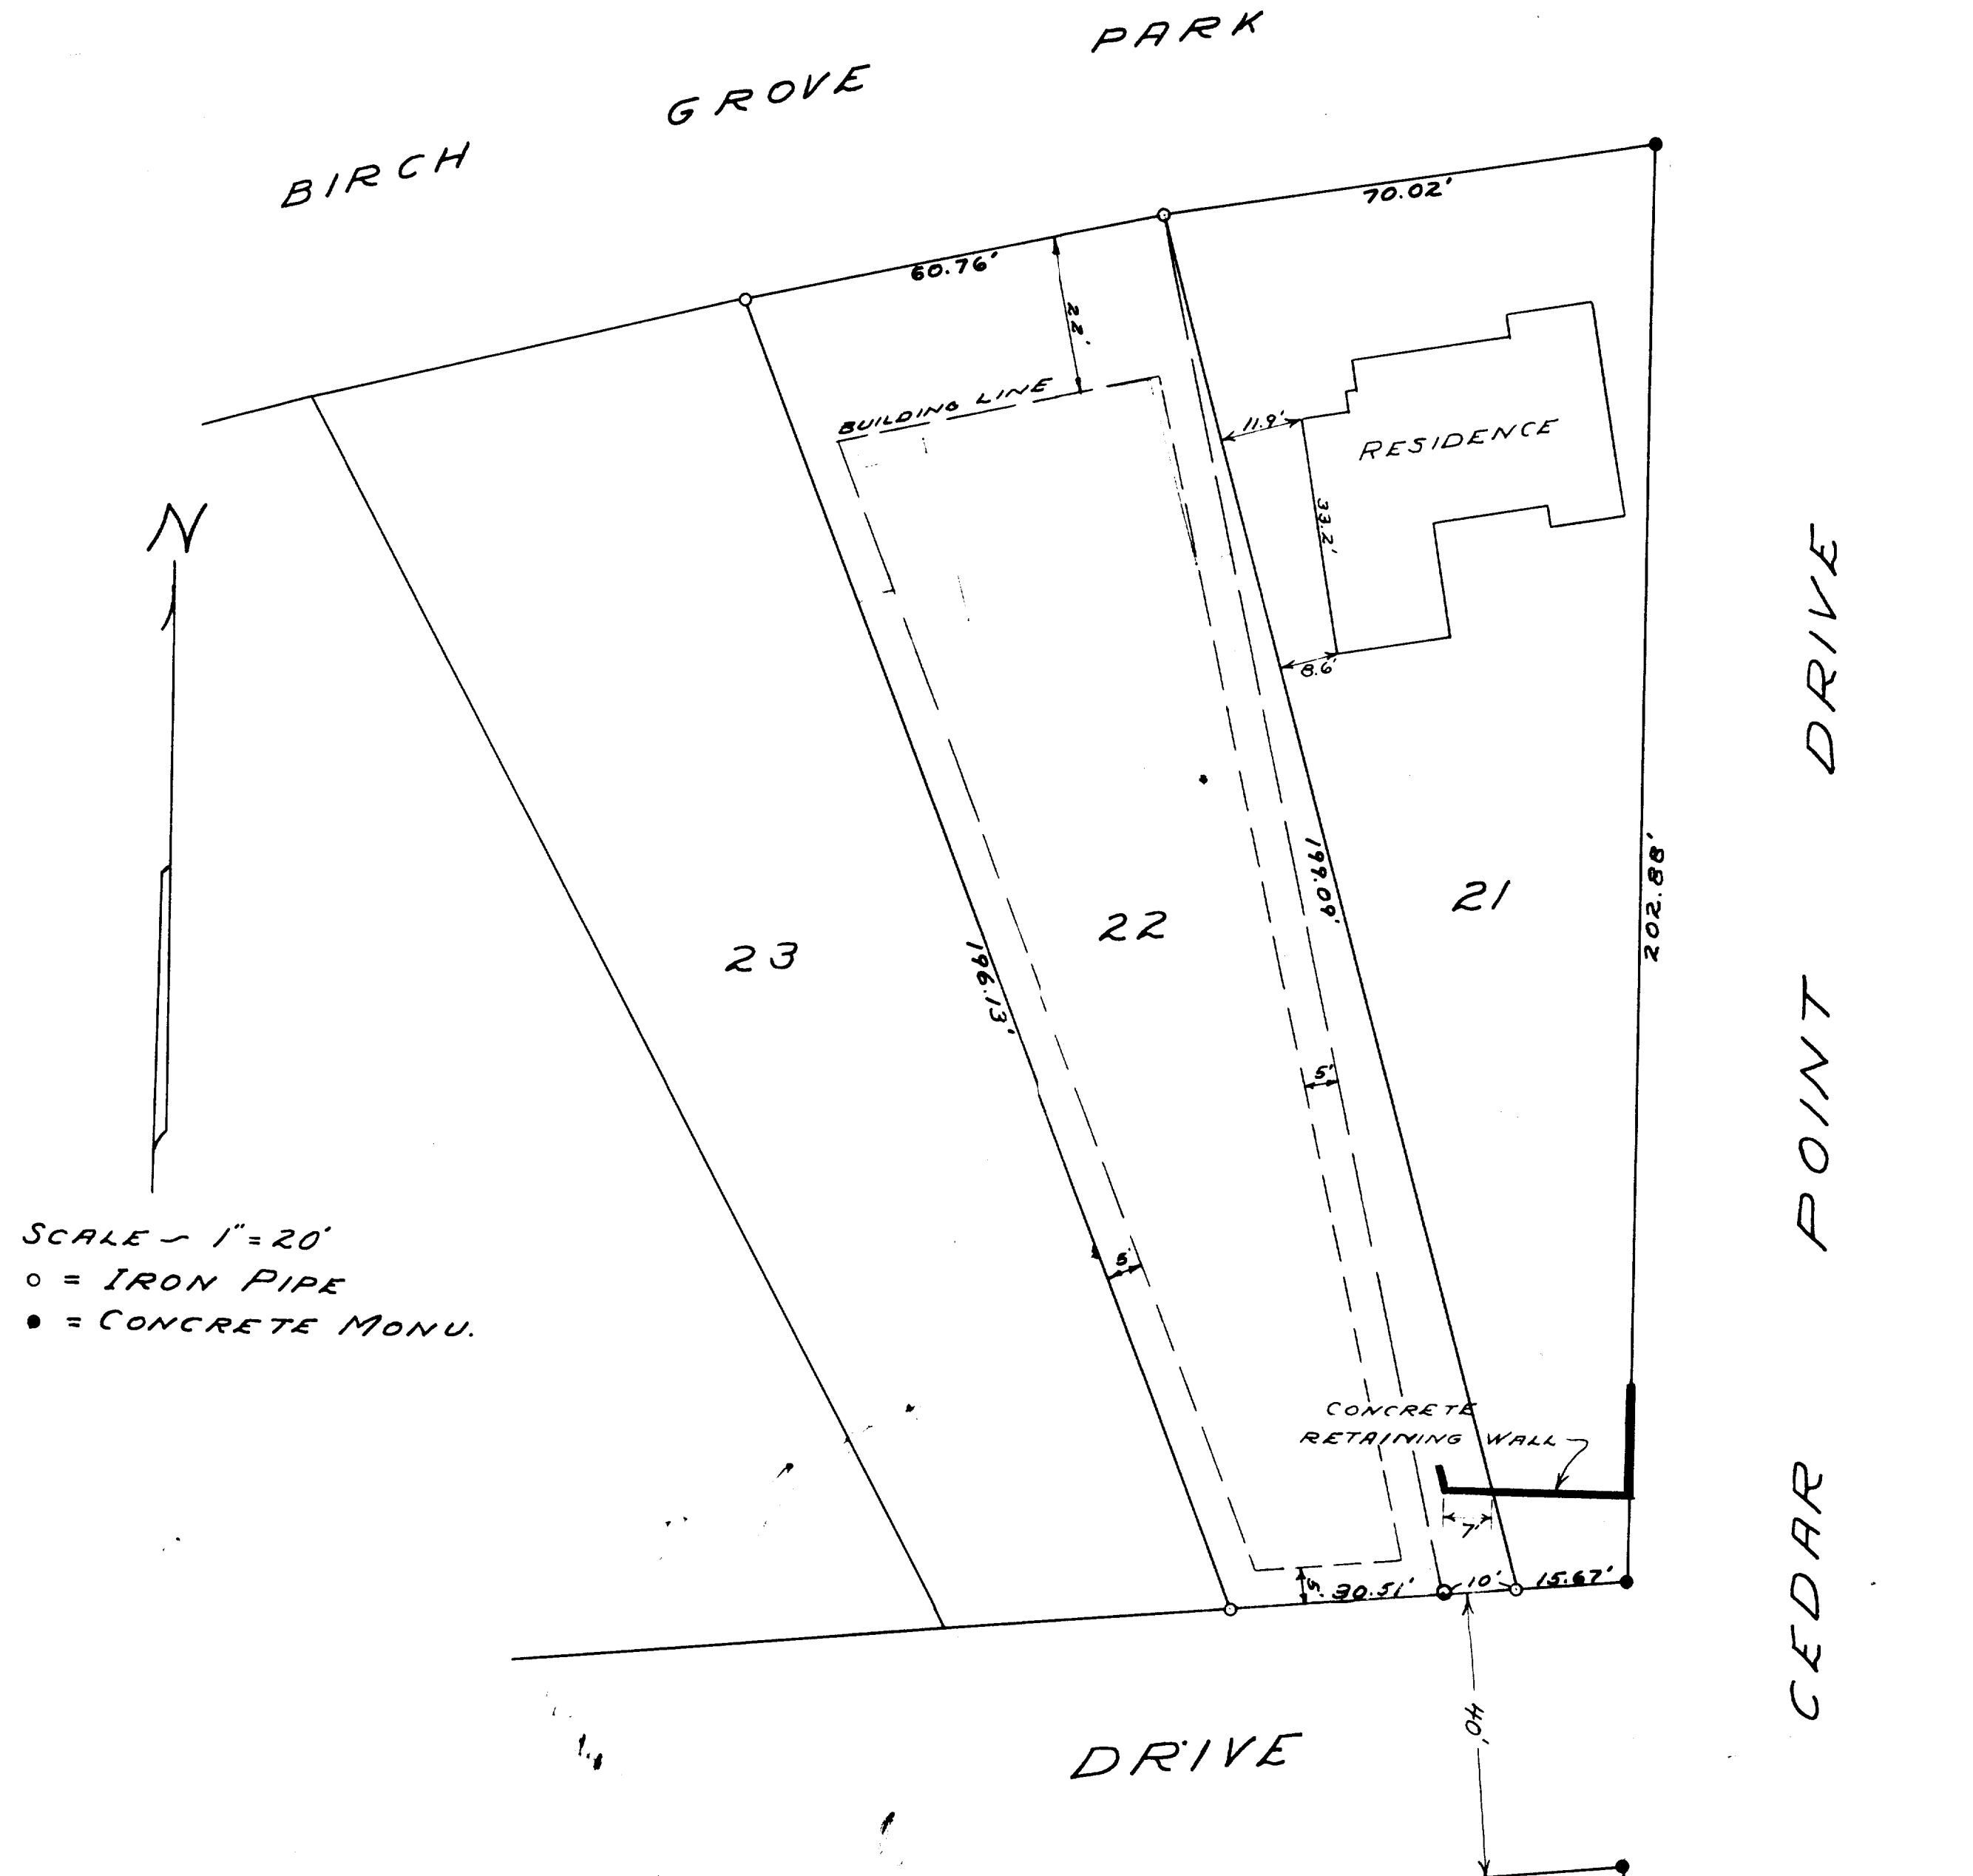

SCALE - 1" = 20'
 ○ = IRON PIPE
 ● = CONCRETE MONU.

PLAT OF SURVEY OF LOTS 21 AND 22 OF THE
 FIRST ADDITION TO CEDAR POINT PARK SUBDIVISION
 IN THE VILLAGE OF WILLIAMS BAY, WISCONSIN.
 WCD 1-22, 23
 JANUARY 1950
 Lloyd A. Jensen
 COUNTY SURVEYOR

11-915