


ABELL SURVEYING & MAPPING

DELAVER, WISCONSIN 53115


414-728-6737

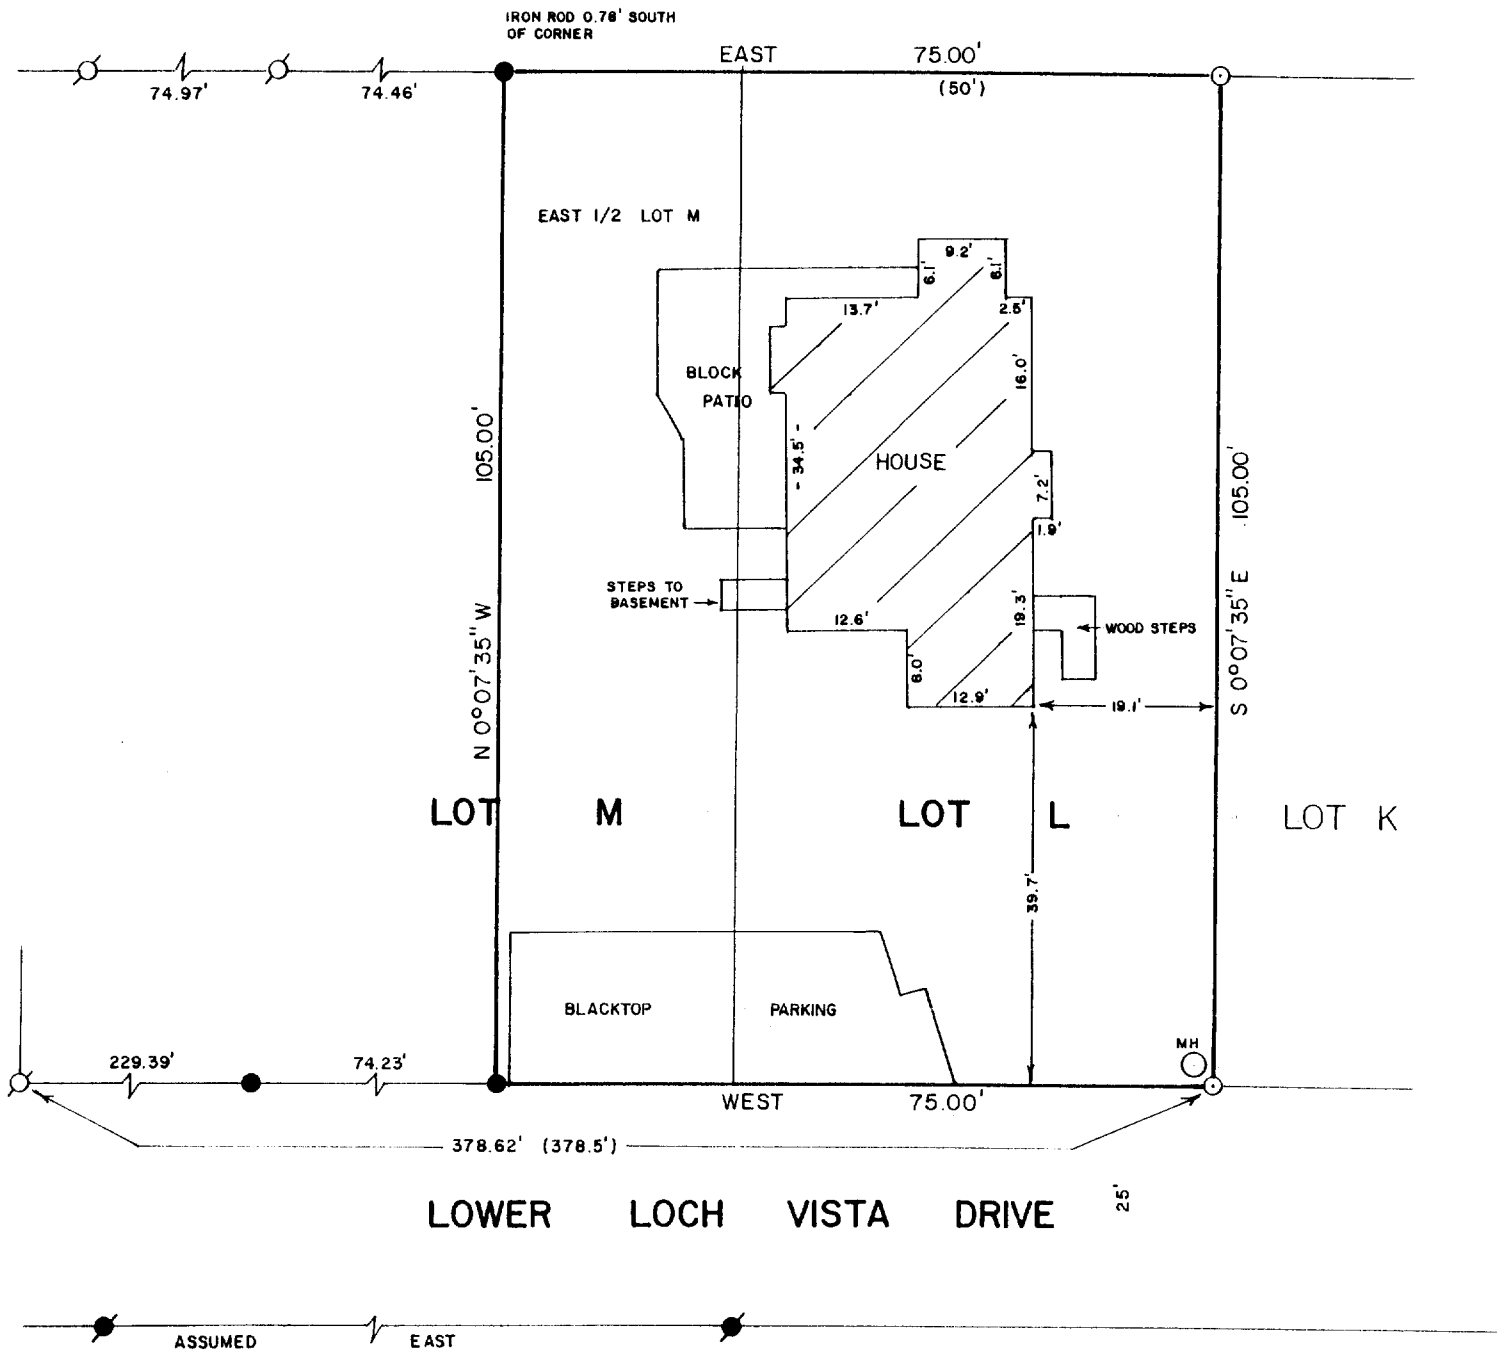

PLAT OF SURVEY OF

LOT L AND THE EAST 1/2 OF LOT M, LOCH VISTA CLUB
SUBDIVISION NO. 2, VILLAGE OF WILLIAMS BAY,
WALWORTH COUNTY, WISCONSIN.

ORDERED BY: KEEFE REAL ESTATE
704 MAIN STREET
LAKE GENEVA, WI. 53147

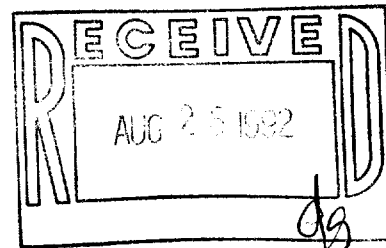

SCALE - 1"=20'

- LEGEND
- - IRON PIPE FOUND
 - - IRON ROD FOUND
 - - CONCRETE MONUMENT FOUND
 - - IRON PIPE SET
 - MH ○ - MANHOLE
 - () - RECORDED AS

I HEREBY CERTIFY THAT I HAVE SURVEYED THE ABOVE DESCRIBED PROPERTY AND THAT THE ABOVE MAP IS A TRUE REPRESENTATION THEREOF AND SHOWS THE SIZE AND LOCATION OF THE PROPERTY, ITS EXTERIOR BOUNDARIES, THE LOCATION OF ALL VISIBLE STRUCTURES AND DIMENSIONS OF ALL PRINCIPAL BUILDINGS THEREON, BOUNDARY FENCES, APPARENT EASEMENTS, ROADWAYS AND VISIBLE ENCROACHMENTS, IF ANY, TO THE BEST OF MY KNOWLEDGE AND BELIEF.

THIS SURVEY IS MADE FOR THE USE OF THE PRESENT OWNERS OF THE PROPERTY, AND ALSO THOSE WHO PURCHASE, MORTGAGE, OR GUARANTEE THE TITLE THERETO WITHIN ONE (1) YEAR FROM DATE HEREOF.

David F. Abell
DAVID F. ABELL

WISCONSIN REGISTERED LAND SURVEYOR, S-1596

May 19, 1992

DATE JOB NUMBER - 92080

NOTE: THIS IS NOT A CERTIFIED COPY UNLESS SEALED.