



HAROLD H. KOLB
 REGISTERED PROFESSIONAL LAND SURVEYOR
 LAKE GENEVA, WISCONSIN

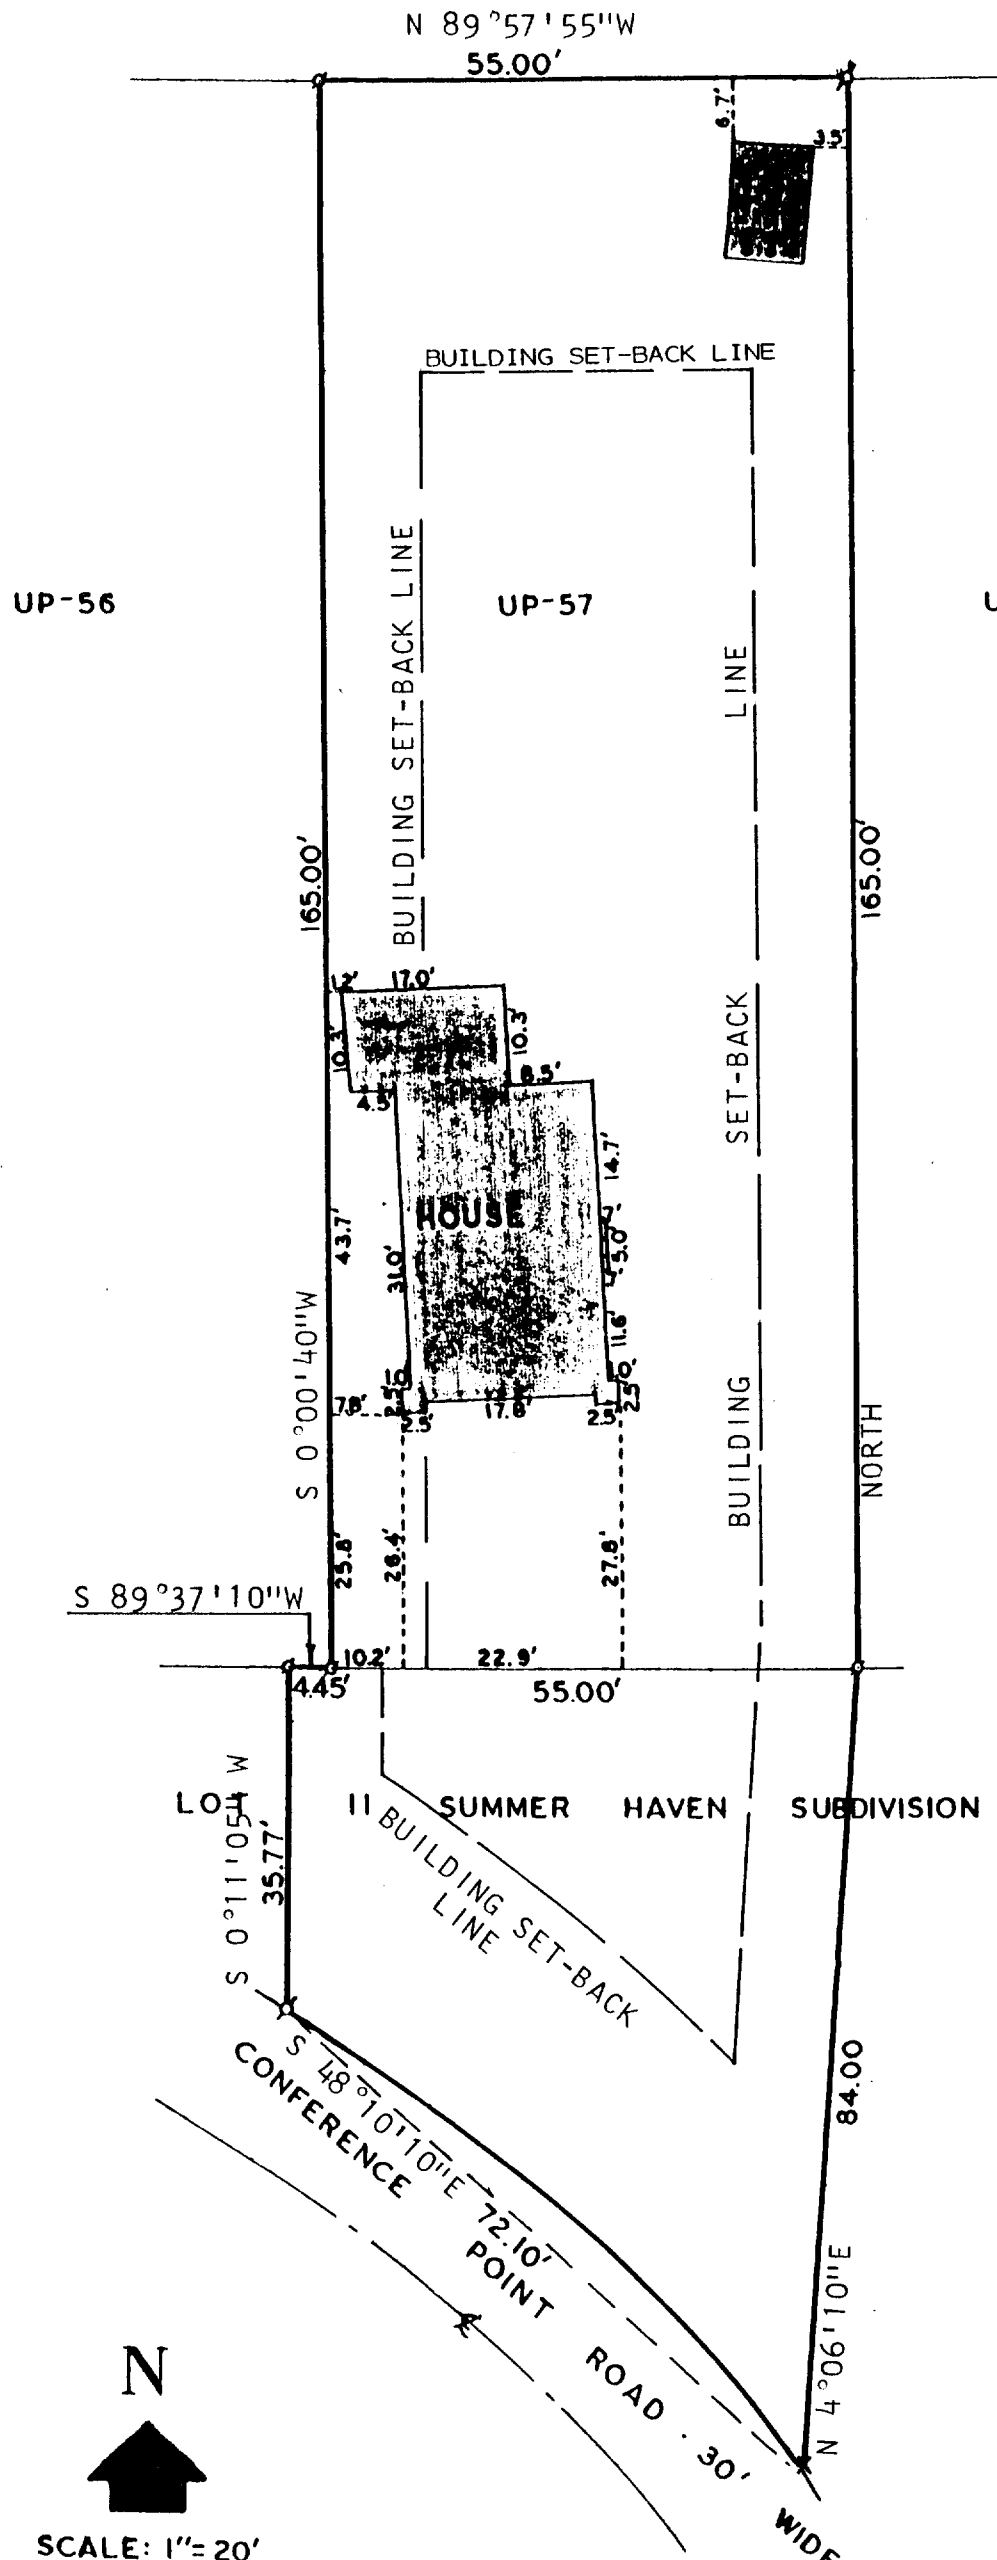

PLAT OF SURVEY OF

A PARCEL OF LAND LOCATED IN THE
 SOUTHEAST 1/4 OF SECTION 1, T1N,
 R16E, AND PART OF LOT 11 OF SUMMER
 HAVEN SUBDIVISION LOCATED IN THE
 VILLAGE OF WILLIAMS BAY, WALWORTH
 COUNTY, WISCONSIN.

OWNER: CARL NOVAK
 505 N. MAPLE ST.
 PROSPECT HEIGHTS, IL. 60070

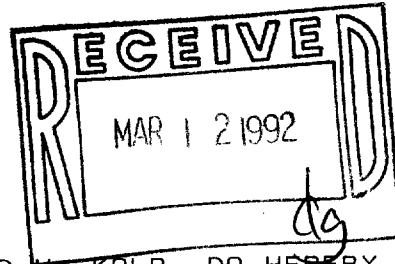

I, HAROLD H. KOLB, DO HEREBY CERTIFY
 THAT I HAVE SURVEYED THE PROPERTY
 HEREON DESCRIBED ACCORDING TO THE
 OFFICIAL RECORDS AND THAT THE PLAT
 HEREON IS A CORRECT REPRESENTATION
 OF THE LOT LINES TO THE BEST OF MY
 KNOWLEDGE AND BELIEF.
 SURVEY NOT VALID UNLESS SURVEYOR'S SIGNATURE
 IS IN RED.

HAROLD H. KOLB
 WISCONSIN REGISTERED LAND SURVEYOR, S-187
 DATE: OCTOBER 30, 1991

N

 SCALE: 1" = 20'
 LEGEND

- φ — IRON PIPE FOUND
- — IRON PIPE PLACED
- — CONCRETE MONUMENT
- x — SPIKE

