






**BAYWOOD HEIGHTS
ADDITION NO. 2**
Village of Williams Bay
Walworth County, Wisconsin

PLAT OF SURVEY
of
LOT 56
No. 354 FOREST DRIVE

FARRIS, HANSEN & ASSOCIATES, INC.
Engineering, Architecture, Surveying
7 Ridgway Court P.O. Box 437
ELKHORN, WISCONSIN 53121
Office: (414) 723-2098
Fax: (414) 723-5886


REVISIONS

PROJECT NO.
3228
DATE
03/16/93
SHEET NO.
1 of 1

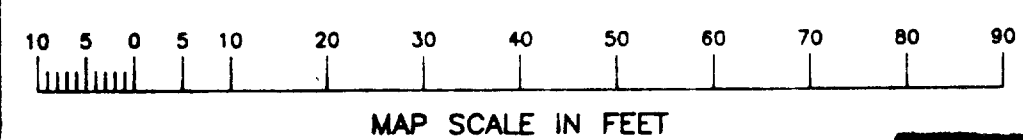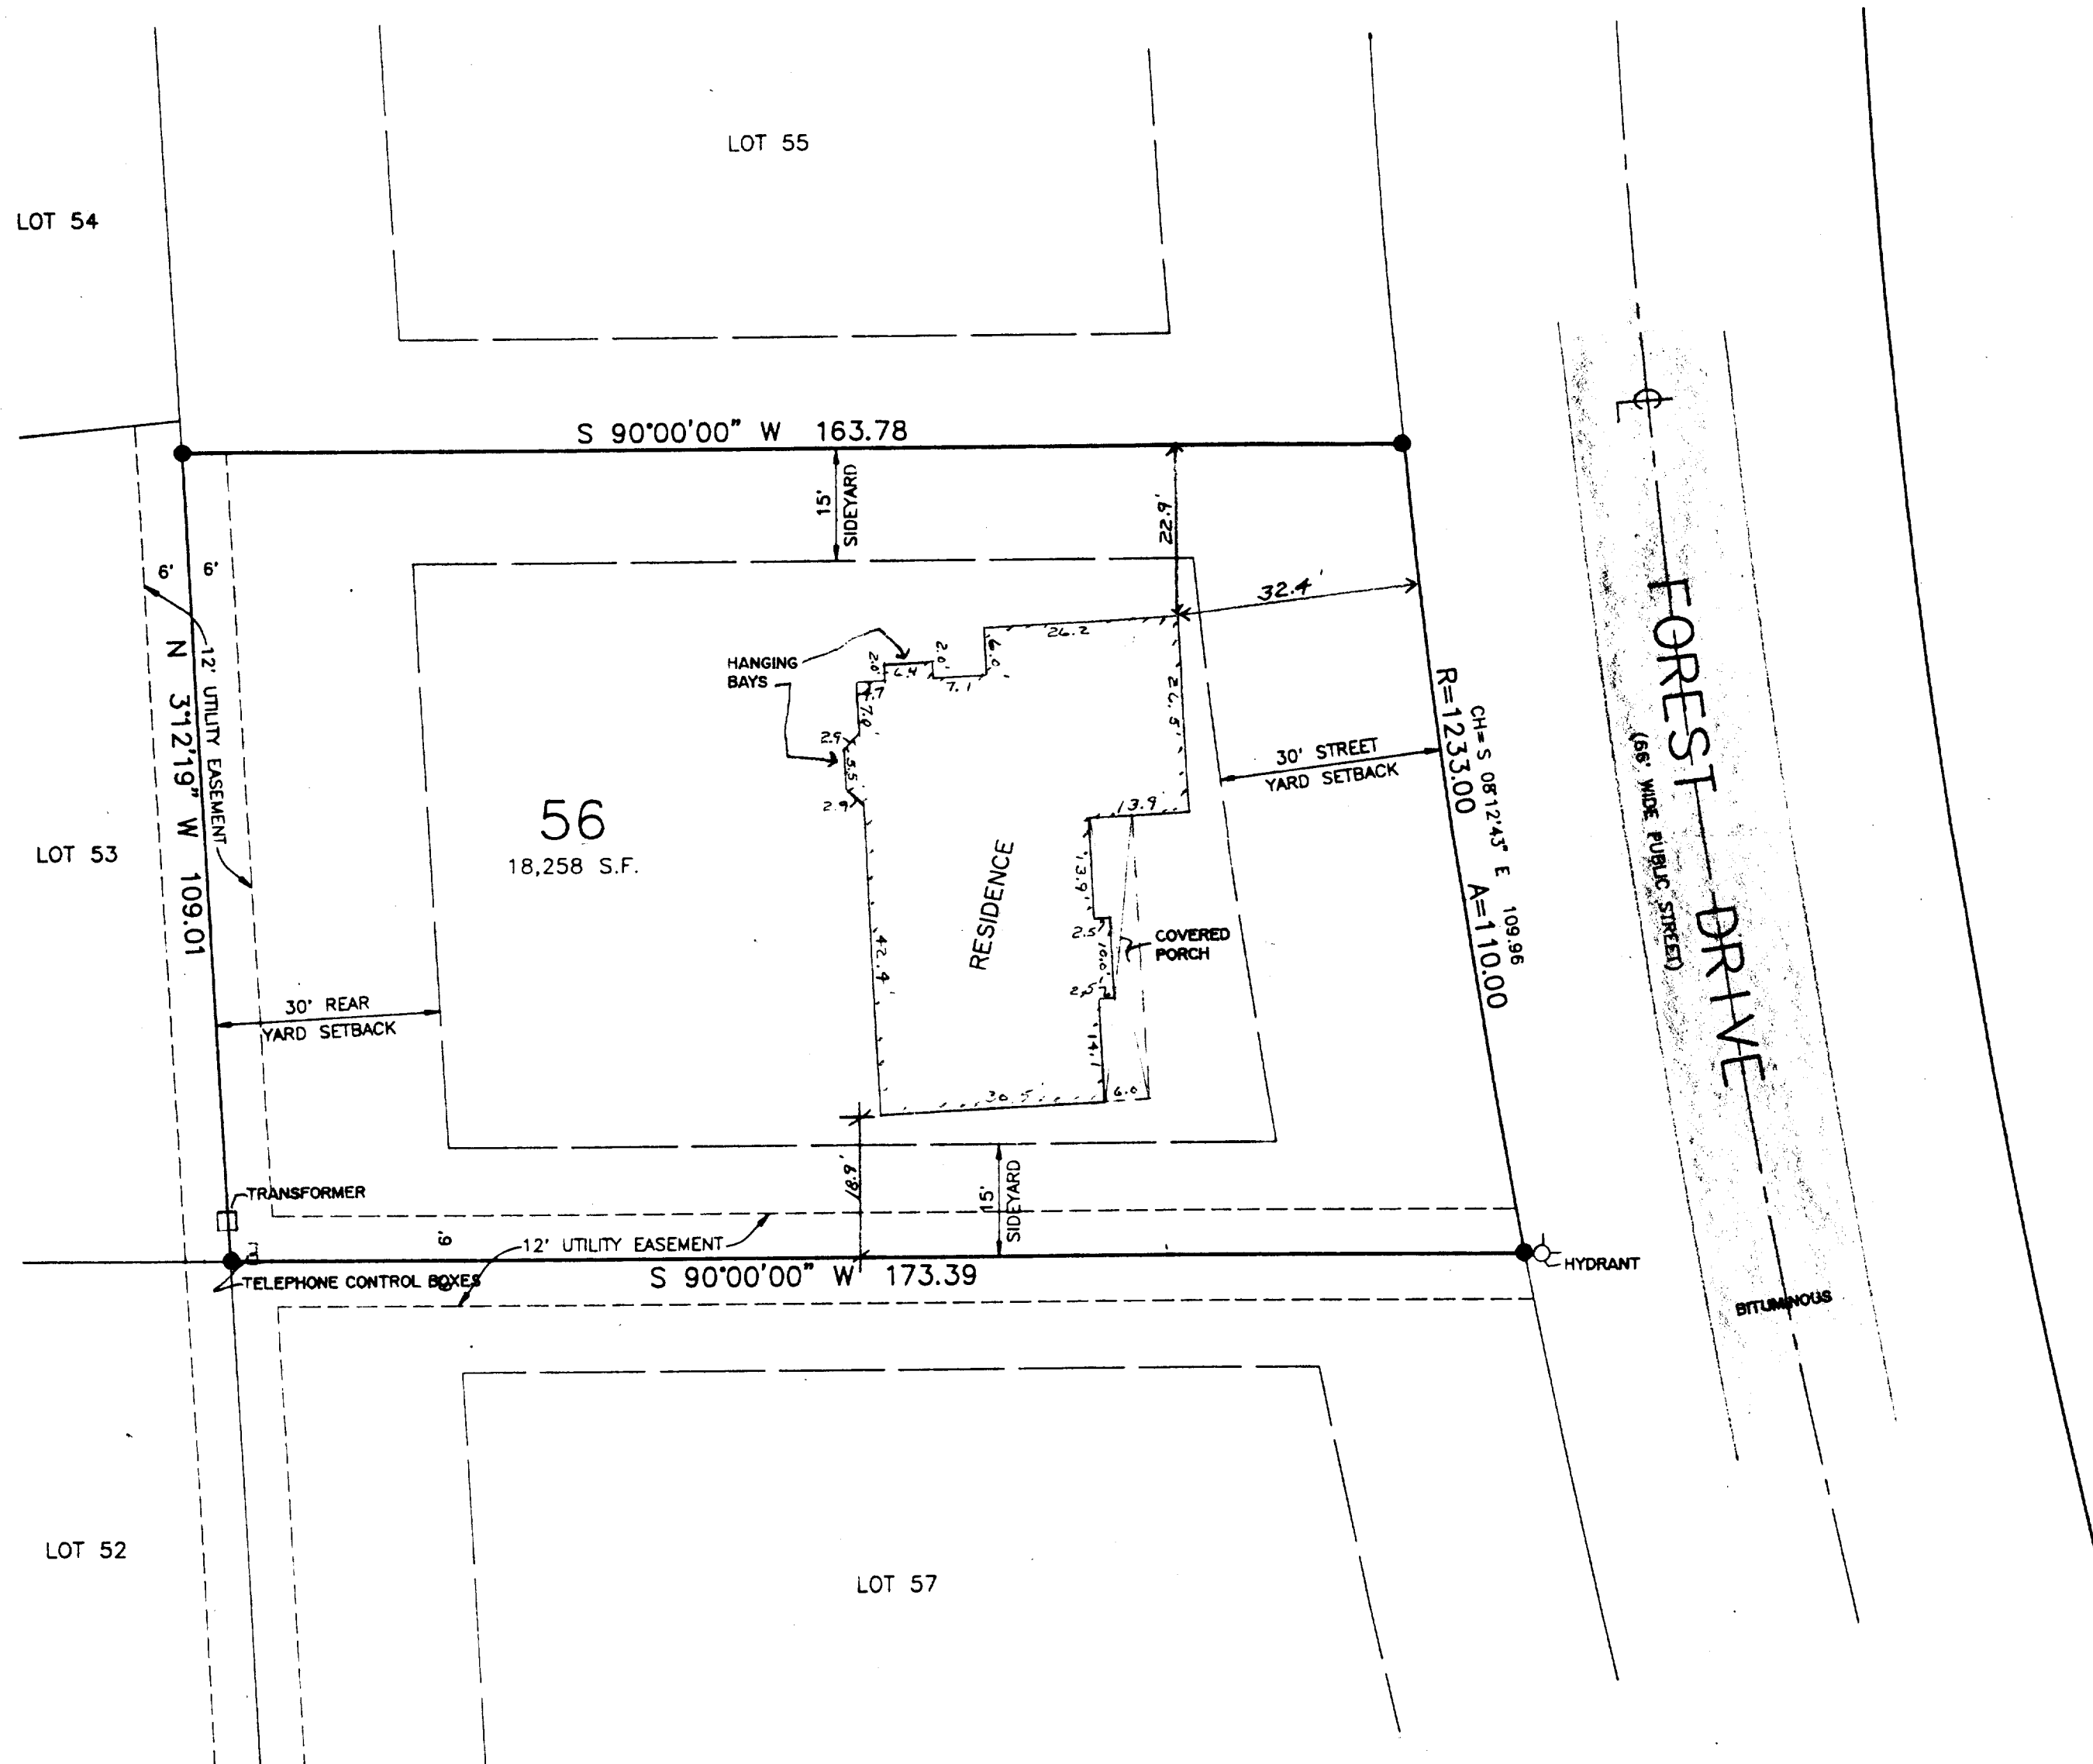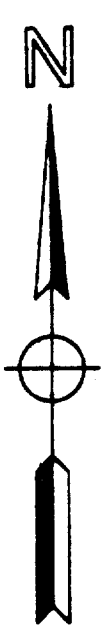

- MAP LEGEND**
- ⊗ = IRON PIPE STAKE FOUND - 1" DIA.
 - ⊙ = IRON PIPE STAKE FOUND - 1.5" DIA.
 - ⊕ = IRON PIPE STAKE FOUND - 2" DIA.
 - ⊙ = IRON REBAR STAKE FOUND - 0.75" DIA.
 - ⊙ = CONCRETE MONUMENT FOUND - 6" DIA.
 - ⊙ = IRON REBAR STAKE SET - 1.2" DIA X 30" X 4.3 LB/FT
 - ALL OTHER LOT CORNERS = IRON REBAR STAKE SET - 0.75" DIA. X 24" X 1.3 LB/FT

WORK ORDERED BY: CHOYCE ENTERPRISES

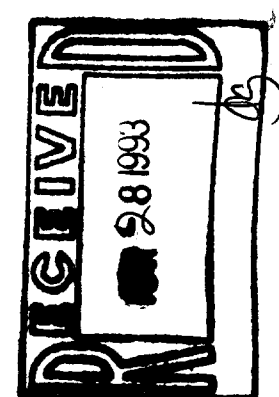

LEGAL DESCRIPTION OF LAND SURVEYED:
LOT 56 OF BAYWOOD HEIGHTS ADDITION NO. 2 IN THE VILLAGE OF WILLIAMS BAY, WALWORTH COUNTY, WISCONSIN
ACCORDING TO THE PLAT THEREOF RECORDED WITH THE WALWORTH COUNTY REGISTER OF DEEDS IN CABINET B OF
PLATS ON SLIDE 97 AS DOCUMENT NO. 197248.

**NOTE: COPIES OF THIS MAP TO WHICH THE FOLLOWING CERTIFICATE WILL
APPLY ARE BLUE LINE PRINTS SHOWING SURVEYOR'S ORIGINAL SEAL AND
SIGNATURE IN BLACK INK. COPIES BY ANY OTHER MEANS MAY HAVE
ALTERATIONS WHICH DO NOT REPRESENT THE SURVEYOR'S WORK PRODUCT.**

**I HEREBY CERTIFY THAT THIS PLAT OF SURVEY IS A TRUE AND ACCURATE
REPRESENTATION OF THE BOUNDARY LINES OF THE SUBJECT PARCEL AND
SHOWS THE SIZE AND LOCATION OF ALL BUILDINGS ON THE PARCEL SHOWN
HEREON, TO THE BEST OF MY PROFESSIONAL KNOWLEDGE AND BELIEF. THIS
SURVEY IS MADE FOR THE USE OF THE PRESENT OWNERS OF THE PROPERTY,
AND ALSO THOSE WHO PURCHASE, MORTGAGE, OR GUARANTEE THE TITLE
THERE TO WITHIN ONE YEAR FROM THE DATE HEREOF.**

DATED: **03/16/1993** *Peter S. Gordon*
PETER S. GORDON RLS 2101

