

FARRIS, HANSEN & ASSOCIATES, INC.

7 RIDGEWAY COURT, P.O. BOX 437
ELKHORN, WISCONSIN 53121

PLAT OF SURVEY


PHONE: (414) 723-2098
FAX: (414) 723-5886

LOCATION: LOT 8 OF BLOCK 10
WILLIAMS 2nd ADDITION TO THE VILLAGE OF
WILLIAMS BAY, WALWORTH COUNTY, WI.

WORK ORDERED BY: STEVE BEERS FOR
JERRY MEYERS

MAP LEGEND

- = IRON PIPE STAKE FOUND
- = IRON PIPE STAKE SET
- = IRON ROD STAKE FOUND
- = IRON ROD STAKE SET
- = CONCRETE MONUMENT FOUND
- (XXXXX) = RECORD DIMENSION
- ⊕ = FOUND CHISELED "X" ON
CONCRETE RETAINING WALL

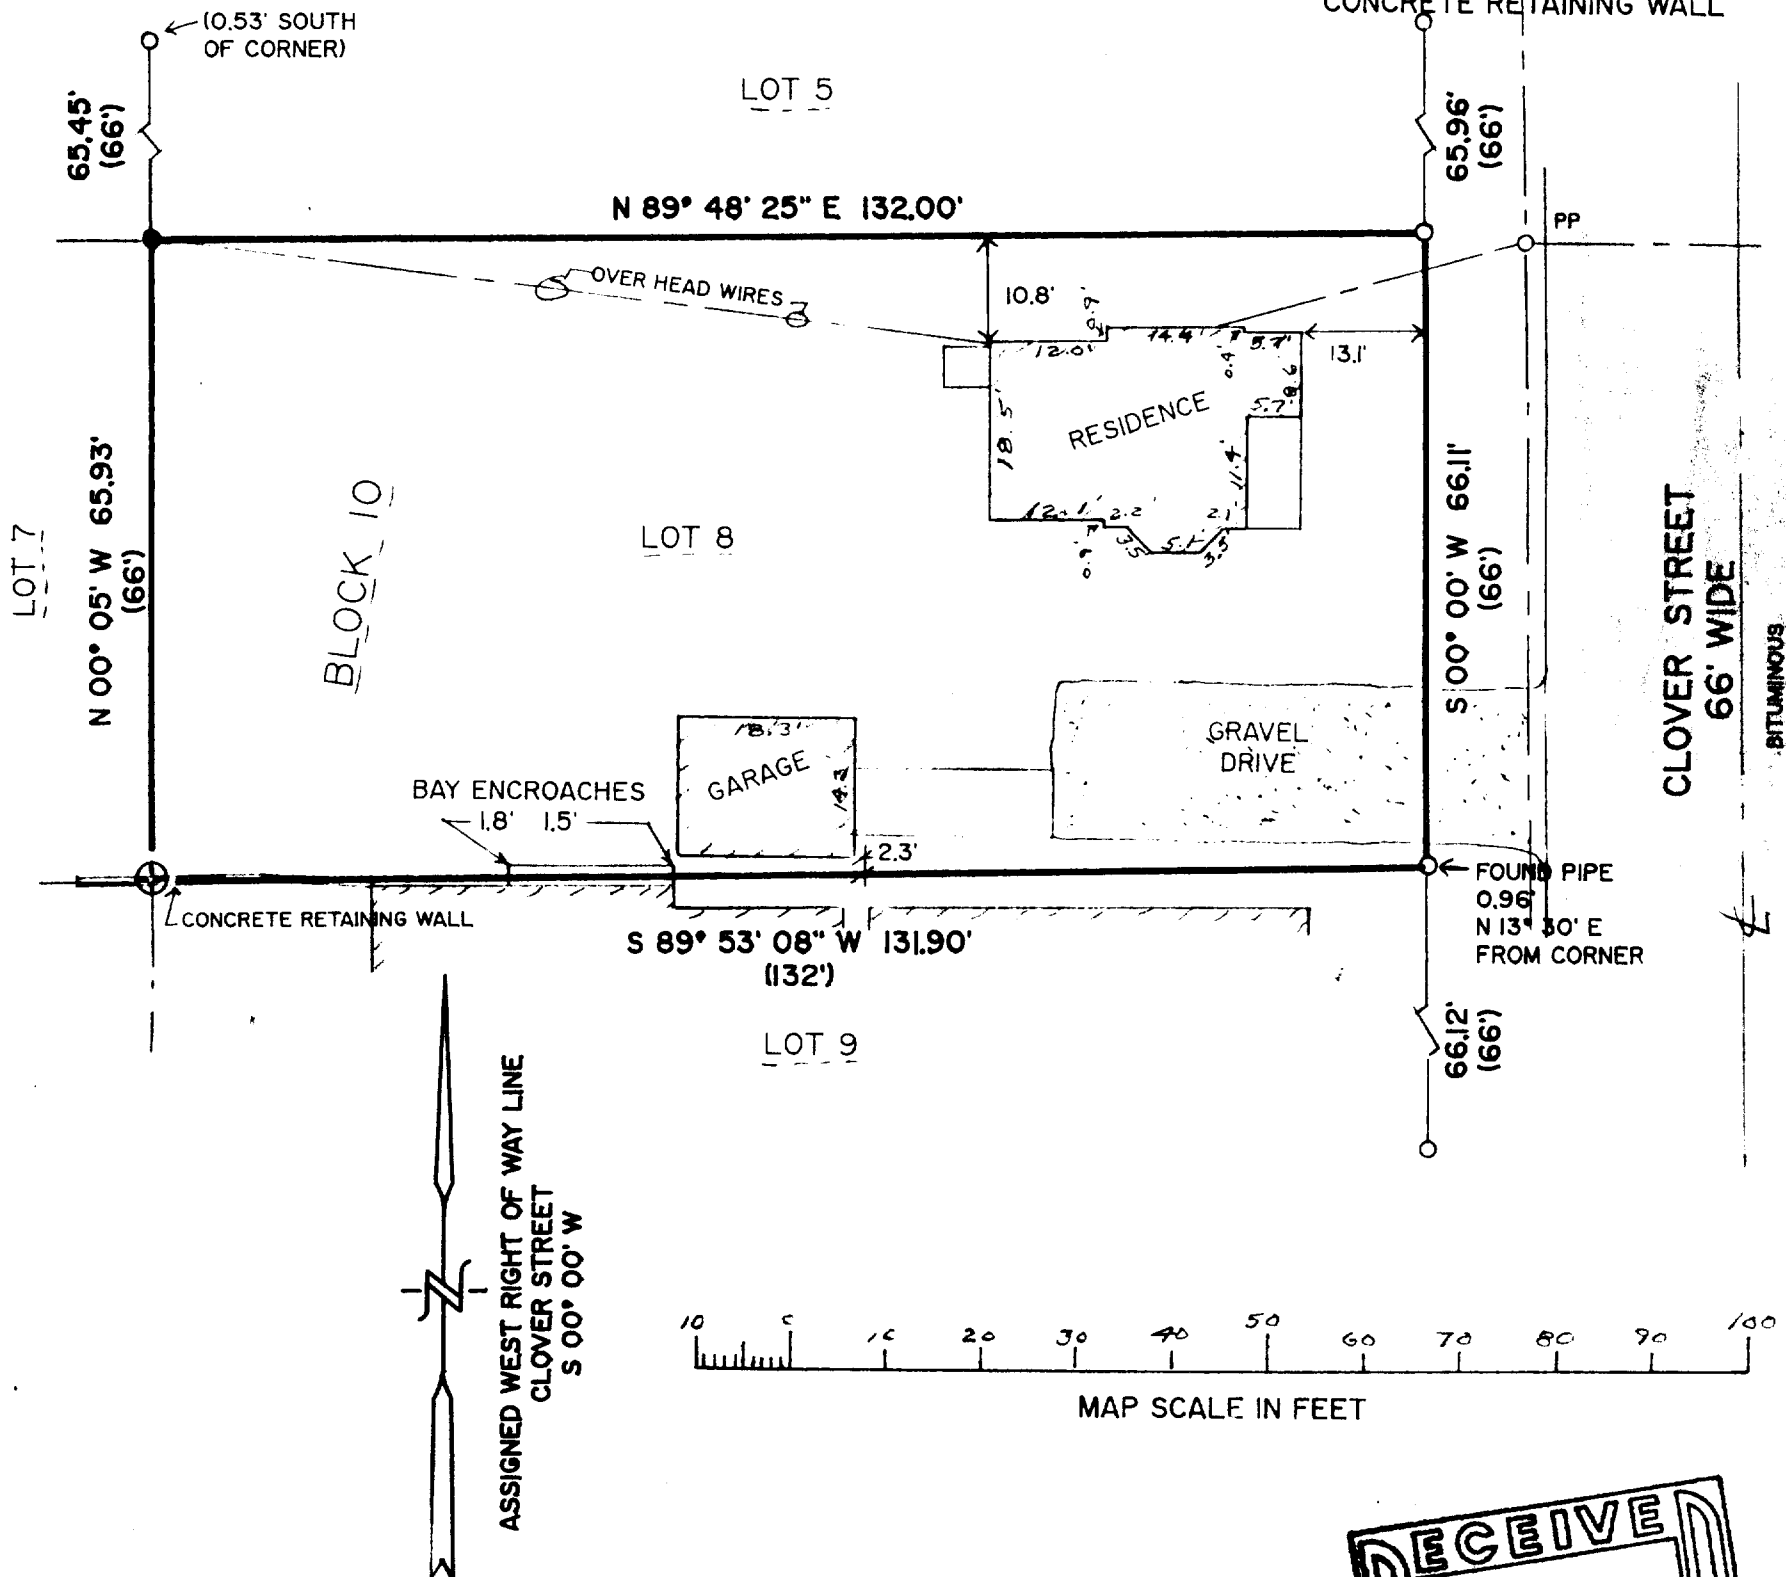


NOTE: COPIES OF THIS MAP TO WHICH THE FOLLOWING CERTIFICATE WILL
APPLY ARE BLUE LINE PRINTS SHOWING SURVEYOR'S ORIGINAL SEAL AND
SIGNATURE IN BLACK INK. COPIES BY ANY OTHER MEANS MAY HAVE
ALTERATIONS WHICH DO NOT REPRESENT THE SURVEYOR'S WORK PRODUCT.

I HEREBY CERTIFY THAT THIS PLAT OF SURVEY IS A TRUE AND ACCURATE
REPRESENTATION OF THE BOUNDARY LINES OF THE SUBJECT PARCEL TO THE
BEST OF MY KNOWLEDGE AND BELIEF. THIS SURVEY IS MADE FOR THE USE OF
THE PRESENT OWNERS OF THE PROPERTY, AND ALSO THOSE WHO PURCHASE,
MORTGAGE, OR GUARANTEE THE TITLE THERETO WITHIN ONE YEAR FROM THE
DATE HEREOF.

DATED: 05/03/1993

Peter S. Gordon
PETER S. GORDON RLS 2101

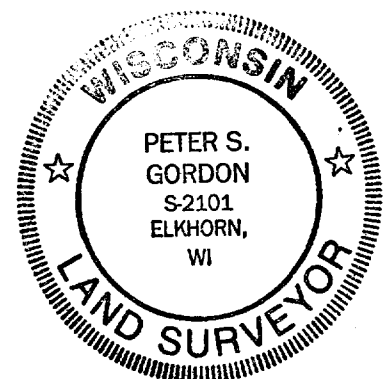

PROJECT NO. 3825

WOP-141

011-982