


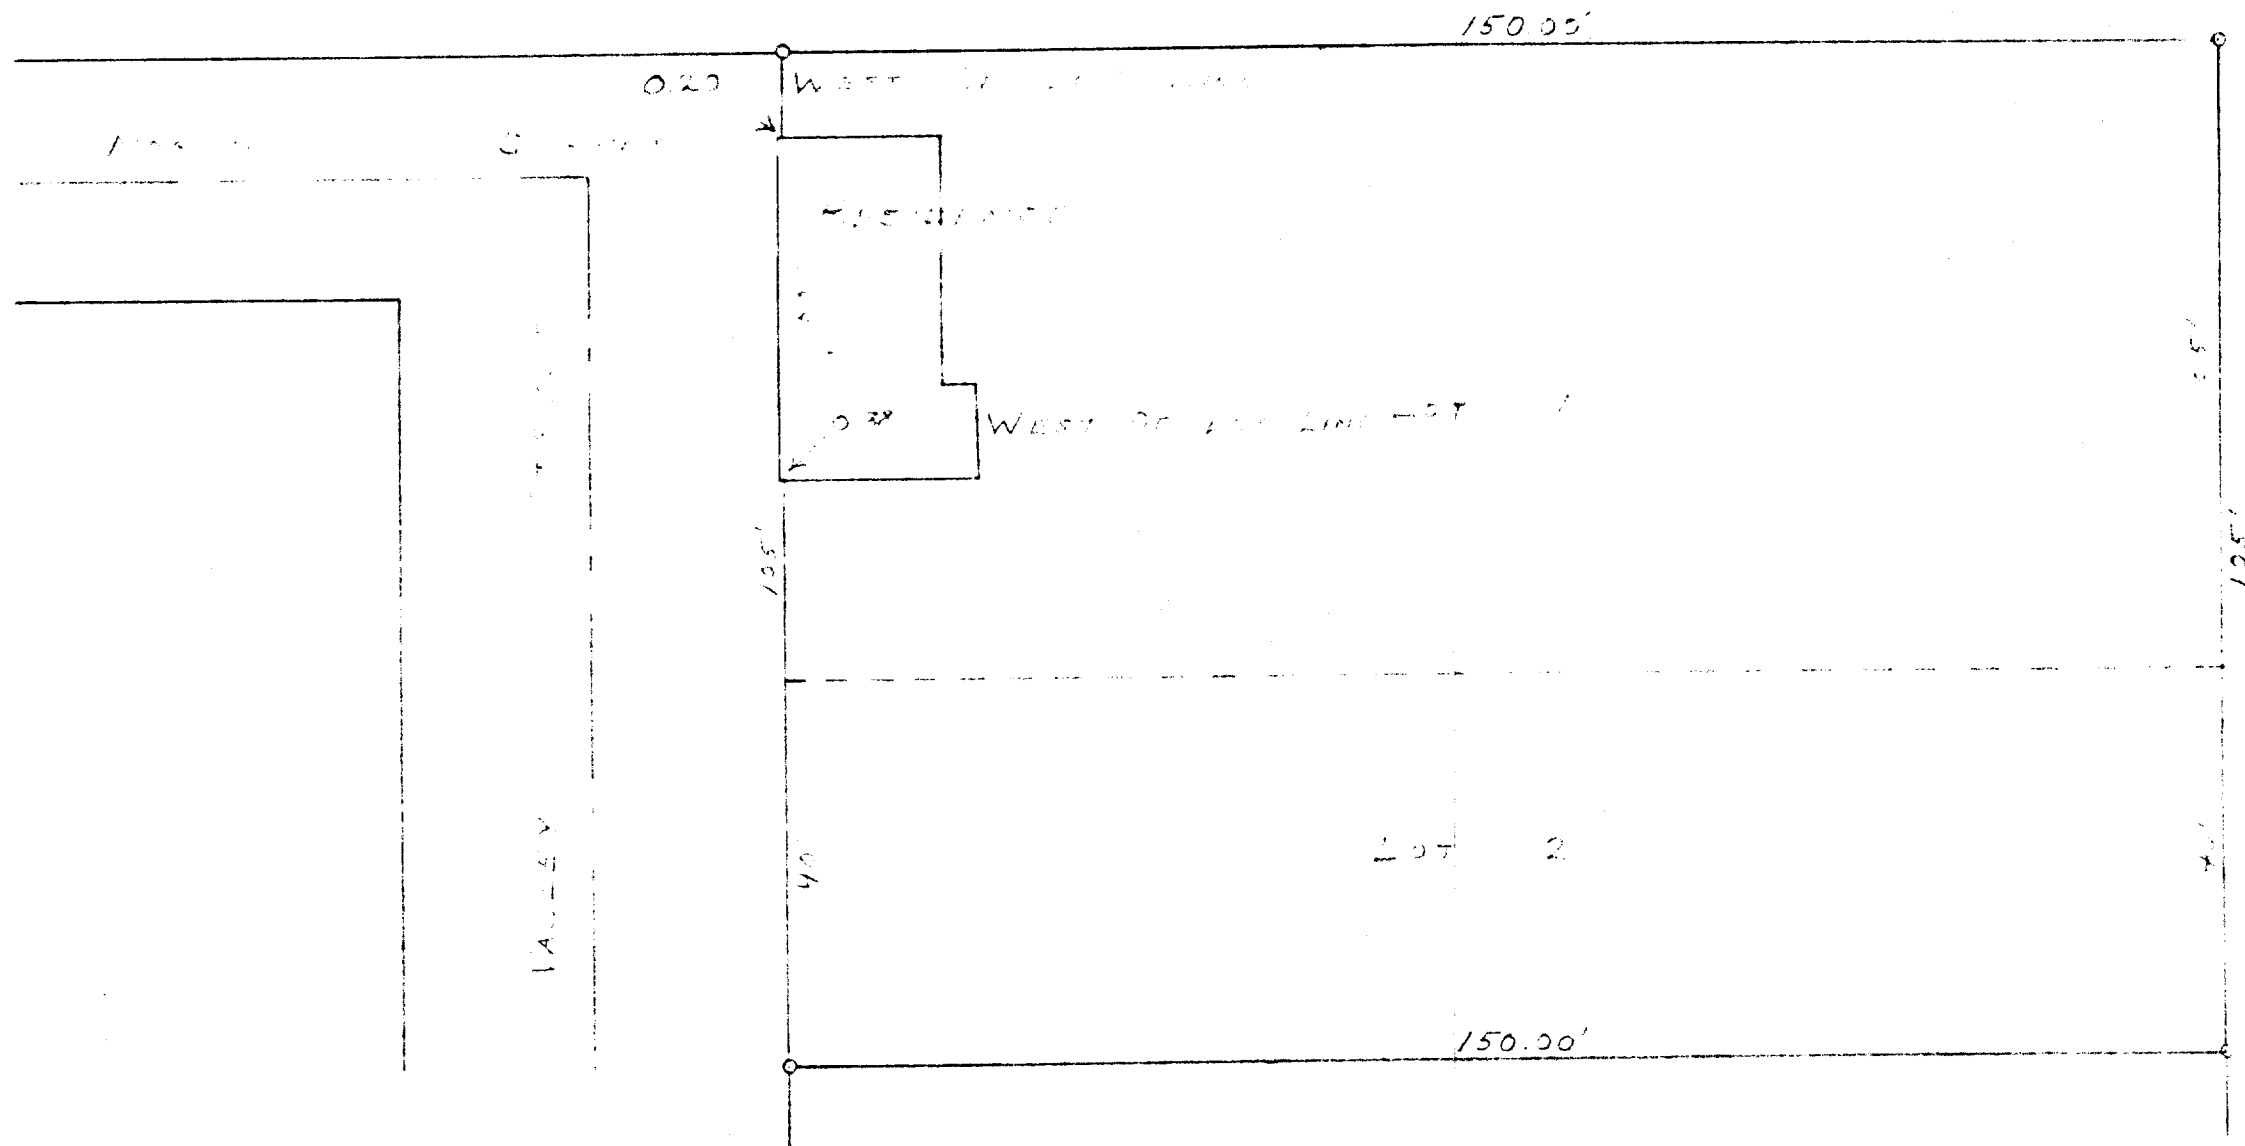

PLAT OF SURVEY OF LOTS 1 AND 2
 OF CARLSON'S ADDITION TO THE VILLAGE
 OF WILLIAMS BAY WASHBURN COUNTY, WISCONSIN
 SEPTEMBER 21, 1951

Lloyd L. Jensen
 WALWORTH COUNTY SURVEYOR

11-98J

WCA-1